


0
1
2
3

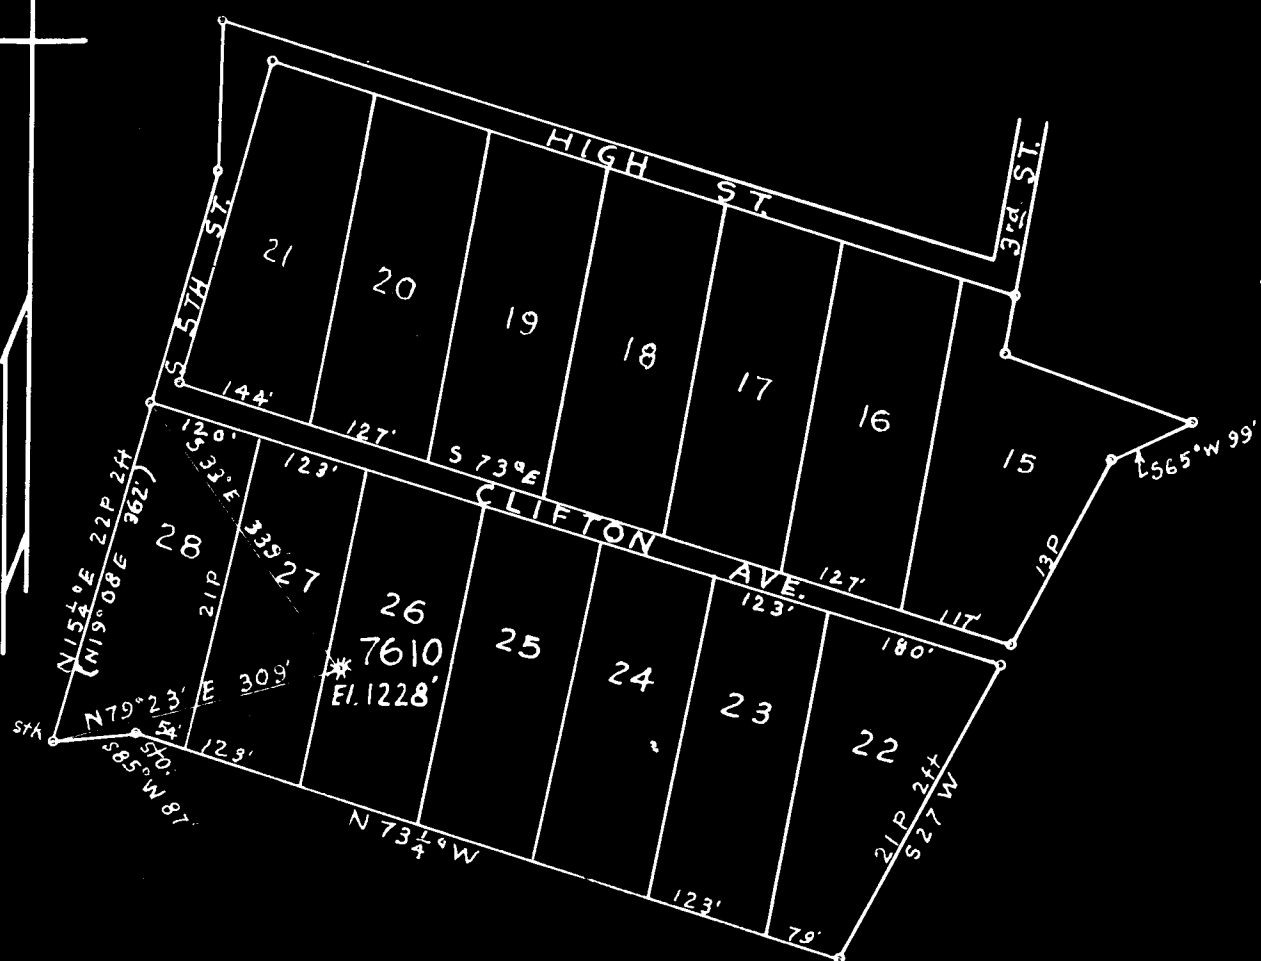

Original Layout of Lots on Lowndes Hill
D.B. 22 P 12.

405 S
0.50 W

New Location
Drill Deeper
Abandonment

Map Sh. 43 S 13 E 15 D.B. 587 P 4.

Company Hope Natural Gas Co
 Address Clarksburg, Wva.
 Farm Mary H. Moore
 Tract _____ Acres 3 Lease No A6325
 Well (Farm) No. _____ Serial No. 7610
 Elevation (Spirit Level) 1228'
 Quadrangle Clarksburg *SC*
 County Harrison District Clark
 Engineer W. M. Bowen
 Engineer's Registration No. 900
 File No. _____ Drawing No. _____
 Date 10-28-48 Scale 1" 200'

STATE OF WEST VIRGINIA
DEPARTMENT OF MINES
OIL AND GAS DIVISION
CHARLESTON

WELL LOCATION MAP
FILE NO. HAR-1275-A

+ Denotes location of well on United States Topographic Maps, scale 1 to 62,500, latitude and longitude lines being represented by border lines as shown.

- Denotes one inch spaces on border line of original tracing.



STATE OF WEST VIRGINIA
DEPARTMENT OF MINES
OIL AND GAS DIVISION

1059

WELL RECORD

Permit No. AD 1275-A Oil or Gas Well Oil (KIND)

Company Hope Natural Gas Company.
Address 445 West Main St. Clarksburg, W. Va.
Farm Mary Moore Acres 3
Location (waters) _____
Well No. 7610 Elev. 1228
District Clark County Harrison
The surface of tract is owned in fee by _____
Address _____
Mineral rights are owned by _____
Address _____
Drilling commenced _____
Drilling completed 1919
Date Shot _____ From _____ To _____
With _____
Open Flow _____ /10ths Water in _____ Inch
_____ /10ths Merc. in _____ Inch
Volume _____ Cu. Ft.
Rock Pressure _____ lbs. _____ hrs.
Oil _____ bbls., 1st 24 hrs.
Fresh water ~~XXXXXXXXXXXX~~ feet 945 feet
Salt water ~~XXXXXXXXXXXX~~ feet 1110 feet

Casing and Tubing	Used in Drilling	Left in Well	Packers
Size			
16			Kind of Packer
13			
10	<u>163</u>	<u>163</u>	Size of
8 1/2			
6 5/8	<u>1573</u>	<u>1573</u>	Depth set
5 3/16			
3	<u>3329</u>	<u>3339</u>	Perf. top
2			Perf. bottom
Liners Used			Perf. top
			Perf. bottom

CASING CEMENTED _____ SIZE _____ No. Ft. _____ Date _____
10" possibly cemented
COAL WAS ENCOUNTERED AT ? FEET ? INCHES
_____ FEET _____ INCHES FEET _____ INCHES
_____ FEET _____ INCHES FEET _____ INCHES

Formation	Color	Hard or Soft	Top	Bottom	Oil, Gas or Water	Depth Found	Remarks
Coal			<u>?</u>	<u>116</u>			
coal			<u>450</u>	<u>452</u>			
Little Dunkard			<u>520</u>	<u>555</u>			
Big Dunkard			<u>654</u>	<u>672</u>			
Gas sand			<u>760</u>	<u>860</u>			
First Salt			<u>913</u>	<u>990</u>	water	<u>945</u>	
Second Salt			<u>994</u>	<u>1076</u>			
Third Salt			<u>1090</u>	<u>1130</u>	water	<u>1110</u>	
Little Lime			<u>1520</u>	<u>1540</u>			
Pencil cave			<u>1540</u>	<u>1565</u>			
Big Lime			<u>1565</u>	<u>1631</u>			
Big Injun			<u>1631</u>	<u>1748</u>			
Fifty foot			<u>2050</u>	<u>2098</u>			
Thirty foot			<u>2134</u>	<u>2223</u>	gas	<u>2170</u>	
					gas	<u>2276</u>	
Fourth			<u>2508</u>	<u>2534</u>			
Fifth			<u>2581</u>	<u>2605</u>	gas	<u>2584</u>	
Speechley			<u>3277</u>	<u>3288</u>	gas	<u>3285</u>	
Total depth				<u>3329</u>			

137252627282930311234567
NOV 1919

