


Latitude 39° 00'

Longitude 81° 35'

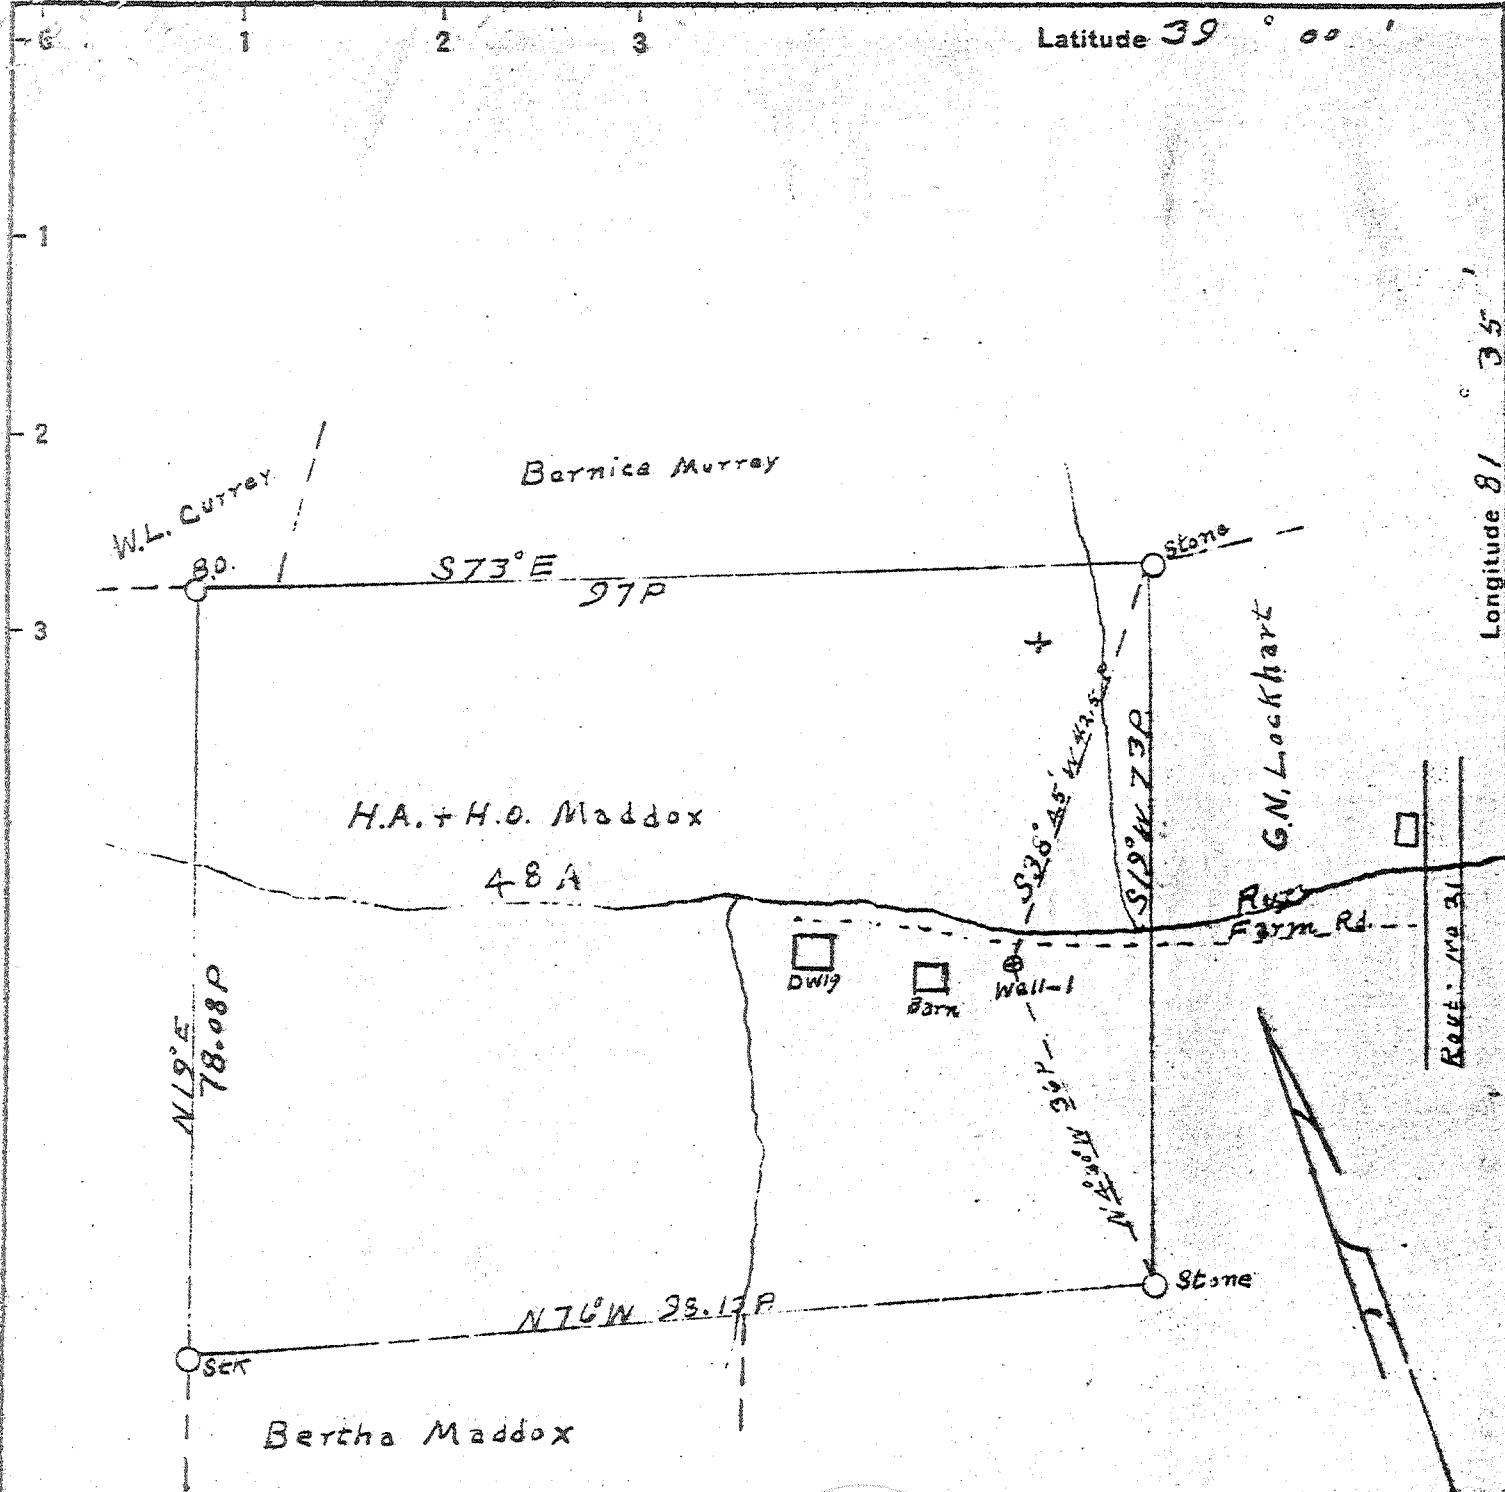

ABD
5/43

W - 2.4
S - 3.28

New Location
 Drill Deeper
 Abandonment

Company JOE RUBIN
 Address PARKERSBURG W.VA.
 Farm H.A. + H.O. MADDOX
 Tract 1 Acres 48 Lease No. _____
 Well (Farm) No. 1 Serial No. _____
 Elevation (Spirit Level) 691.53
 Quadrangle RIPLEY NC
 County JACKSON District RAVENSWOOD
 Engineer J.E. Anderson
 Engineer's Registration No. Co. Surveyor, Wood County
 File No. _____ Drawing No. _____
 Date Feb 16 19-1 Scale 1" = 20 P.C.

STATE OF WEST VIRGINIA
 DEPARTMENT OF MINES
 OIL AND GAS DIVISION
 CHARLESTON

WELL LOCATION MAP
 FILE NO. JAC-112

+ Denotes location of well on United States Topographic Maps, scale 1 to 62,500, latitude and longitude lines being represented by border lines as shown.
 - Denotes one inch spaces on border line of original tracing.

Deep Well 6-6 192

Well Record Cont'd

Permit No. Jac-112
 Company Joe Rubin, et al, Parkersburg, W. Va.
 Farm H. O. Maddox - Well No. 1
 Acres 48
 Commenced Jan. 29, 1941 - completed June 1, 1941

Shale & Shells	2309	2345
Coffee Shale	2345	2355
Berea Sand - hard	2355	2360
Lime - black	2360	2370
Slate&Shells	2370	2956
Slate	2956	3155
Shale	3155	3265
Shale - blue	3265	3300
Slate	3300	3465
Slate&Shells	3465	3595
Brown Shale-441	3595	3640
Lime	3640	3675
Lime - broken	3675	3780
Slate&Shells	3780	3800
Broken Lime & Slate	3800	3870
Brown Shale	3870	3915
Blue Shale	3915	3960
Brown Shale	3960	4025
Brown Shale & Lime	4025	4150
Shale	4150	4210
Shale, Lime&Shells	4210	4265
Slate & Shells	4265	4330
Shale	4330	4450
Shale - gray	4450	4510
Slate	4510	4555
Black Shale	4555	4570
Gray Shale	4570	4650
Brown Shale	4650	4655
Lime - hard	4655	4660
Gray Shale	4660	4690
Brown Shale	4690	4710
Black Shale	4710	4725
Lime & Shells	4725	4729
Black Slate-MARCOHU	4729	4879
Corniferous Lime-463	4879	4995½
Oriskany Sand	4995½	5001
Total Depth		5001

Show of gas

4875 4995 5001
 692 692

 4183 4303

Show 1000 Mcf in top of Oriskany
 Vol XVI

475

WEST VIRGINIA DEPARTMENT OF MINES
OIL & GAS DIVISION
W E L L R E C O R D

Permit No. Jac-112
Ripley Quad.

Gas Well

Company Joe Rubin, et al
Address 1900 - 19th St., Parkersburg, W. Va.
Farm H. O. Maddox ACRES 48
Well No. 1 ELEV. 691.53
District Ravenswood - Jackson County
Surface H. O. Maddox, Sandyville, W. Va.
Mineral Maddox Heirs, " "
Commenced Jan. 29, 1941
Completed June 1, 1941
Shot 5/29/41 - depth -
Open Flow - 73 Mcf, RP. 1400 lbs, 4 bbl oil + 1 bbl salt
Volume - water - oriskany - Vol XVI
Rock Pressure -
Water -

CASING & TUBING
14 600-7
10-1/4 793-7
7 2014-9
5-1/2 4882

Clay - red	0	20	Lime	1015	1070
Lime	20	25	White Slate	1070	1100
Red Rock	25	45	Sand	1100	1175
Lime	45	50	White Slate	1175	1185
Shale - blue	50	90	Sand	1185	1205
Rock - red	90	120	Blue Slate	1205	1225
Shale - blue	120	125	Sand	1225	1310
Rock - red	125	150	Black Shale	1310	1315
Shale - blue	150	165	White Slate	1315	1325
Rock - red	165	215	Blue Slate	1325	1335
Sand - hard	215	225	Sand	1335	1380 W 4 blrs.
Shale - blue	225	240	Slate	1380	1435
Sand	240	245	Blue Slate	1435	1440
Lime	245	280	Shale	1440	1460
Shale - pink	280	285	Sandy Lime	1460	1475
Shale	285	315	Sand	1475	1510
Shale & Shells - red	315	340	Blue Slate	1510	1515
Lime	340	360	Blue Shale	1515	1540
Rock - red	360	380	Sandy Lime	1540	1560
Lime - hard	370	385	Blue Shale	1560	1585
Rock - red	395	430	Salt Sand	1585	1590
Shale - blue	430	440	Slate	1590	1600
Pgh. Sand	440	450	Lime	1600	1610
Rock - red	450	480	Sand	1610	1725 W 1/2 full
Lime	480	500	Slate	1725	1730
Pgh. Sand	500	550	Big Lime	1730	1819
Rock - red	550	565	Sand - white - hard	1819	1840
Pgh. Sand	565	580	Slate	1840	1842
Blue Shale	580	590	Big Injun	1842	1865
Sand	590	605	Sand	1865	1870
Shale	605	610	Slate	1870	1872
Blue Shale	610	645	S.L.M. Correction	1872	1882
White Slate	645	705	Blue Slate	1882	1895
Red Rock	705	795	Water Sand	1895	1982
White Slate	795	805	Sand - hard	1982	2001
Broken Lime	805	825	Shale	2001	2006
Red Rock	825	845	Lime - black	2006	2030
Blue Slate	845	855	Shale	2030	2040
White Slate	855	890	Slate & Shells	2040	2045
Pink Shale	890	910	Broken Lime	2045	2063
Blue Shale	910	935	Broken Sand	2063	2075
Lime	935	940	Slate & Shells	2075	2090
Red Rock	940	950	Sand - hard	2090	2110
Lime	950	955	Slate Shells	2110	2150
White Slate	955	965	Lime & Shells	2150	2155
Red Rock	965	975	White Slate	2155	2200
Lime	975	995	Slate & Shells	2200	2251
Slate	995	1000	Slate	2251	2309
Blue Slate	1000	1015			

Cont'd to page #2