


Latitude 39° 00'

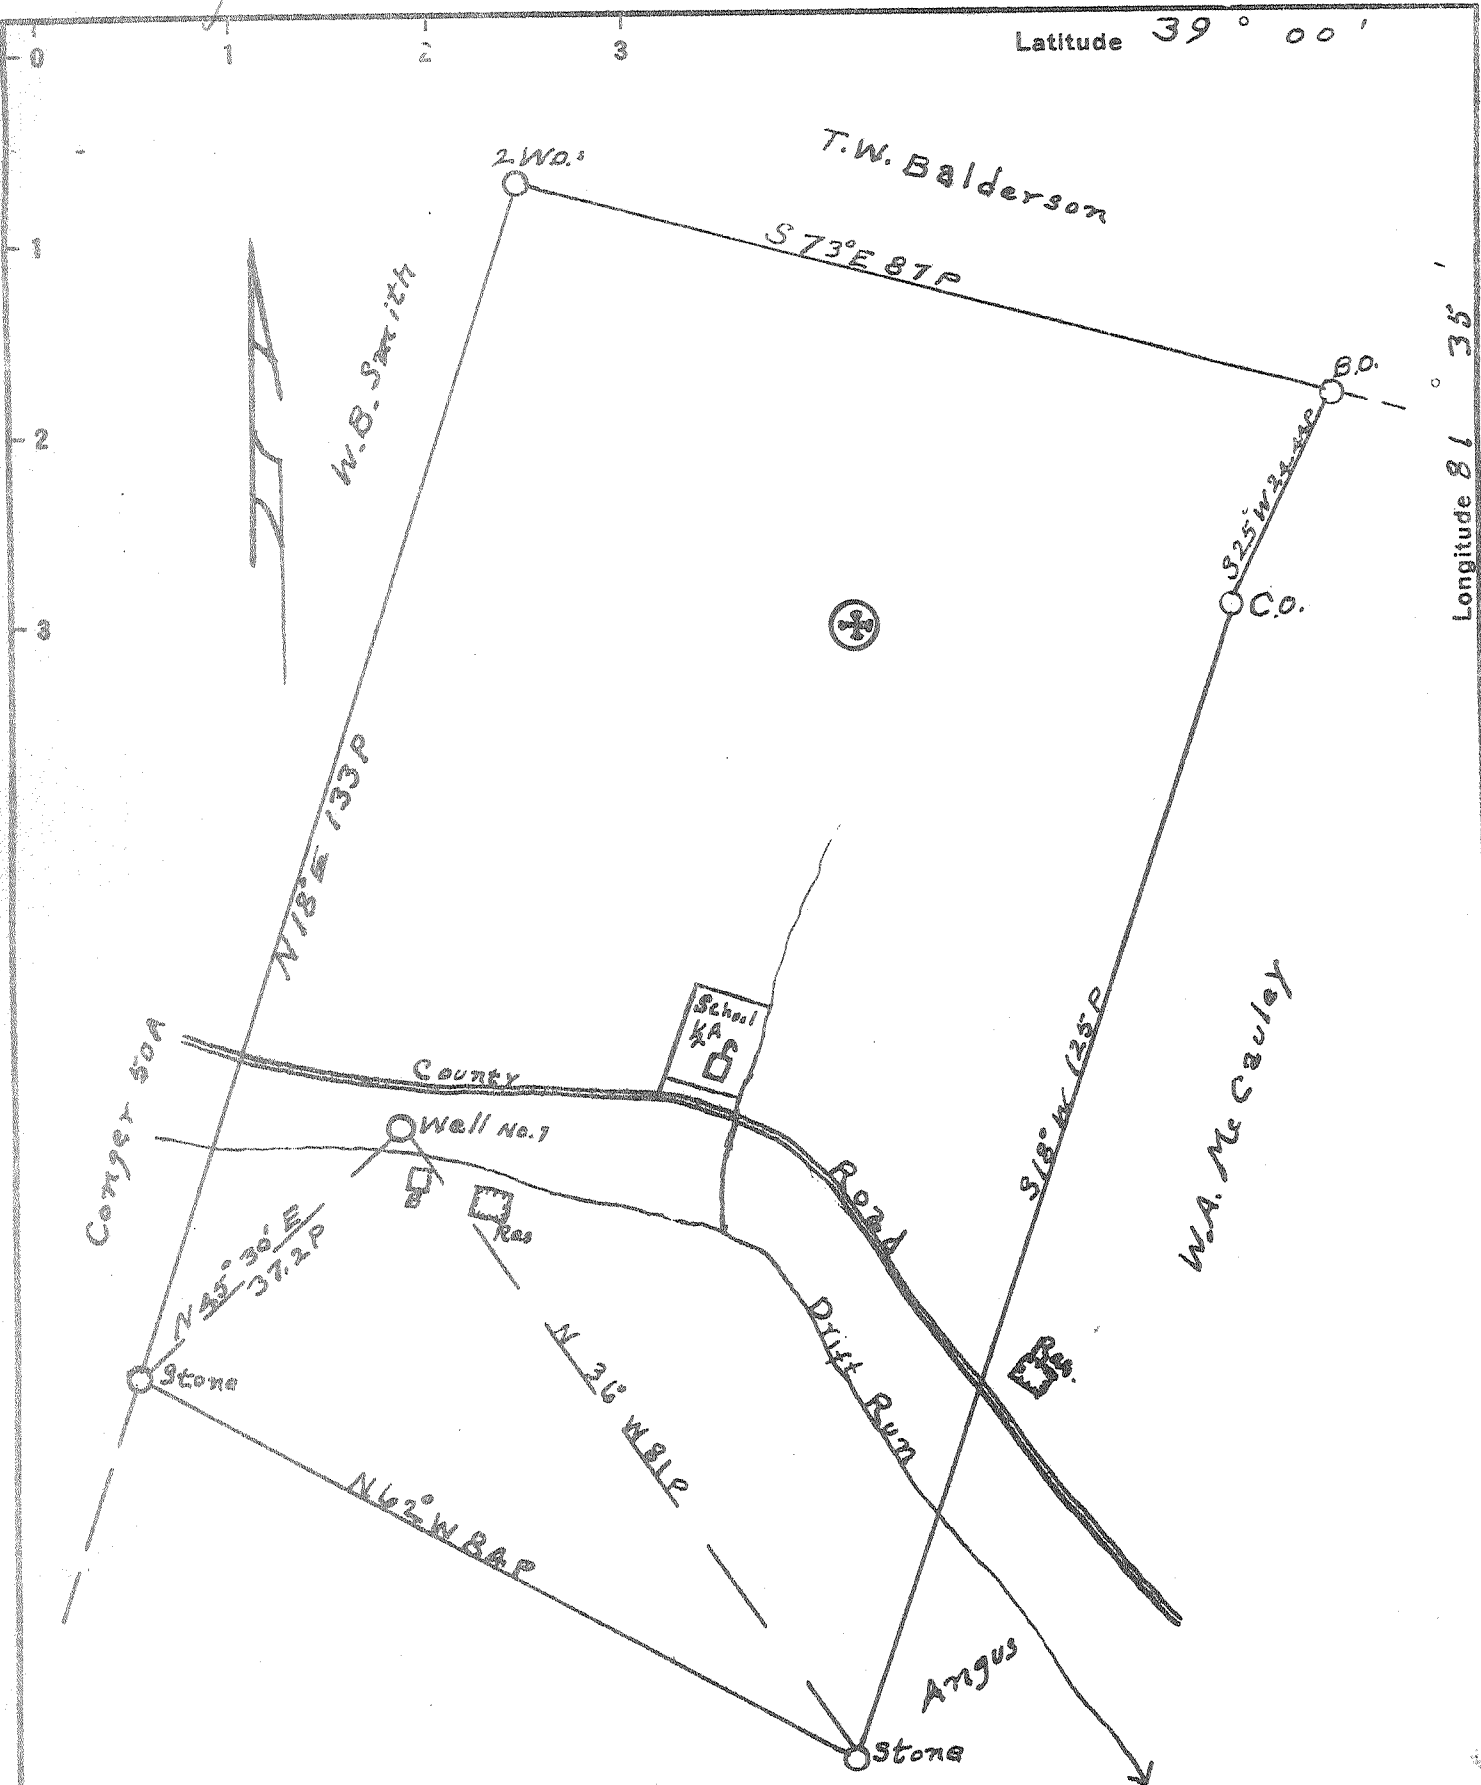

Longitude 81° 35'

New location
 Drill Deeper
 Abandonment

8-6-18-74

Five Creek Gas Company


Company Joe Rubin & Sons
 Address ~~Parkersburg, W. Va.~~ Charleston, W. Va.
 Farm W.B. Smith
 Tract 1 Acres 72.65 Lease No. _____
 Well (Farm) No. 1 Serial No. _____
 Elevation (Spirit Level) 670.65'
 Quadrangle Ripley NC
 County Jackson District Ravenswood
 Engineer J.E. Anderson
 Engineer's Registration No. County Surveyor Wood Co.
 File No. _____ Drawing No. _____
 Date March 20, 1941 Scale 1 in = 20 Feet

STATE OF WEST VIRGINIA
DEPARTMENT OF MINES
OIL AND GAS DIVISION
CHARLESTON

WELL LOCATION MAP
FILE NO. JAC-131-P

+ Denotes location of well on United States Topographic Maps, scale 1 to 62,500, latitude and longitude lines being represented by border lines as shown.

- Denotes one inch spaces on border line of original tracing.

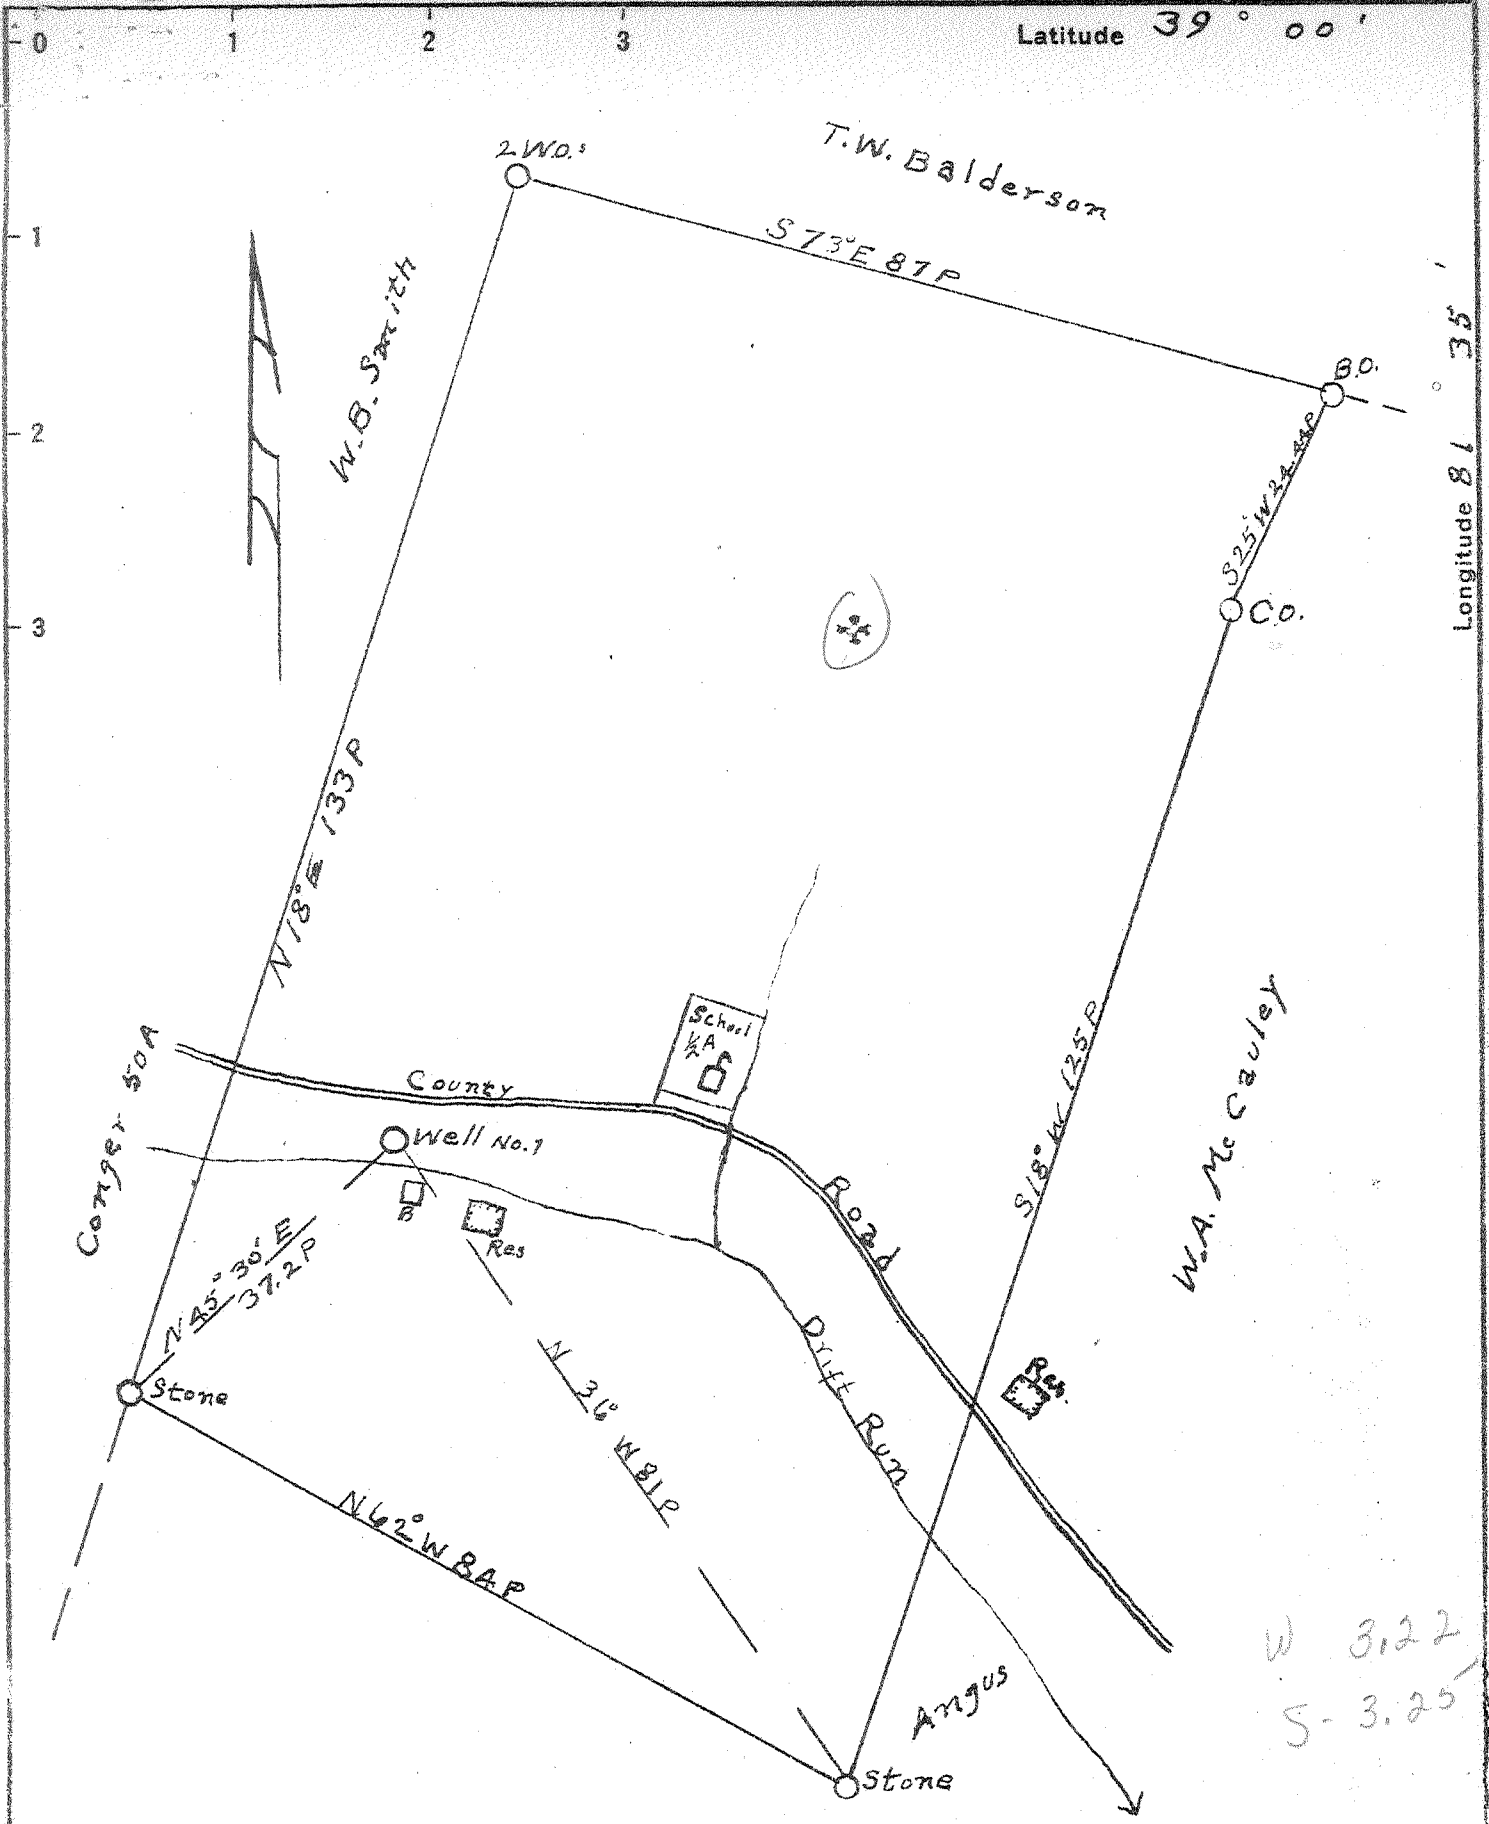

New Location
 Drill Deeper
 Abandonment

Company Joe Rubin
 Address Parkersburg, W.V.A.
 Farm W. B. Smith
 Tract 1 Acres 72.65 Lease No. _____
 Well (Farm) No. 1 Serial No. _____
 Elevation (Spirit Level) 670.45'
 Quadrangle Ripley NC
 County Jackson District Ravenswood
 Engineer J. E. Anderson
 Engineer's Registration No. County Surveyor Wood Co.
 File No. _____ Drawing No. _____
 Date March 30, 1941 Scale 1 in = 20 Poles

STATE OF WEST VIRGINIA
 DEPARTMENT OF MINES
 OIL AND GAS DIVISION
 CHARLESTON

WELL LOCATION MAP
 FILE NO. JAC-131

+ Denotes location of well on United States Topographic Maps, scale 1 to 62,500, latitude and longitude lines being represented by border lines as shown.
 - Denotes one inch spaces on border line of original tracing.

WEST VIRGINIA DEPARTMENT OF MINES
OIL & GAS DIVISION
W E L L R E C O R D

Permit No. Jac-131
Ripley Quad.

Gas Well

Company Joe Rubin, et al
Address 1900-19th St., Parkersburg, W. Va.
Farm Wick D. Smith ACRES 72.65
Location -
Well No. 1 ELEV. 666.56
District Ravenswood - Jackson County
Surface & Mineral W. B. Smith, Sandyville, W. Va.
Commenced April 9, 1941
Completed July 31, 1941
Gas - 1495 Mcf. Oil ~~1800 lbs. P.P.~~
Oil -
Water -

CASING & TUBING

18	38-5
14	622-5
10	1135-9
8-1/4	1988
6-5/8	4800
2	4936

Sand Rock	0	20	Slate	1365	1415
Red Rock	20	75	Sand	1415	1420
Sand	75	82	Slate & Lime	1420	1595
Red Rock	82	130	Sand	1595	1695 HW 1610
Slate - white	130	150	Slate	1695	1700
Slate - blue	150	170	-Big Lime	1700	1770
Sand	170	185	Sand - <i>340</i>	1770	1775
Slate	185	195	Lime	1775	1820
Red Rock	195	205	-Sand - <i>Injun</i>	1820	1905
Lime	205	211	Lime	1905	1910
Slate	211	220	Sand - <i>SQUAW</i>	1910	1945
Red Rock	220	237	Lime	1945	1970
Broken Sand	237	260	Slate	1970	1985
Sand	260	290	Lime	1985	2000
Red Rock	290	305	Slate & Lime	2000	2290
Skate	305	325	-Brown Shale	2290	2310
Lime	325	330	-Berca	2310	2312
Slate	330	340	Slate & Shells	2312	3523
Red Rock	340	365	Brown Shale - <i>441</i>	3523	3580
Shale	365	385	Slate & Shell	3580	3830
Red Rock	385	425	Brown Shale	3830	4080
Slate - white	425	448	Slate & Shells	4080	4605
Lime	448	480	-Black Shale - <i>MARCELLUS</i>	4605	4780
Slate	480	485	-Lime - <i>463</i>	4780	4884
Lime	485	495 W 502	Top Lime Steel Line	4768	4884
Sand	495	585	-Oriskany Sand		4884
Lime	585	590			
Slate	590	600			
Red Rock	600	618			
Shale Blue	618	665			
Rock	665	675			
Slate	675	685			
Rock	685	827			
Slate - blue	827	845			
Slate - black	845	865			
Rock	865	900			
Slate	900	924			
Lime	924	935			
Slate	935	960			
Lime	960	980			
Slate - white	980	990			
Slate - black	990	1010			
Red Rock	1010	1030			
Slate	1030	1048			
Sand	1048	1144 W 1095			
Slate	1144	1155			
Lime & Slate	1155	1172			
Black	1172	1190			
Lime	1190	1260 W 1285			
Sand	1260	1365			

(475)
T.D. 4935

Sample Studies