


M

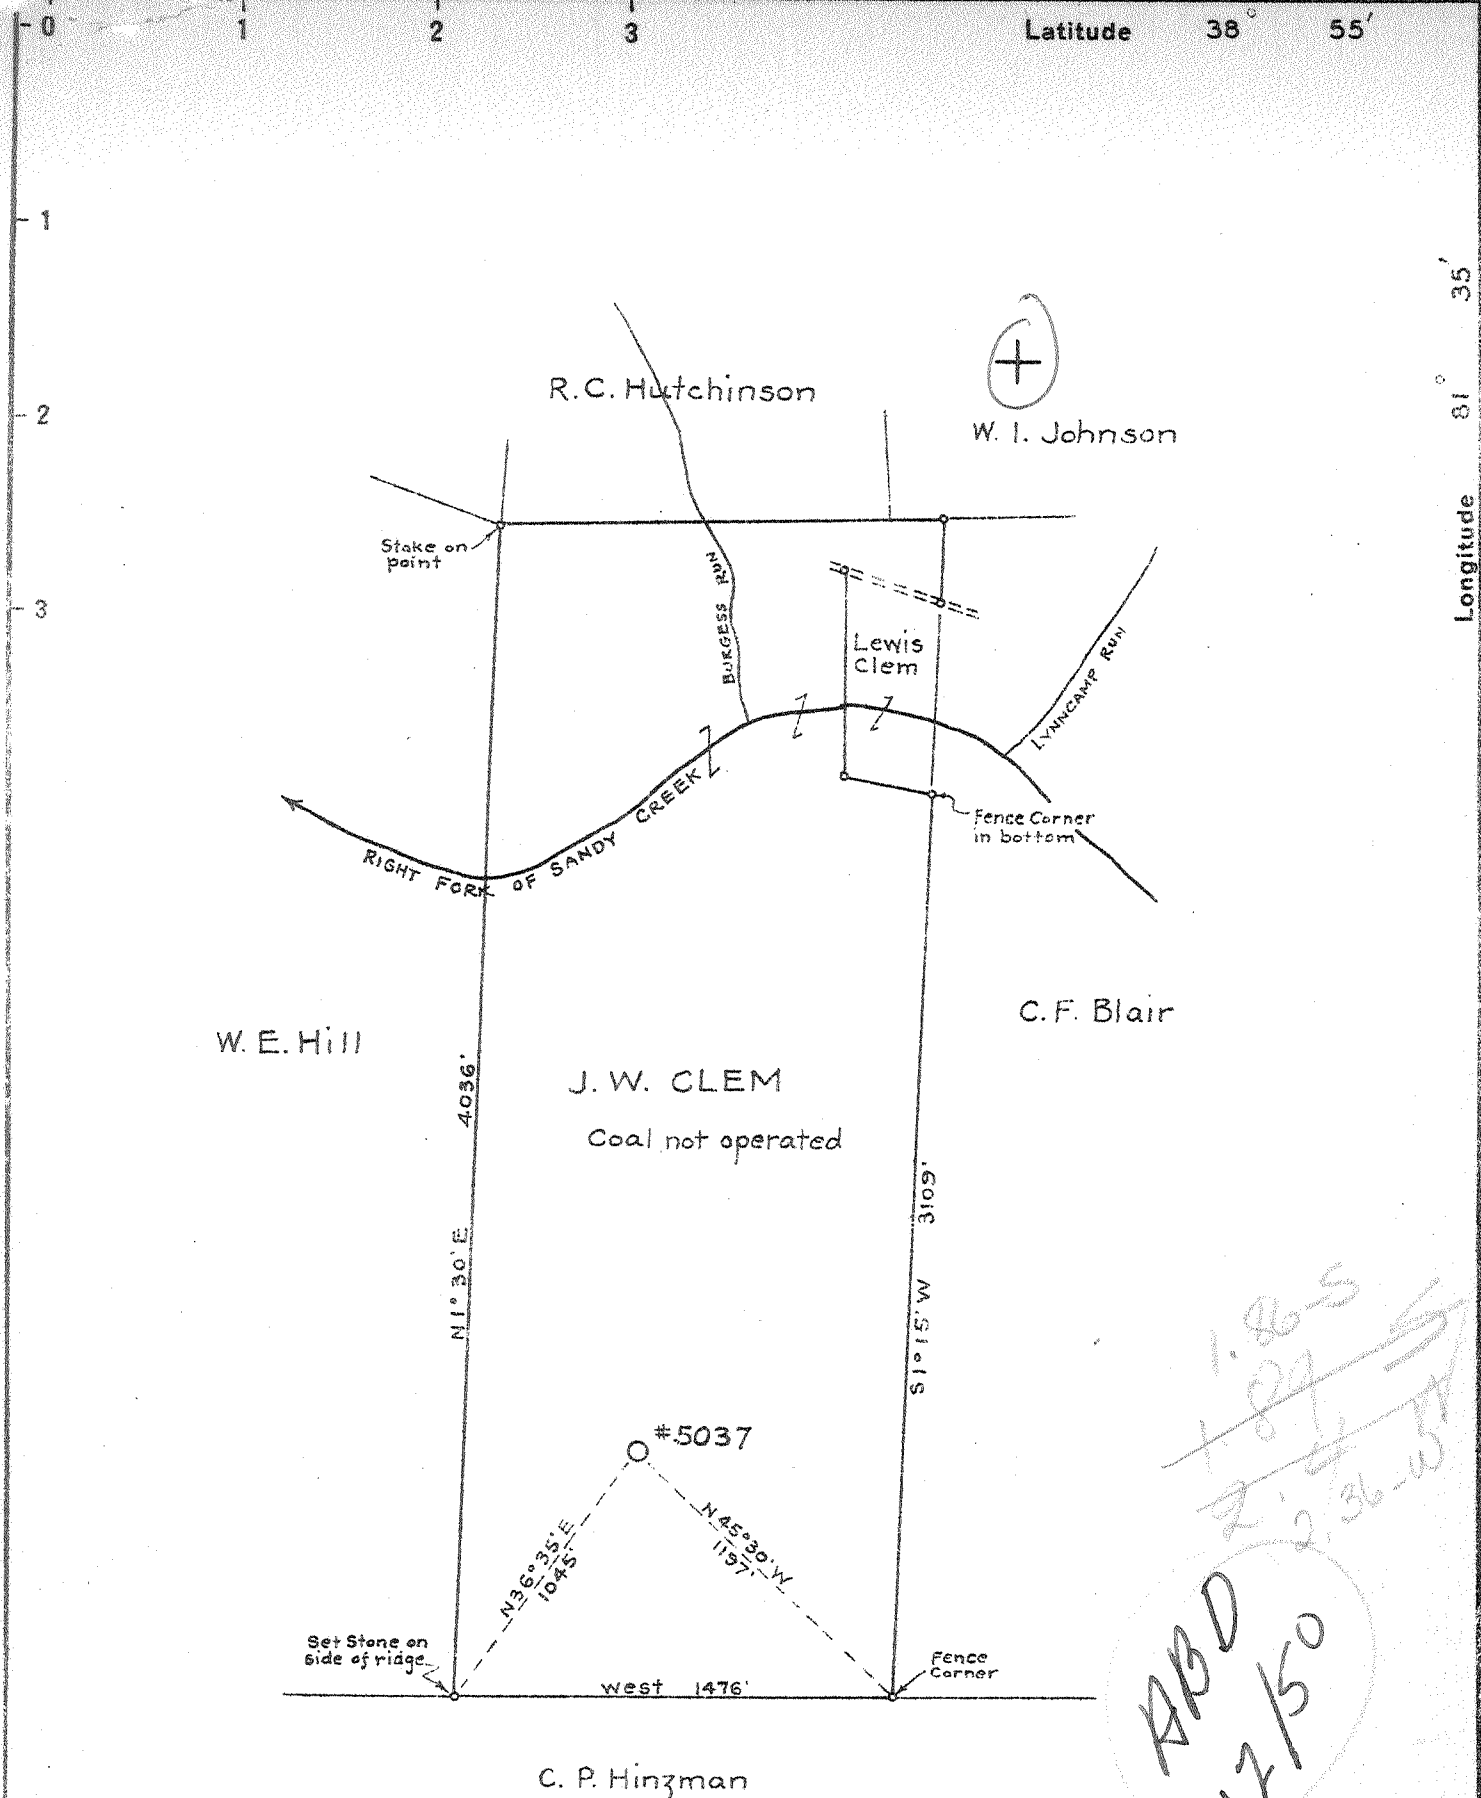

New Location
 Drill Deeper
 Abandonment

Company	UNITED FUEL GAS CO.
Address	CHARLESTON, W.VA.
Farm	J. W. CLEM
Tract	Acres 146 Lease No. 42910
Well (Farm) No.	1 Serial No. 5037
Elevation (Spirit Level)	921.5
Quadrangle	RIPLEY C
County	JACKSON District RAVENSWOOD
Engineer	G.A. Cunningham
Engineer's Registration No.	659
File No.	62-95 Drawing No.
Date	JULY 2, 1941 Scale 1" = 660'

STATE OF WEST VIRGINIA
 DEPARTMENT OF MINES
 OIL AND GAS DIVISION
 CHARLESTON

WELL LOCATION MAP
 FILE NO. JAC-175

+ Denotes location of well on United States Topographic Maps, scale 1 to 62,500, latitude and longitude lines being represented by border lines as shown.

- Denotes one inch spaces on border line of original tracing.

WEST VIRGINIA DEPARTMENT OF MINES
OIL & GAS DIVISION
W E L L R E C O R D

Permit No. Jac-175			Gas Well
Company	United Fuel Gas Co		Casing & Tubing
Address	Charleston, W.Va.		16" (Wood) 16 16
Farm	J.W. Clem Acres 146		13 3/8 790 0
Location	Rt. Fork of Sandy Creek		10 1/2 1450 0
Well No	5037 Elev. 921.5 L		8 5/8 2259'6" 2259'6"
District	Ravenswood Jackson County		7 5167 5167
Surface	J.W. Clem, Sandyville, W.Va.		2 5285 5285
Mineral	"		
Commenced	July 27, 1941		
Completed	Nov. 17, 1941		
Shot	11-18-41	Depth -60 qts.	
Volume		965 mcf - before shot - Vol. XVI	
Rock Pressure	1875 lbs.		
Fresh Water	728-785-1335		
Salt Water	1535		

Surface(Lime)	0	25	
Red Rock	25	30	
Blue Lime	80	135	
Red Rock	135	155	
Slate	155	175	
Red Rock	175	203	
Slate	203	240	
Red Rock	240	275	
Lime	275	320	
Slate	320	332	
Red Rock	332	465	
Sand	465	505	
Slate & Lime	505	610	
Red Rock	610	615	
Lime	615	670	
Red Rock	670	685	
Lime	685	728	
Pitts. Sand	728	785	Water 728-785 5 Bailers pr. hr.
Lime	785	837	
Red Rock	837	840	
Slate & Shells	840	1010	
Red Rock	1010	1042	
Gritty Lime	1042	1070	
Slate & Shells	1070	1110	
Sand	1110	1135	
Red Rock	1135	1141	
Lime	1141	1175	
Slate & Shells	1175	1280	
Sand	1280	1348	Water 1335 2 Bailer pr hr
Lime	1348	1365	
Slate & Shells	1365	1420	
Slate	1420	1442	
Sand	1442	1480	
Slate	1480	1518	
Salt Sand	1518	1600	Water Salty 1535 Hole Full
Slate	1600	1628	
Lime	1628	1718	
Sand	1718	1725	
Lime	1725	1840	
Maxon Sand	1840	1955	
Big Lime	1955	2060	
Sand	2060	2091	
Slate	2091	2093	
Lime	2093	2105	
Big Injun	2105	2190	
Lime	2190	2325	
Slate & Shells	2325	2561	Gas 2575 -Show no test
Brown Shale	2561	2573	
Borea Grit	2573	2588	
Slate & Shells	2588	4160	
Shale	4160	4409	
Slate	4409	4800	Gas 5225-5235
Shale	4800	5112	
Corniferous	5112	5219	
Oriskany Sand	5219	5271	
TOTAL DEPTH		5271	SLM

(475)