


Latitude 38 55

Longitude 81 35

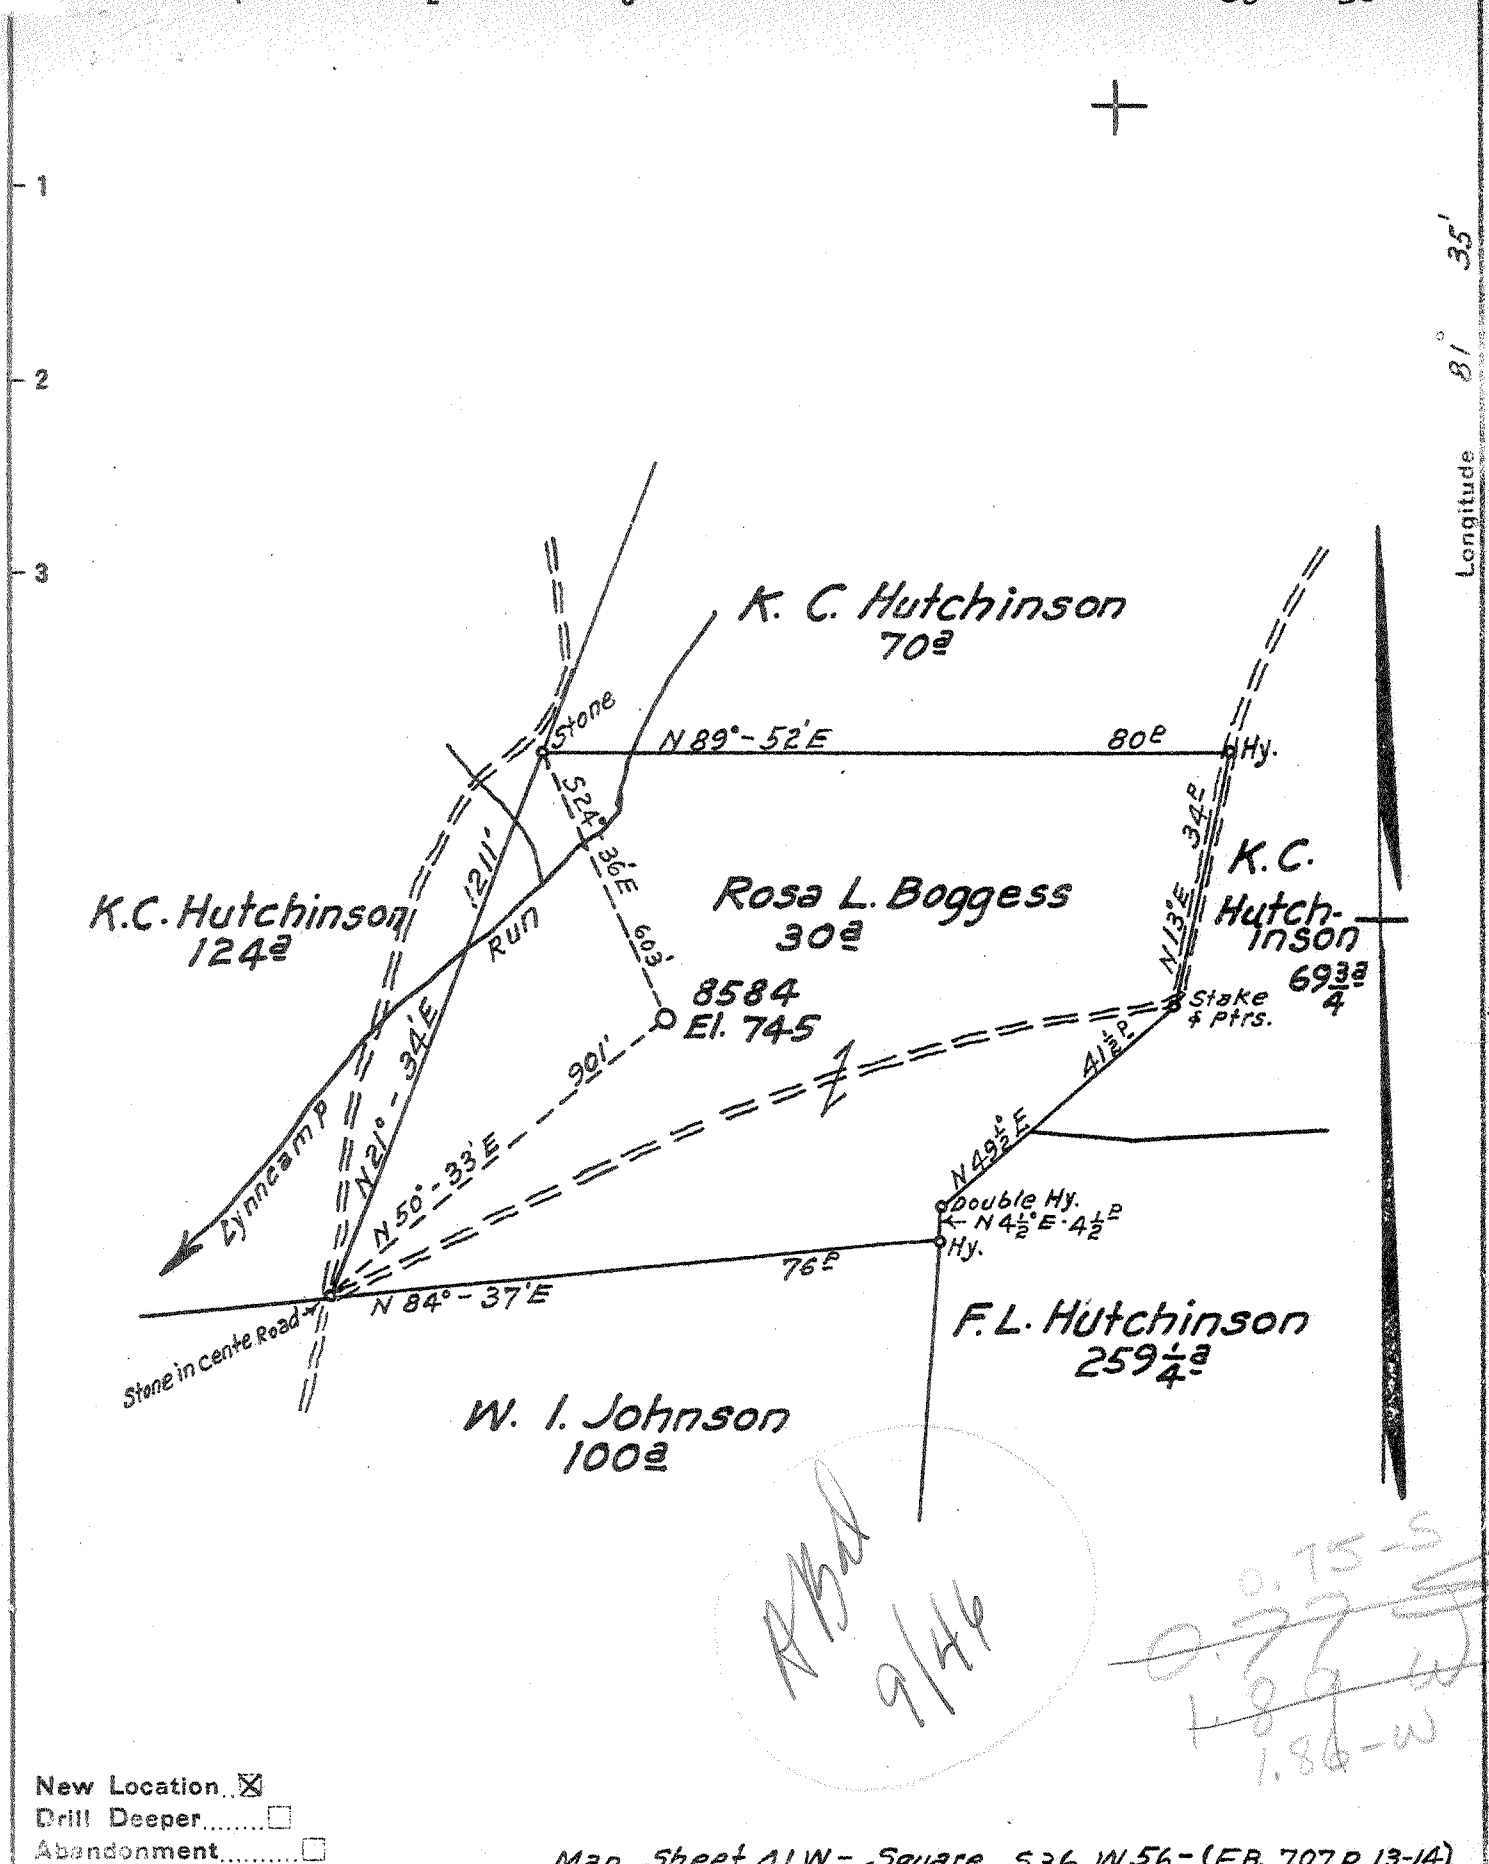

- New Location
- Drill Deeper
- Abandonment

Map Sheet 41W - Square 536 W56 - (F.B. 707 P 13-14)

Company Hope Natural Gas Co.
 Address Clarksburg, W.Va.
 Farm Rosa L. Boggess
 Tract _____ Acres 30 Lease No. 52025
 Well (Farm) No. 1 Serial No. 8534
 Elevation (Spirit Level) 745 167
 Quadrangle Ripley
 County Jackson District Ravenswood
 Engineer Wm Bower
 Engineer's Registration No. 900
 File No. _____ Drawing No. _____
 Date Aug. 8, 1941 Scale Scale 1" = 400'

STATE OF WEST VIRGINIA
 DEPARTMENT OF MINES
 OIL AND GAS DIVISION
 CHARLESTON

WELL LOCATION MAP
 FILE NO. JAC-193

+ Denotes location of well on United States Topographic Maps, scale 1 to 62,500, latitude and longitude lines being represented by border lines as shown.

- Denotes one inch spaces on border line of original tracing.

WEST VIRGINIA DEPARTMENT OF MINES
OIL & GAS DIVISION
W E L L R E C O R D

Permit No. Jac-193
Ripley Quad.
Company
Address
Farm
Well No.
District
Commenced
Completed
Flow
Volume
Rock Pressure
Fresh Water
Salt Water

Hope Natural Gas Company
Clarksburg, W. Va.
Rosa L. Bogness Acres 30
8584 Elev. 745' 7 1/2'
Ravenswood, Jackson County
~~9-9-41~~
11-20-41
15/10ths Merc in 7"
6,267,00 Cu. Ft.
1825 lbs 24.hrs.
600-610-665-674 ft.
1187-1195-1242-1780-1840 ft.

Gas Well

Casing & Tubing
16 129 129
13-3/8 716 Pulled
10-3/8 1235 1235
8-5/8 2043 2043
7" 4998 4998
Coal 1264' 72"

Surface	s	0	8	Slate	s	1072	1090
Red Rock	s	8	50	Lime	h	1090	1105
Slate	s	50	64	Slate	s	1105	1112
Red Rock	s	64	80	Lime	h	1112	1124
Pink Rock	s	80	100	Pink Rock	s	1124	1130
Sand	h	100	112	Sand	h	1130	1264W. 1187-95 1242-47
Red Rock	s	112	130	Coal	s	1264	1270
Slate	s	130	152	Sand	h	1270	1294
Red Rock	s	152	190	Slate	s	1294	1315
Slate	s	190	205	Sand	h	1315	1342
Red Rock	s	205	225	Slate&Shells	h	1342	1387
Lime	h	225	230	Sand	h	1387	1452
Red Rock	s	230	240	Slate&Shells	h	1452	1600
Slate	s	240	275	Sand	h	1600	1634
Lime	h	275	305	Slate&Shells	h	1634	1688
Slate	s	305	310	Sand	h	1688	1715
Lime	h	310	318	Slate	h	1715	1723
Red Rock	s	318	330	Lime	h	1723	1735
Slate	s	330	340	Sand	h	1735	1850W. 1780- 1840
Red Rock	s	340	355	Slate	h	1850	1871
Slate	s	355	365	Big Lime	h	1871	1972
Lime	h	365	370	Big Injun	h	1976	2020
Sand	h	370	395	Slate&Shells	h	2020	2041
Slate	s	395	407	Lime	h	2041	2075
Red Rock	s	407	415	Slate&Shells	h	2075	2412
Lime	h	415	432	Brown Shale	h	2412	2422
Red Rock	s	432	440	Berea	h	2422	2430
Slate	s	440	475	Slate&Shells	h	2430	3662
Red Rock	s	475	492	Shale	h	3662	3730
Lime	h	492	530	Slate&Shells	h	3730	3852
Red Rock	s	530	565	Brown Shale - 4.41	h	3852	3865
Lime	h	565	580	Slate&Shells	h	3865	3962
Sand	h	580	628	Brown Shale	h	3962	4085
Slate	s	628	630W. 600-10-	Slate	h	4085	4120
Sand	h	630	674 65-74	Brown Shale	h	4120	4210
Red Rock	s	674	684	Slate	h	4210	4260
Lime	h	685	690	Brown Shale	h	4260	4294
Slate	s	690	700	Slate	h	4294	4635
Lime	h	700	704	Brown Shale	h	4635	4900
Slate	s	704	716	Black Shale - MARCELLUS	h	4900	4977
Lime	h	716	725	Corniferous Lime	h	4977	5105
Slate	s	725	790	(Huntersville Chert) - 463	h	5105	5105
Pink Rock	s	790	812	Oriskany Sand	h	5105	5115
Slate	s	812	820	Gas	h	5106	5115
Sand	h	820	832	Total Depth	h		5115
Slate	s	832	846				
Lime	h	846	864				
Pink&Red Rocks	s	864	900				
Slate&Pink R.	s	900	925				
Lime	h	925	935				
Slate&Pink R.	s	935	1010				
Lime	h	1010	1016				
Pink Rock&Sl.	s	1016	1050				
Lime	h	1050	1072				

475