

WW-7
8-30-06



West Virginia Department of Environmental Protection
Office of Oil and Gas
WELL LOCATION FORM: GPS

API: 47-035-00421 WELL NO.: 2

FARM NAME: B F Rader Et Al

RESPONSIBLE PARTY NAME: Diversified Production LLC

COUNTY: Jackson DISTRICT: Ripley

QUADRANGLE: Ripley

SURFACE OWNER: Roy L Miller

ROYALTY OWNER: DP Bluegrass LLC

UTM GPS NORTHING: 4296375.42

UTM GPS EASTING: 445398.57 GPS ELEVATION: 830.61

The Responsible Party named above has chosen to submit GPS coordinates in lieu of preparing a new well location plat for a plugging permit or assigned API number on the above well. The Office of Oil and Gas will not accept GPS coordinates that do not meet the following requirements:

1. Datum: NAD 1983, Zone: 17 North, Coordinate Units: meters, Altitude: height above mean sea level (MSL) – meters.
2. Accuracy to Datum – 3.05 meters
3. Data Collection Method:

Survey grade GPS ____: Post Processed Differential ____

Real-Time Differential ____

Mapping Grade GPS X: Post Processed Differential X

Real-Time Differential ____

4. **Letter size copy of the topography map showing the well location.**

I the undersigned, hereby certify this data is correct to the best of my knowledge and belief and shows all the information required by law and the regulations issued and prescribed by the Office of Oil and Gas.

Justin Suttler

Digitally signed by Austin Suttler
Date: 2022.02.23 16:54:21
-05'00'

Sr. Proj. Manager

2/23/2022

Signature

Title

Date

03/25/2022



Diversified Gas & Oil
Corporation
100 Diversified Way
Pikeville KY, 41051



47-035-00421

Plugging Map

Legend

- Well
- Access Road
- Pits
- Pad
- Public Roads

1 Pit
10' W
20' L
8' D
285 bbl

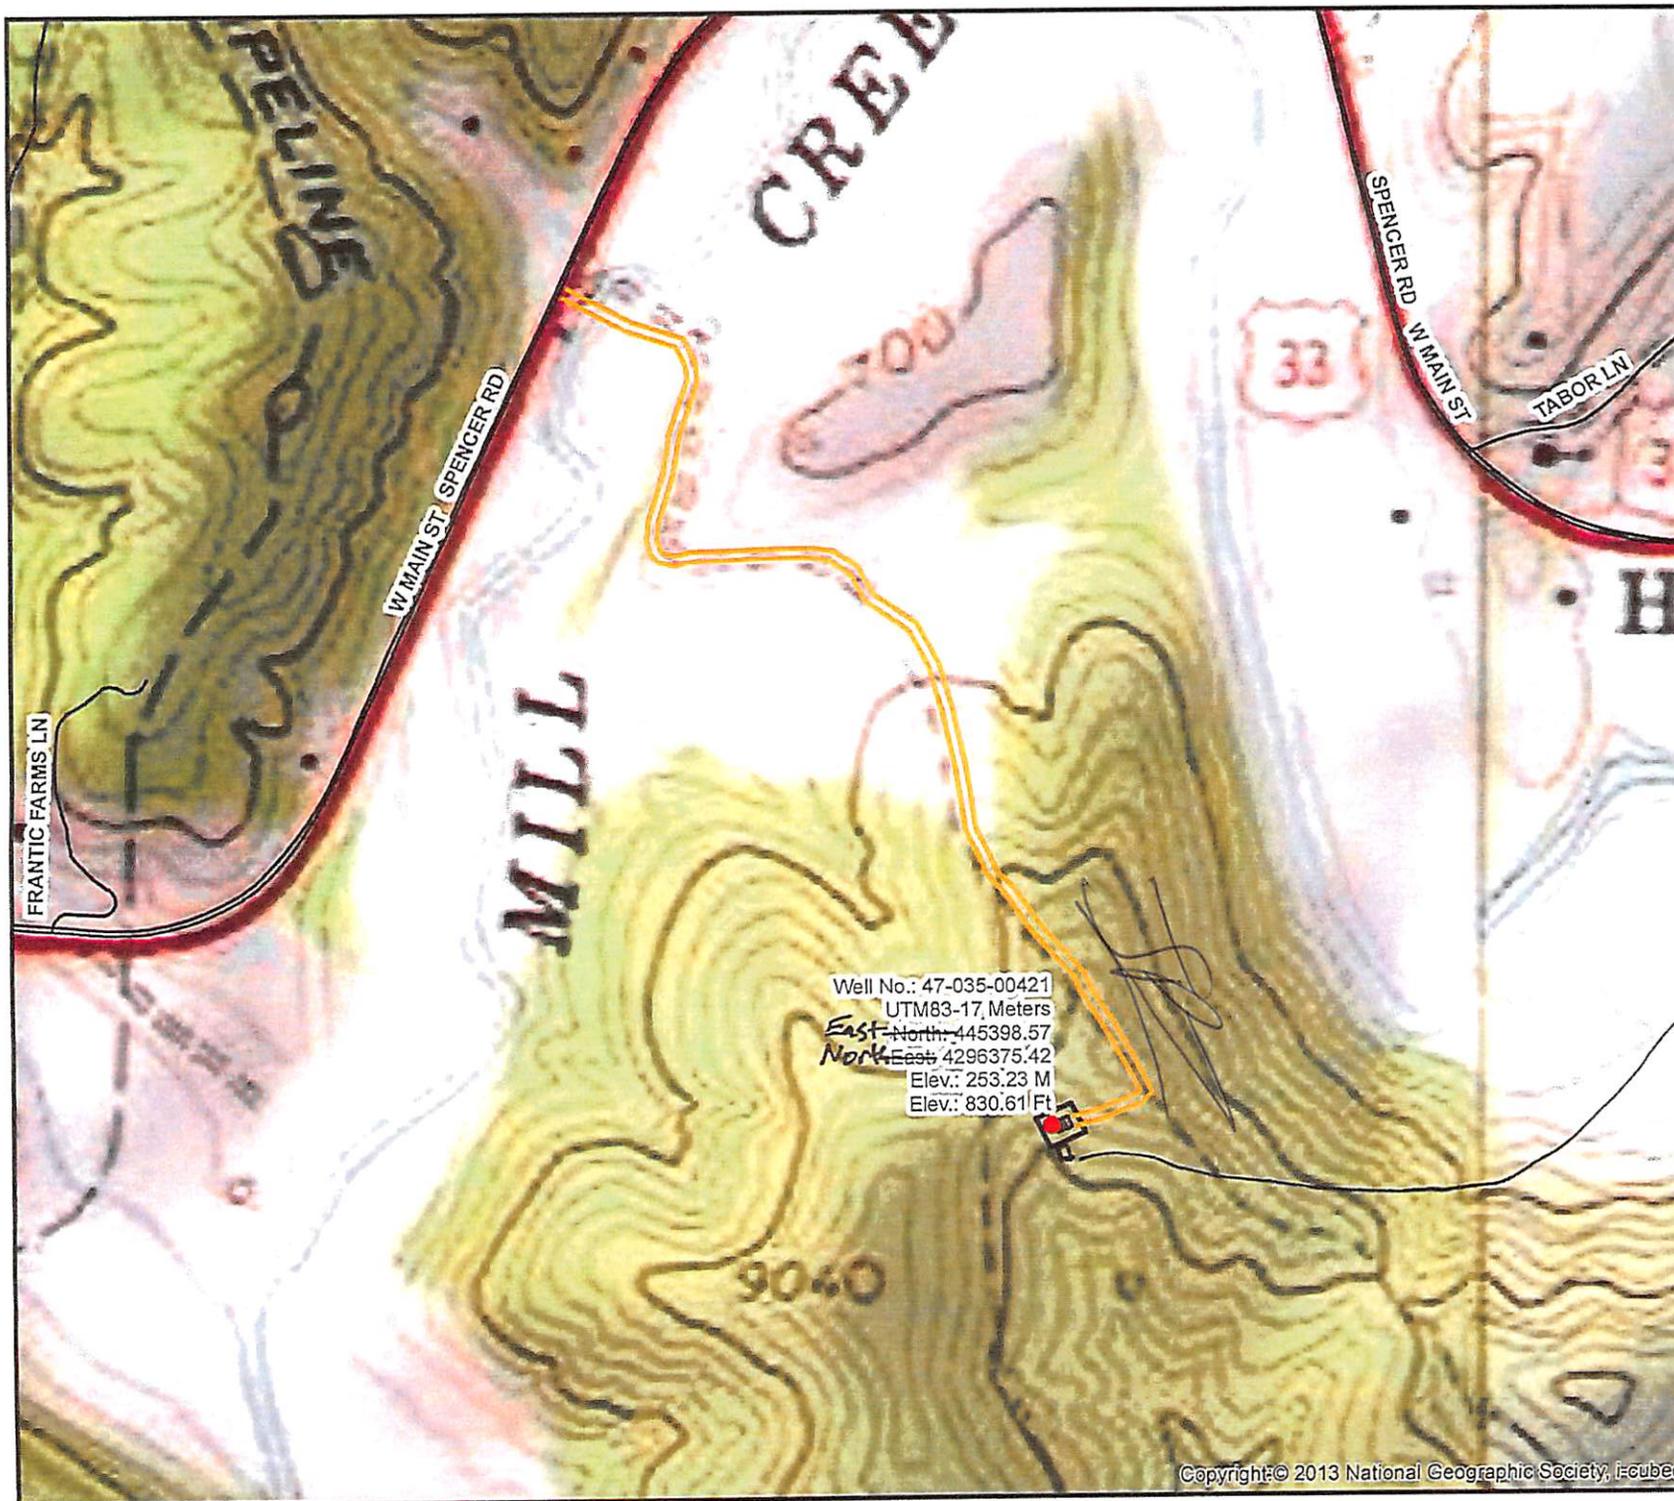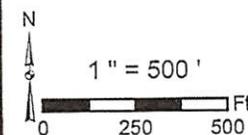

Well No.: 47-035-00421
UTM83-17, Meters
East-North: 445398.57
North-East: 4296375.42
Elev.: 253.23 M
Elev.: 830.61 Ft

4703500421