


P

Latitude 38 45'

Longitude 81 35'

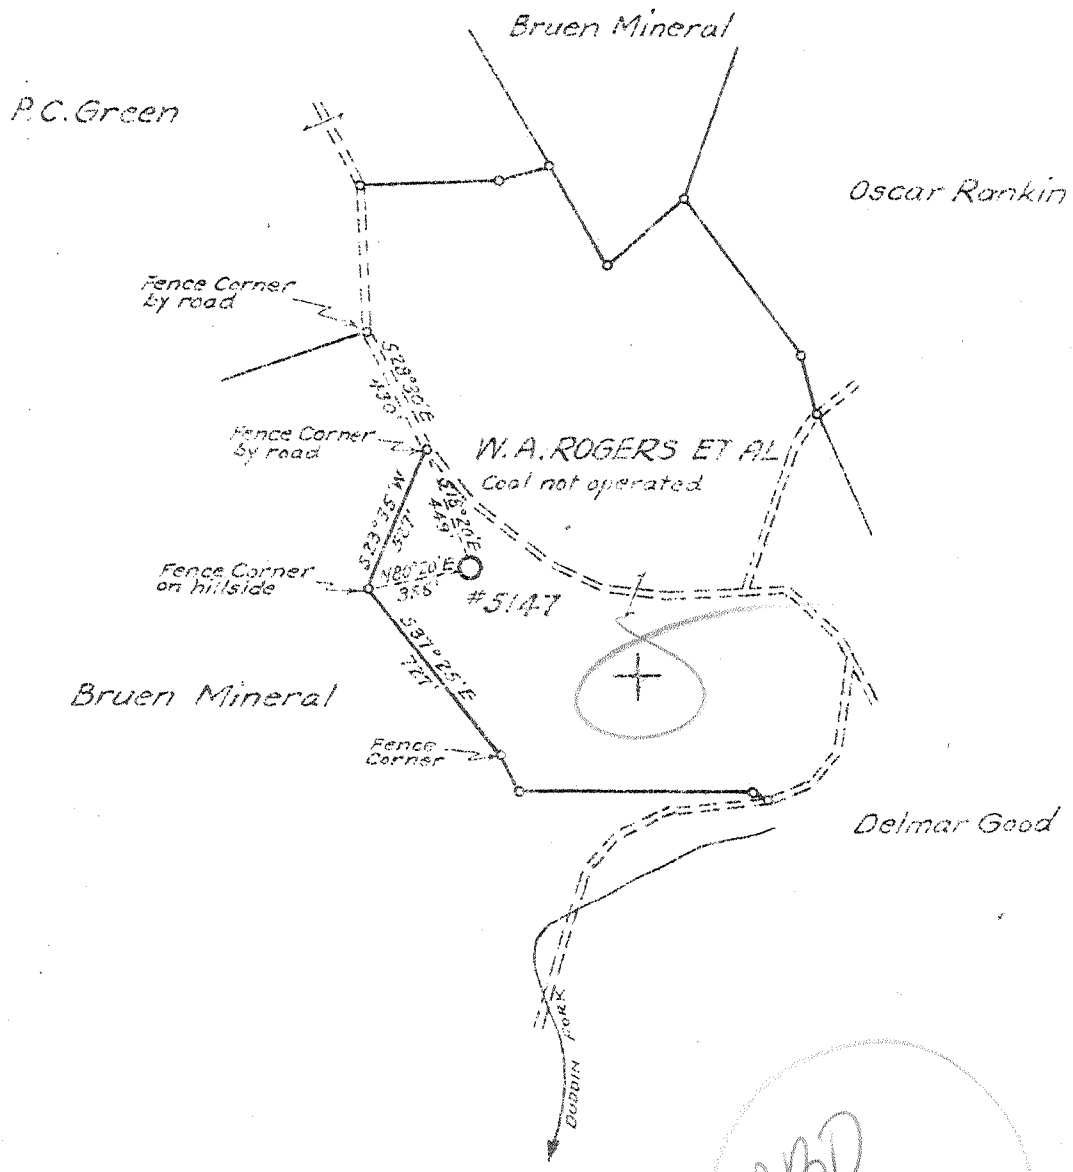

ABD
2/46

5.695
~~5.775~~
~~2.85~~
 3.80-W

New Location, X
 Drill Deeper
 Abandonment

Company UNITED FUEL GAS CO.
 Address CHARLESTON, W.VA.
 Farm W. A. ROGERS ET AL
 Tract 59 Acres Lease No. 41626
 Well (Farm) No. 1 Serial No. 5147
 Elevation (Spirit Level) 920.08
 Quadrangle KENNA - NC.
 County JACKSON District RIPLEY
 Engineer's Registration No. 659
 File No. 60-81 Drawing No. _____
 Date NOV. 16, 1942 Scale 1" = 660'

STATE OF WEST VIRGINIA
 DEPARTMENT OF MINES
 OIL AND GAS DIVISION
 CHARLESTON

WELL LOCATION MAP
 FILE NO. JAC-422

+ Denotes location of well on United States Topographic Maps, scale 1 to 62,500, latitude and longitude lines being represented by border lines as shown.

- Denotes one inch spaces on border line of original tracing.

6-6 1942 Deep well

WEST VIRGINIA DEPARTMENT OF MINES
OIL & GAS DIVISION
W E L L R E C O R D

Permit No. Jac 422

Gas Well
CASING & TUBING

Kenna Quad.				
Company	United Fuel Gas Company			
Address	Box 1273, Charleston, 1, W.Va.	13	704	Pulled
Farm	W.A. Rogers et al Acres 59.5	10	1221	1112
Location	Grass Lick Creek	8½	2196	2196
Well No	5147 Elev. 920.08	6 5/8	5137	5137
District	Ripley Jackson County	2		5275
Surface	W.A. Rogers et al, Gay, W.Va.			
Mineral	Same			
Commenced	Feb. 19, 1943			
Completed	June 13, 1943			
Date shot	6-16-43 Depth 5227 to 5258			
	with 60 qts.			
Volume	Gas Well			
Salt Water	1775			

1,686 Mcf. 2nd

Red Rock	0	140	
White Slate	140	194	
Sand	194	265	
Lime shell	265	275	
Red Rock	275	320	
Slate & Shells	320	350	
Red Rock	350	434	
Slate & Shells	434	464	
Red Rock	464	550	
Sand	550	564	
Slate & Shells	564	679	
Pittsburgh Sand	679	690	
Red Rock	690	698	
Slate	698	710	
Red Rock	710	766	
Sand	766	780	
Red Rock	780	878	
Lime	878	910	
Slate & Shells	910	960	
Red Rock	960	1046	
Sand	1046	1075	
Slate & Shells	1075	1105	
Sand - Big Dunkard - ?	1105	1210	
Slate & Shells	1210	1330	
Sand	1330	1440	
Slate & Shells	1440	1550	
Sand	1550	1660	
Slate & Shells	1660	1700	
Sand - Soft Sand ?	1700	1968	
Big Lime	1968	2099	
Big Injun	2099	2215	
Slate	2215	2565	
Berea Grit	2565	2585	
Slate	2585	3745	
Shale	3745	3905	
Slate & Shells	3905	4135	
Shale	4135	4195	
Slate & Shells	4195	4236	
Brown Shale	4236	4390	
White Slate	4390	4838	
Brown Shale	4838	4922	
White Shale	4922	4995	Gas 5228 Show
Black Shale - MARCELLUS	4995	5124	Gas 5228-5233
Corniferous Lime - 463	5124	5224	Gas 5235-5238
Criskany Sand	5224	5270	
Lime - Held	5270	5275	
TOTAL DEPTH		5275	

485