


P

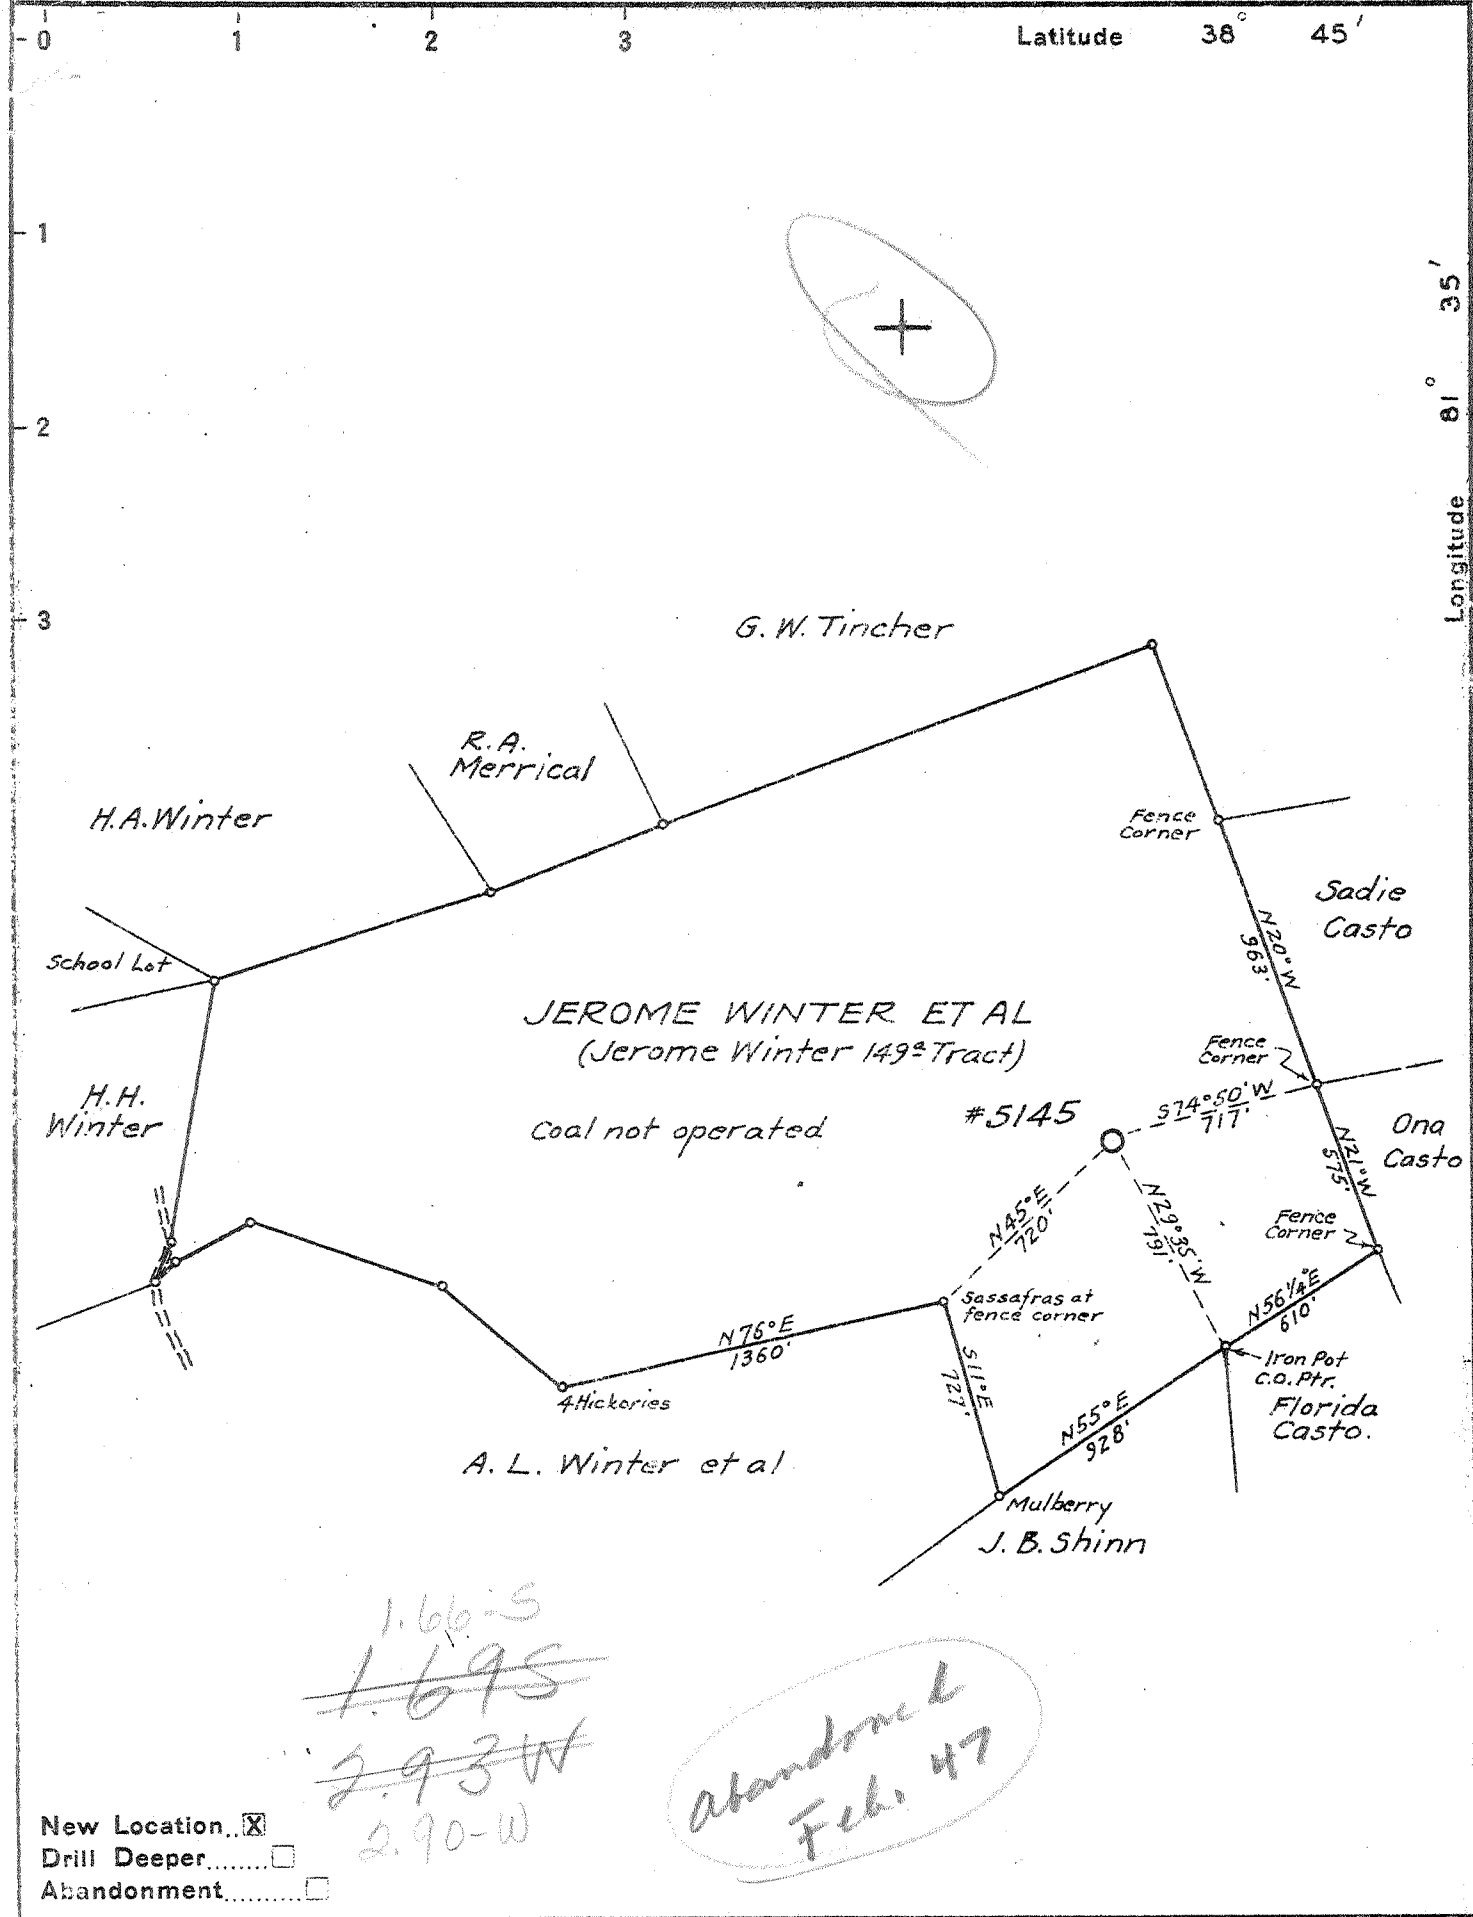

New Location
 Drill Deeper
 Abandonment

Company UNITED FUEL GAS CO.
 Address CHARLESTON, W.VA.
 Farm JEROME WINTER ETAL
 Tract _____ Acres 149 Lease No. 40810
 Well (Farm) No. 1 Serial No. 5145
 Elevation (Spirit Level) 831.74
 Quadrangle KENNA - N.C.
 County JACKSON District RIPLEY
 Engineer [Signature]
 Engineer's Registration No. 659
 File No. 60-85 Drawing No. _____
 Date MAR. 11, 1943 Scale 1" = 660'

STATE OF WEST VIRGINIA
 DEPARTMENT OF MINES
 OIL AND GAS DIVISION
 CHARLESTON

WELL LOCATION MAP

FILE NO. JAC-446

+ Denotes location of well on United States Topographic Maps, scale 1 to 62,500, latitude and longitude lines being represented by border lines as shown.

- Denotes one inch spaces on border line of original tracing.

6-6-192

Deep Well ✓

WEST VIRGINIA DEPARTMENT OF MINES
OIL & GAS DIVISION
WELL RECORD

Permit No. Jac 446
Kenna Quad.
Company
Address
Farm
Location
Well No
District
Surface
Mineral
Commenced
Completed
Not shot
Volume
Fresh Water
Salt Water

Gas Well
CASING & TUBING

United Fuel Gas Company
Charleston, W.Va. 13 675 Pld.
Jerome Winter et al A-149 10 1267 Pulled
Grass Lick Creek 8½ 2110 2110
5145 Elev. 831.74 6 5/8 5078 5078
Ripley Jackson County 2 5179
Jerome Winter et al, Fairplain, W.Va.
Same
July 24, 1943
Oct. 18, 1943
Gas Well
220° 1 BPH
1234-1246 6 BPH; 1670-1695 H.F.

5,788 McF. gas - Vol. XVI

Surface	0	18
Sand	18	45
Red Rock	45	80
Sand	80	95
Red Rock	95	120
Sand	120	138
Red Rock	138	160
Sand	160	235
Slate	235	330
Sand	330	370
Red Rock	370	390
Slate	390	425
Sand	425	535
Red Rock	535	549
Slate	548	588
Sand	588	630
Slate	630	682
Red Rock	682	715
Sand	715	735
Red Rock	735	775
Slate	775	814
Lime	814	864
Sand	864	940
Slate	940	1070
Sand	1070	1246
Coal	1246	1253
Slate	1253	1290
Sand	1290	1335
Slate	1135	1650
Salt Sand	1650	1800
Big Lime	1800	2000
Big Injun	2000	2094
Slate & Shells	2094	2458
Brown Shale	2458	2468
Berea Shells	2468	2480
Slate & Shells	2480	3645
Brown Shale - 441	3645	3693
Slate & Shells	3693	3985
Brown Shale	3985	4300
White Slate	4300	4700
Brown Shale	4700	4840
White Slate	4840	4875
Brown Shale	4875	5063
Corniferous Lime - 463	5063	5167
Oriskany Sand	5167	5179
TOTAL DEPTH	5179	5179

*5063
832
4231*

(475)

Gas 5169-5178 Pay