

STATE OF WEST VIRGINIA
DEPARTMENT OF ENVIRONMENTAL PROTECTION
OFFICE OF OIL AND GAS

AFFIDAVIT OF PLUGGING AND FILLING WELL

AFFIDAVIT SHOULD BE IN TRIPLICATE, one copy mailed to the Department, one copy to be retained by the Well Operator and the third copy (and extra copies if required) should be mailed to each coal operator at their respective addresses.

Farm name: Coast, C.M., etal Operator Well No.: Ripley 7296

LOCATION: Elevation: 618' Quadrangle: Sandyville WV
District: Ravenswood County: Jackson
Latitude: 38.895055 Feet South of 38 Deg. 53 Min. 42.35 Sec.
Longitude: -81.693335 Feet West of -81 Deg. 41 Min. 36.35 Sec.

Well Type: OIL _____ GAS X

Company Columbia Gas Transmission, LLC Coal Operator Not operated.
1700 MacCorkle Avenue S.E., P.O. Box 1273 or Owner _____
Charleston, WV 25325 _____
Agent James Amos Coal Operator _____
Permit Issued Date 05/13/2021 or Owner _____

AFFIDAVIT

STATE OF WEST VIRGINIA,
County of Jackson ss:

James Amos and Steve Simmons being first duly sworn according to law depose and say that they are experienced in the work of plugging and filling oil and gas wells and were employed by the above named well operator, and participated in the work of plugging and filling the above well say that said work was commenced on the 6th day of October, 2021, and the well was plugged and filled in the following manner:

TYPE	FROM	TO	PIPE REMOVED	LEFT
15.6ppg Class A Cement	4777'	4672'	N/A	4-1/2"
4-1/2" wall anchor packer	4672'	4672'	N/A	4-1/2"
15.6ppg Class A Cement	4672'	4651'	N/A	4-1/2"
15.6ppg Class A Cement	4651'	3987'	N/A	4-1/2", 7"
Mechanical Bridge plug	3987'	3987'	N/A	4-1/2", 7"
15.6ppg Class A Cement	3987'	1960'	N/A	4-1/2", 7"
15.6ppg Class A Cement	1960'	880'	N/A	4-1/2", 7", 8-5/8"

See additional plugging data.

Description of monument: 7" casing, 48" above ground level, API number affixed and that the work of plugging and filling said well was completed on the 21st day of October, 2021.

And further deponents saith not.

James Amos
Steve Simmons



Sworn and subscribe before me this 11th day of November, 2021

My commission expires: 6/19/2022

Michael D. McClung
Notary Public

DEC 21 2021

WV Department of Environmental Protection

Affidavit reviewed by the Office of Oil and Gas: [Signature]

Title: 12-20-21 12/31/2021

OOG Inspector

~ not to scale ~

Ripley 7296
Prior to P&A
(as of 10/29/2020)

CBL indicates there is cement from packer to top logged interval at 500'. Very possible that 4-1/2" is cemented at/near surface.

Sea Level @ 617 ft.

*Salt water reported at 1199'.

- Salt Sand 1519'-1630'
- Little Lime 1646'-1660'
- Greenbrier 1665'-1790'
- Big Injun 1790'-2241'
- Coffee 2241'-2265'
(show gas @ 2258' and 2264')
- Berea 2265'-2280'

13-3/8" csg @ 768'
(no record of cement)

12-1/4" hole @ 1028'

8-5/8" csg @ 1960'
1945 WV Dept. of Mines Well Record indicates 8-5/8" cemented but no record of volume. Old 1954 recondition work order states that scope is to "cement between all strings of casing", but no records to verify actual work performed.

Hashed fill indicates possible cement installed during well recondition in 1954.

Light grey indicates cement that was likely installed during 1954 well recondition.

[Handwritten signature]
12-20-21

RECEIVED
Office of Oil and Gas

DEC 21 2021

WV Department of
Environmental Protection


7" csg @ 4651'.
1945 WV Dept. of Mines Well Record indicates 7" cemented but no record of volume. Old 1954 recondition work order states that scope is to "cement between all strings of casing", but no records to verify actual work performed.

- Onondaga 4646'-4743'
- Oriskany 4743'-4775'
(gas storage)

4-1/2" 12.6# J-55 tubing ran to 4777' set a wall & anchor packer at 4672' w/ uncemented slotted tailpipe. Old 1954 recondition work order states that scope is to "cement between all strings of casing", but no records to verify actual work performed. CBL shows cement from packer to top logged interval of 500'.

TD 4777'

12/31/2021

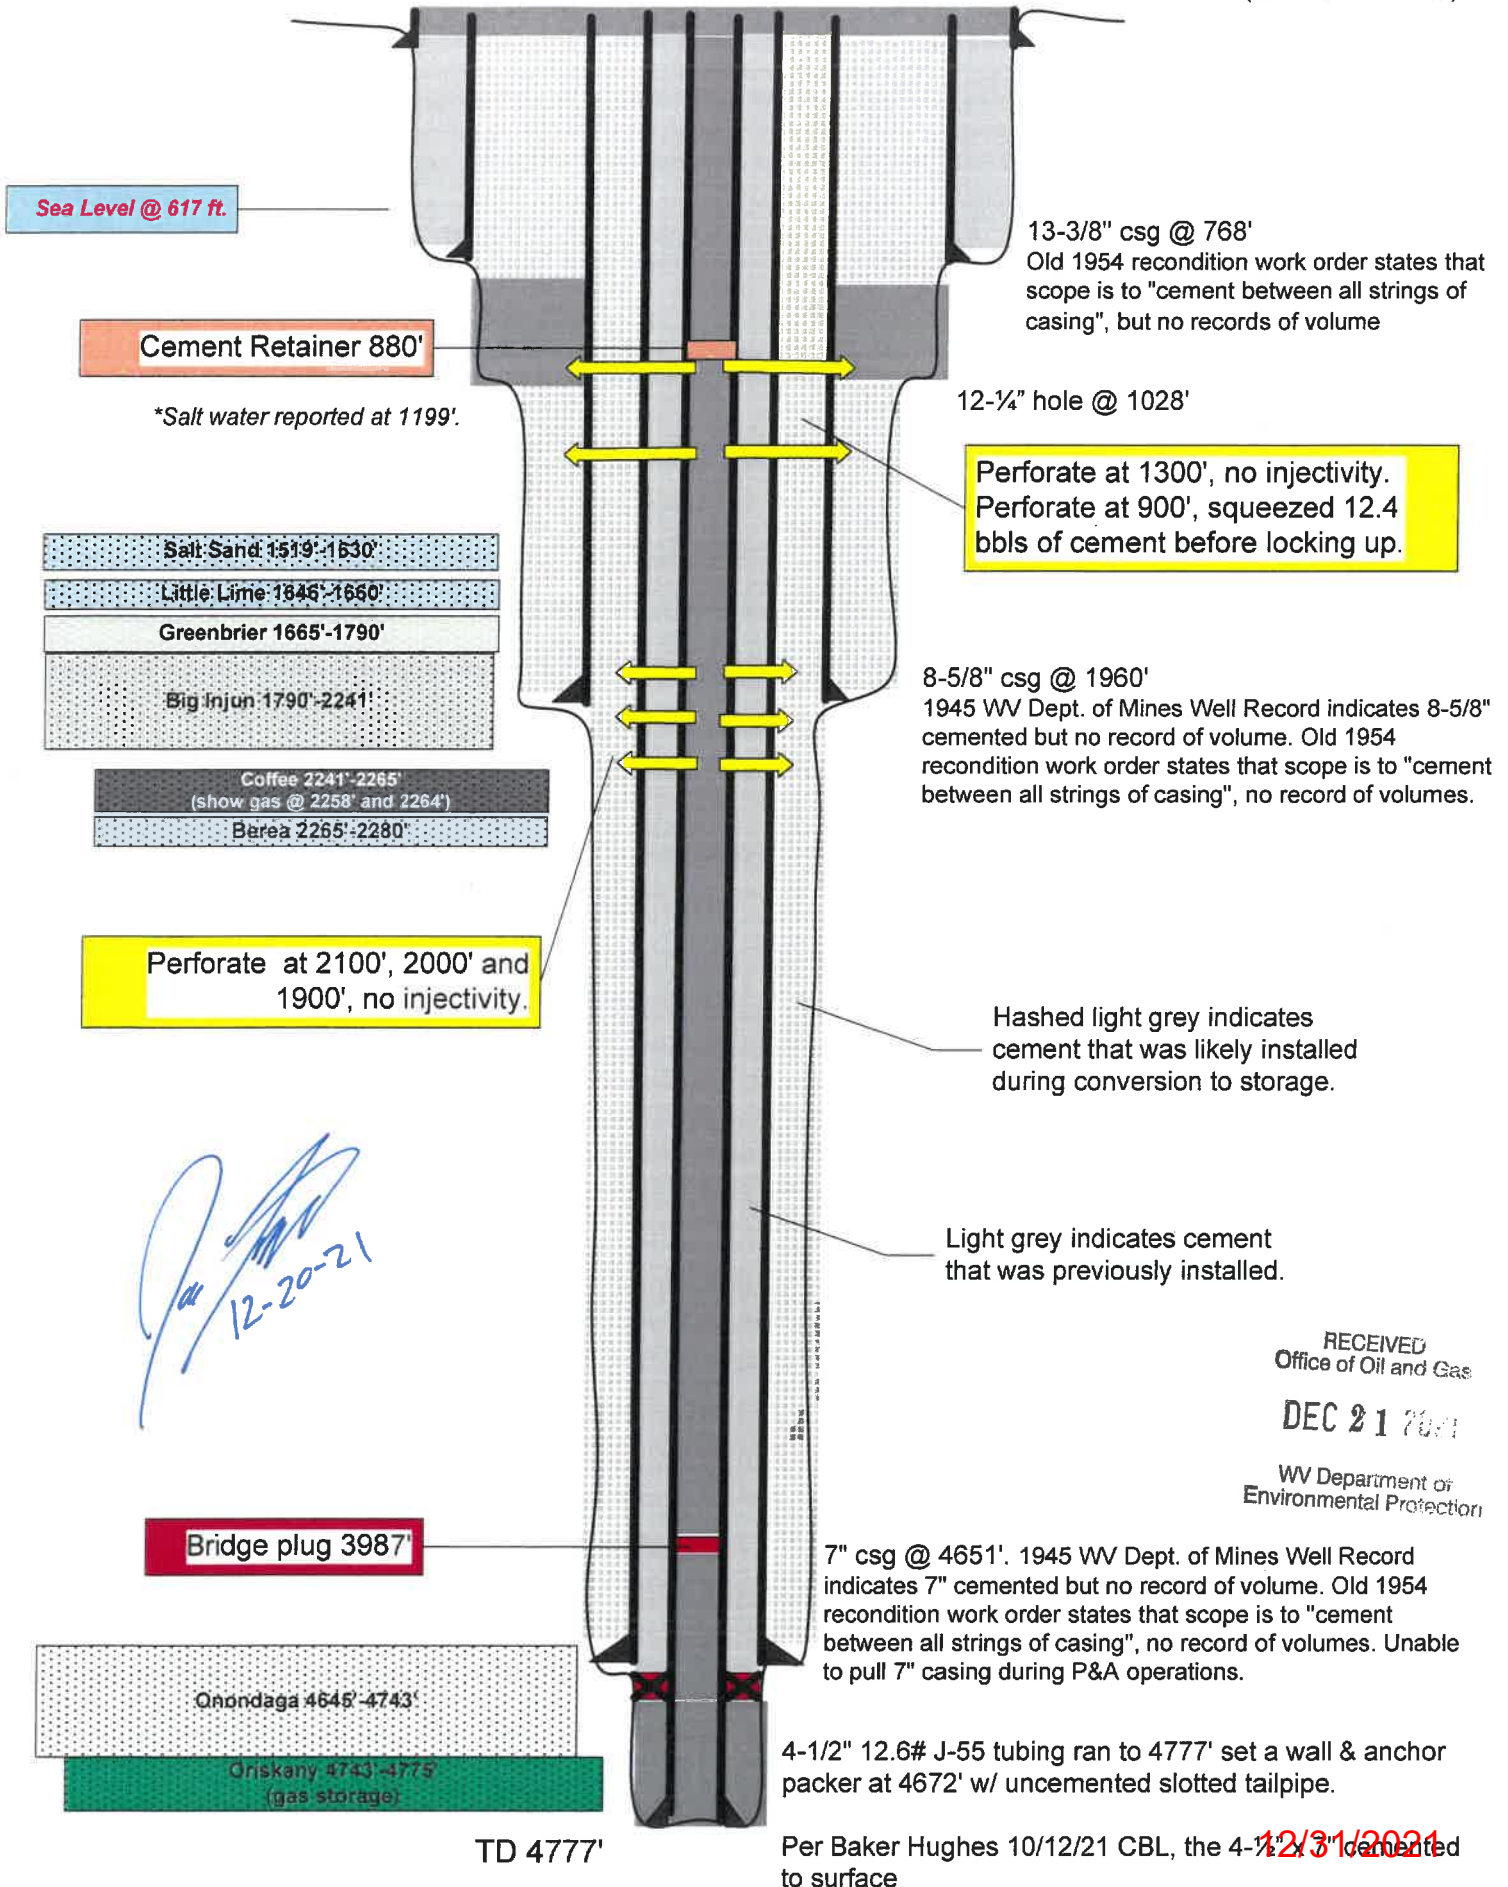

RECEIVED
Office of Oil and Gas

DEC 21 2021

WV Department of
Environmental Protection

12/31/2021