


-1
-2
-3

Longitude 81° 40'

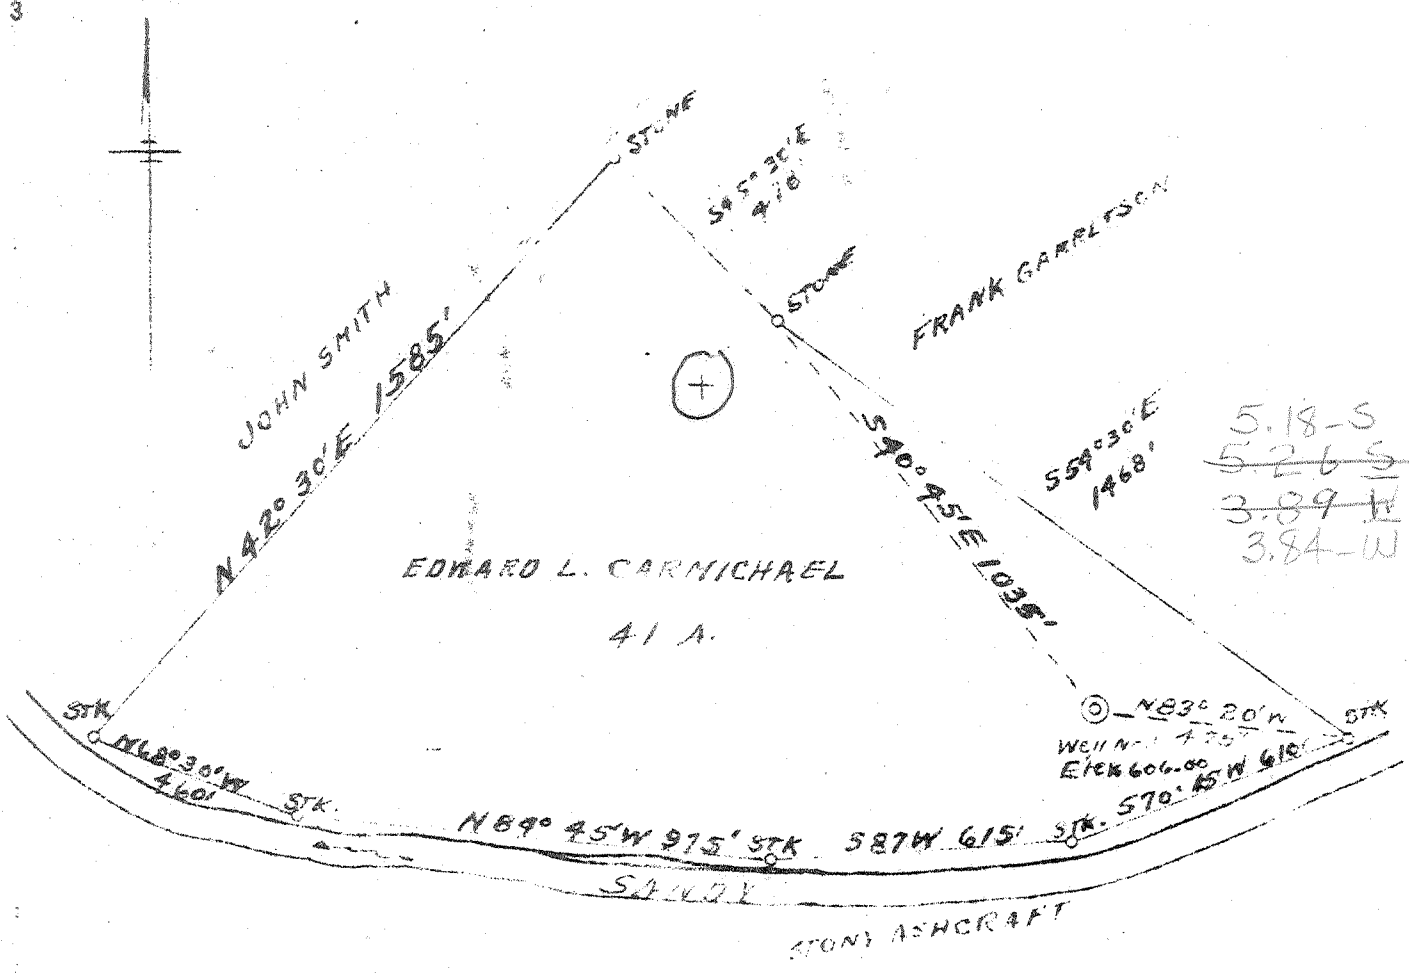

New Location
Drill Deeper
Abandonment

Company E. M. REYNOLDS
 Address RIPLEY, W.VA.
 Farm EDWARD L. CARMICHAEL
 Tract _____ Acres 41 Lease No. _____
 Well (Farm) No. 1 Serial No. _____
 Elevation (Spirit Level) 606.00
 Quadrangle RIPLEY NW
 County JACKSON District RAVENSWOOD
 Engineer R. F. Day
 Engineer's Registration No. 804
 File No. _____ Drawing No. _____
 Date 10-29-17 Scale 1" = 400'

STATE OF WEST VIRGINIA
 DEPARTMENT OF MINES
 OIL AND GAS DIVISION
 CHARLESTON

WELL LOCATION MAP
 FILE NO. JAC-573

+ Denotes location of well on United States Topographic Maps, scale 1 to 62,500 latitude and longitude lines being represented by border lines as shown.
 - Denotes one inch spaces on border line of original tracing

Unsuccessful attempt to extend Oriskany from Jac.

WEST VIRGINIA DEPARTMENT OF MINES
OIL & GAS DIVISION
W E L L R E C O R D

Permit No. Jac 573

Dry Hole
CASING & TUBING

Ripley Quad.				
Company	E.M. Reynolds			
Address	Ripley, W.Va. Box 322	13	40	Same
Farm	Edward Carmichael A 40	10	540	"
Location	Sand Creek	8 1/2	1075	"
Well No.	1 Elev. 606	6 5/8	1795	"
District	Ravenswood Jackson County			
Surface	Edward Carmichael, Ravenswood, W.Va.			
Mineral	Same			
Commenced	Nov. 17, 1947			
Completed	April 8, 1948			
Dry Hole				
Fresh Water	1067			
Salt Water	1433			

Soil	0	50
Blue Mud	50	58
Quick Sand	58	60
Red Rock	60	82
Slate Shells	82	295
Red Rock	295	325
Sand - <i>Pitts. Sand?</i>	325	385
Slate	385	450
Red Rock	450	455
Slate	455	460
Sand - <i>186 Pitts. Sand?</i>	460	525
Slate	525	530
Red Rock	530	538
Sand	568	583
Red Rock	583	625
Slate	625	715
Red Rock	715	740
Slate Shell	740	825
Red Rock	825	832
Sand	832	955
Slate	955	1060
Sand	1060	1085
Slate	1085	1100
Sand	1100	1125
Slate	1125	1150
Sand	1150	1320
Slate	1320	1422
Shell	1422	1427
Sand - <i>Sack Sand?</i>	1427	1470
✓ Lime - <i>Big Lime?</i> 340?	1470	1645
Slate Shells	1645	1687
✓ Sand - <i>Injun?</i>	1687	1770
Slate Shell	1770	1790
Lime Shell	1790	1855
Slate Shells	1855	1982
Lime - <i>Berea Horizon?</i>	1982	1998
Slate	1998	3250
Brown Shale - 441	3250	3300
Slate Shells	3300	3500
Brown Shale	3500	3715
Big White	3715	4100
Brown Shale	4100	4306
✓ Corn. Lime - 463	4306	4407
✓ Oriskany Sand	4407	4413
Lime - <i>Sack</i>	4413	4444
Total Depth		4444

4306 4407
606

3700

(475)

Smell gas 2590