

WW-7
8-30-06



West Virginia Department of Environmental Protection
Office of Oil and Gas
WELL LOCATION FORM: GPS

API: 47 035 0644 WELL NO.: Siv 12

FARM NAME: Suck

RESPONSIBLE PARTY NAME: EXCO Resources (PA)LLC

COUNTY: Jackson DISTRICT: Ravenswood

QUADRANGLE: Ripley

SURFACE OWNER: James Suck

ROYALTY OWNER: James Suck

UTM GPS NORTHING: ~~4309175~~ 4309319.6

UTM GPS EASTING: ~~0437550~~ 437442 GPS ELEVATION: 742

The Responsible Party named above has chosen to submit GPS coordinates in lieu of preparing a new well location plat for a plugging permit or assigned API number on the above well. The Office of Oil and Gas will not accept GPS coordinates that do not meet the following requirements:

1. Datum: NAD 1983, Zone: 17 North, Coordinate Units: meters, Altitude: height above mean sea level (MSL) – meters.
2. Accuracy to Datum – 3.05 meters
3. Data Collection Method:

Survey grade GPS ____: Post Processed Differential ____
Real-Time Differential ____

Mapping Grade GPS X: Post Processed Differential ____
Real-Time Differential ____

4. **Letter size copy of the topography map showing the well location.**

I the undersigned, hereby certify this data is correct to the best of my knowledge and belief and shows all the information required by law and the regulations issued and prescribed by the Office of Oil and Gas.

Randall D. Sleight
Signature


Supervisor
Title

6/22/16
Date

RECEIVED
Office of Oil and Gas

JUL 05 2016

WV Department of
Environmental Protection

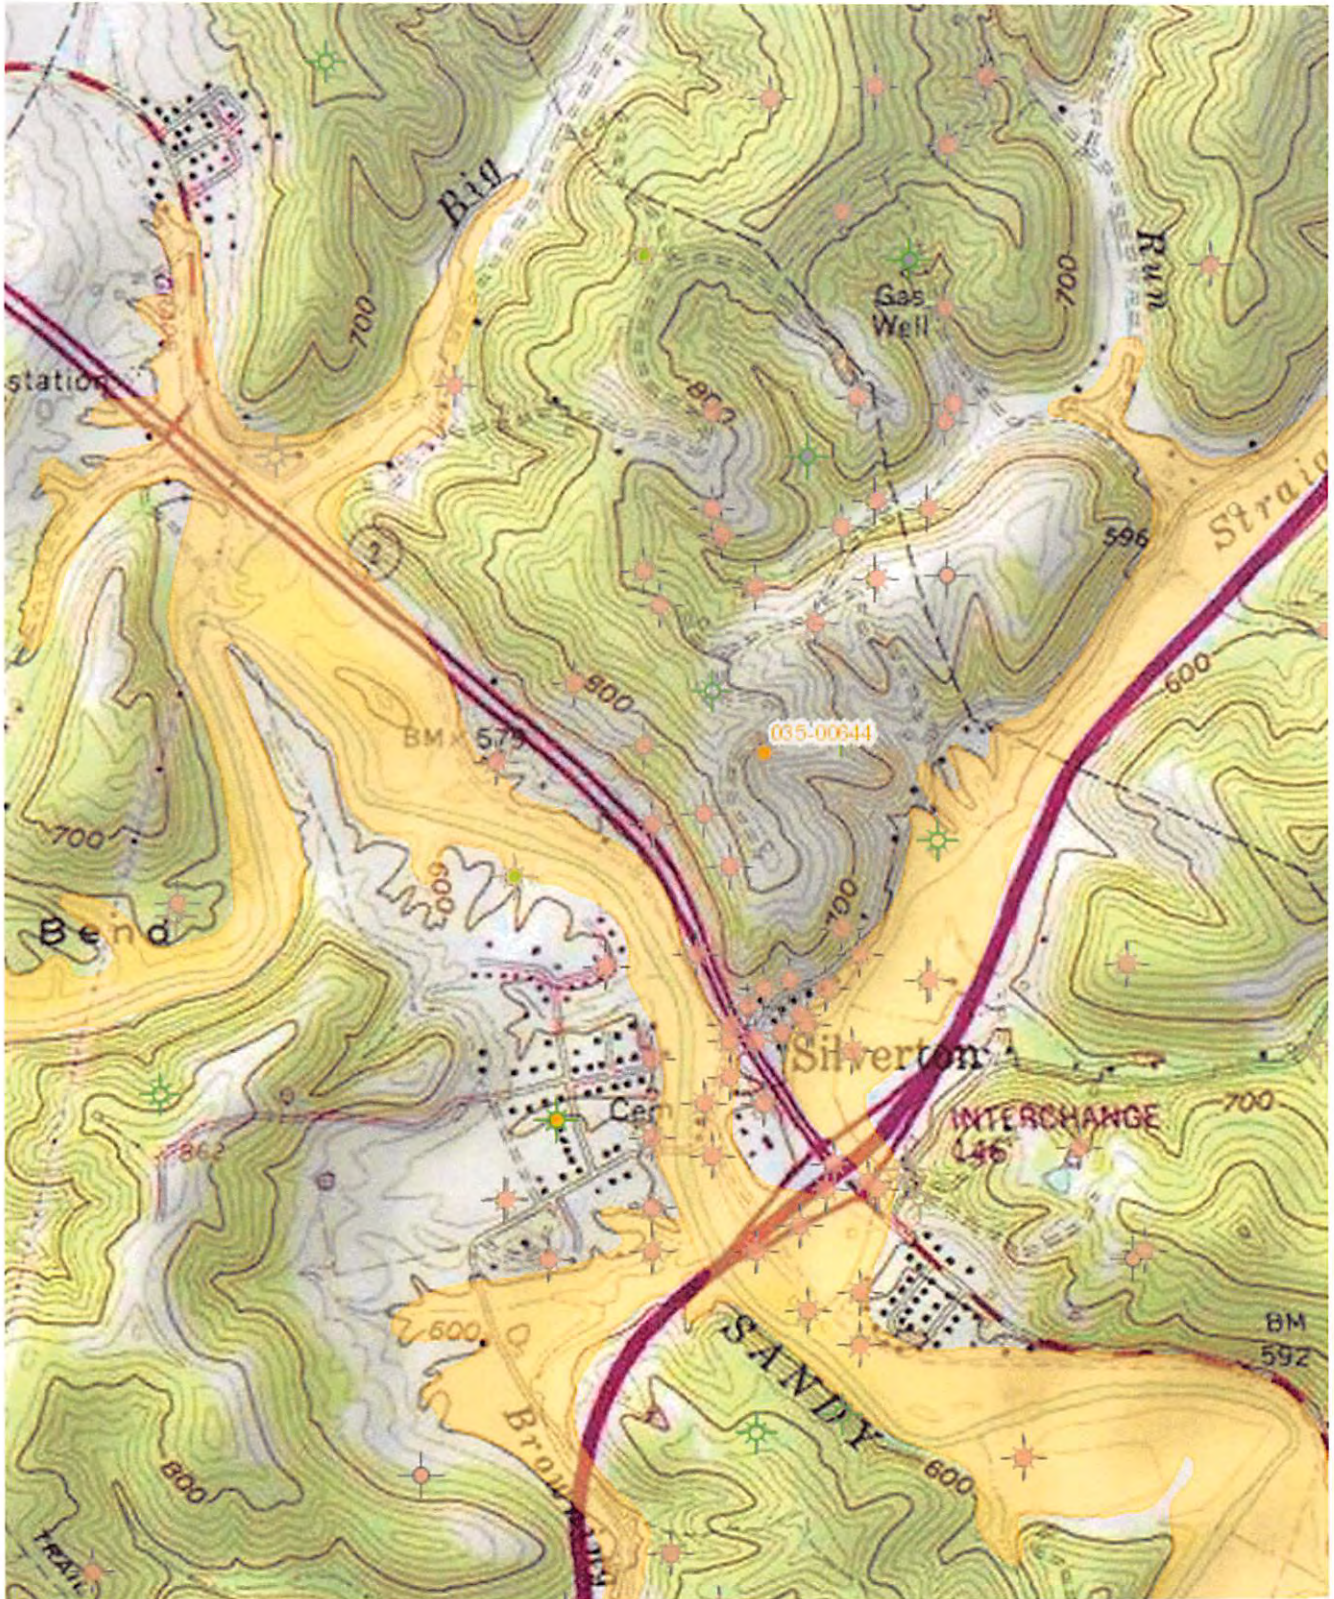

09/16/2016