

New Location
 Drill Deeper
 Abandonment

9 EC (G-5)

Company KEWANEE OIL COMPANY
 Address P.O. BOX 5251-COLUMBUS, OHIO
 Farm GAY MOORE
 Tract _____ Acres 150 Lease No. _____
 Well (Farm) No. ONE Serial No. _____
 Elevation (Spirit Level) 1040
 Quadrangle BELLEVILLE-SW
 County JACKSON District GRANT
 Engineer M.B. GOAD *M.B. Goad*
 Engineer's Registration No. IND 4040
 File No. _____ Drawing No. _____
 Date 9-22-58 Scale 1" = 500'

STATE OF WEST VIRGINIA
 DEPARTMENT OF MINES
 OIL AND GAS DIVISION
 CHARLESTON

WELL LOCATION MAP
 FILE NO. JAG-983

+ Denotes location of well on United States Topographic Maps, scale 1 to 62,500, latitude and longitude lines being represented by border lines as shown.

- Denotes one inch spaces on border line of original tracing.

66 256 Deep Well ✓



STATE OF WEST VIRGINIA
DEPARTMENT OF MINES
OIL AND GAS DIVISION 3

Quadrangle Belleville

WELL RECORD

Permit No. JAC-983

Oil or Gas Well Gas
(KIND)

Company Kewanee Oil Company
Address 1200 W. Third Ave., Columbus 12, Ohio
Farm Gay Moore Acres 150
Location (waters) _____
Well No. Moore #1 Elev. 1040
District Grant County Jackson
The surface of tract is owned in fee by Gay Moore
Sherman P.O. Address Jackson County
Mineral rights are owned by Kewanee Oil Company
1200 W. Third Ave. Address Columbus 12, Ohio
Drilling commenced 10-21-58
Drilling completed 2-5-59
Date Shot " From " To "
With "
Open Flow 50/10ths Water in 2 Inch
_____/10ths Merc. in _____ Inch
Volume 328,000 Cu. Ft.
Rock Pressure 1680 lbs. 15 hrs.
Oil _____ bbls., 1st 24 hrs.
WELL ACIDIZED 250 gal. MCA

| Casing and Tubing | Used in Drilling | Left in Well | Packers |
|-------------------|------------------|--------------|----------------|
| Size | | | Kind of Packer |
| 16 | | | |
| 13 | | | |
| 10 | 880' | 880' | Size of |
| 8 1/4 | 1270' | 1270' | |
| 6 3/4 | 2225' | 2225' | Depth set |
| 5 3/16 | 4904.46' | 4904.46' | |
| 3 | | | Perf. top |
| 2 | | | Perf. bottom |
| Liners Used | | | Perf. top |
| | | | Perf. bottom |

CASING CEMENTED 7" SIZE 2218' No. Ft. 12-31-58 Date
5-1/2" - 4904.46' - 1-28-59

COAL WAS ENCOUNTERED AT 1580 FEET 6 INCHES
____ FEET _____ INCHES FEET _____ INCHES
____ FEET _____ INCHES FEET _____ INCHES

WELL FRACTURED 10,500 gal. gelled water and 3600# sand


RESULT AFTER TREATMENT 1,912 MCFPD

ROCK PRESSURE AFTER TREATMENT 1680#

Fresh Water 860', 1405', 1760 Feet Salt Water _____ Feet

| Formation | Color | Hard or Soft | Top | Bottom | Oil, Gas or Water | Depth | Remarks |
|---------------------|---------------------|--------------|------|--------|-------------------|-------|---------------|
| Sand&shale | Gry | S | 0 | 280 | - | - | - |
| Sand | Red to tan | S | 280 | 310 | - | - | - |
| Shale | Red to grn | S | 310 | 590 | - | - | - |
| Sand | White | S | 590 | 648 | - | - | - |
| Shale | Red to grn | S | 648 | 782 | - | - | - |
| Pitt. sand | White | S | 782 | 865 | water | 860 | 10 bailers/hr |
| Shale&lime | Gry | S | 865 | 895 | - | - | - |
| Siltstone | Gry | H | 895 | 905 | - | - | - |
| Shale | Gry | S | 905 | 962 | - | - | - |
| Sand | White | H | 962 | 1000 | - | - | - |
| Shale | Red & grn | S | 1000 | 1250 | - | - | - |
| Sand&shale | White to blk | H | 1250 | 1275 | - | - | - |
| Shale & lime | Grn to tan | S | 1275 | 1300 | - | - | - |
| Sand | White | S | 1300 | 1410 | - | - | - |
| Shale | Gry | H | 1410 | 1510 | - | - | - |
| 1st Salt Sand | White | H | 1510 | 1560 | - | - | - |
| Shale | Gry | S | 1560 | 1570 | - | - | - |
| Sand | Gry | S | 1570 | 1580 | coal | 1580 | trace |
| Shale | Gry | S | 1580 | 1605 | - | - | - |
| Sand&shale | White to gry | H | 1605 | 1710 | - | - | - |
| Shale | Gry | S | 1710 | 1734 | - | - | - |
| Sand | Gry | S | 1734 | 1742 | - | - | - |
| Shale | Blk | S | 1742 | 1748 | - | - | - |
| Sand | Gry | S | 1748 | 1773 | water | 1760 | 6 bailers/hr |
| Shale | Gry blk | H | 1773 | 1844 | - | - | - |
| Maxon Sand | Gry white | S | 1844 | 1925 | - | - | - |
| Lime - <u>3200'</u> | Gry white | H | 1925 | 2030 | - | - | - |
| Shale&siltstone | Gry - <u>Inf...</u> | H | 2030 | 2090 | - | - | - |
| Shale | Gry | H | 2090 | 2365 | - | - | - |

(over)

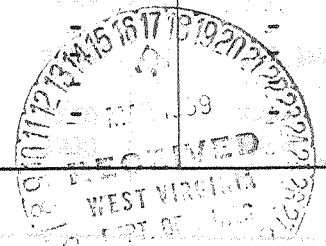

| Formation | Color | Hard or Soft | Top ³ | Bottom | Oil, Gas or Water | Depth Found | Remarks |
|-------------|------------|--------------|------------------|--------|-------------------|-------------|---------|
| Sunbury | Gry-brn | S | 2365 | 2385 | - | - | - |
| Berea | Gry | S | 2385 | 2392 | - | - | - |
| Shale | Gry to brn | S | 2392 | 4803 | gas | 3580 | show |
| | | | | | gas | 4110 | show |
| Corniferous | Tan to brn | H | 4803 | 4903 | - | - | - |
| Oriskany | Tan | H | 4903 | 4915 | gas | 4903 | 328 MCF |
| | | | | 4915 | - | - | T.D. |

475

Kendama Oil Co Date 3-16, 1959

APPROVED [Signature] Owner

By _____ (Title)

