
Plot Log Card CSD Wflm	38 45
	Lammae Communication of the Co
-2	1.88-W &
-3 (2 8 9 9 °C) (3 °C) (4 °C)	Hollow GIVEN
W.A. BIEWELL BEITHER TO THE STATE OF THE ST	
South Control of the	Moore to
The second secon	
S.S. A.S.L. Ce	
New Location . Drill Deeper	Ty that this map is correct to the best of my knowler information required by paragraph 6 of the rules section of the mining laws of West Virginia."
Company BURDETTE OIL & GAS CO. Address 7' Species ST Current W. Ch. Form SHELLY BARNETTE Tract Acres 101.75 Lease No.	STATE OF WEST VIRGINIA DEPARTMENT OF MINES OIL AND GAS DIVISION CHARLESTON
Well (Farm) No. 2 Serial No. Elevation (Spirit Level) 975°.27 Quadrangle WINFIELD NE County JACKSON District RIPLEY Engineer Serial No.	Topographic Maps, scale 1 to 62,500, letitude and longitude lines being represented by border lines as shown.
Engineer's Registration No. 1530 File No. S - 768 Drawing No. B Date Mar 11, 1972 Scale 1"2 2000"	Denotes one inch spaces on border line of original tracing.

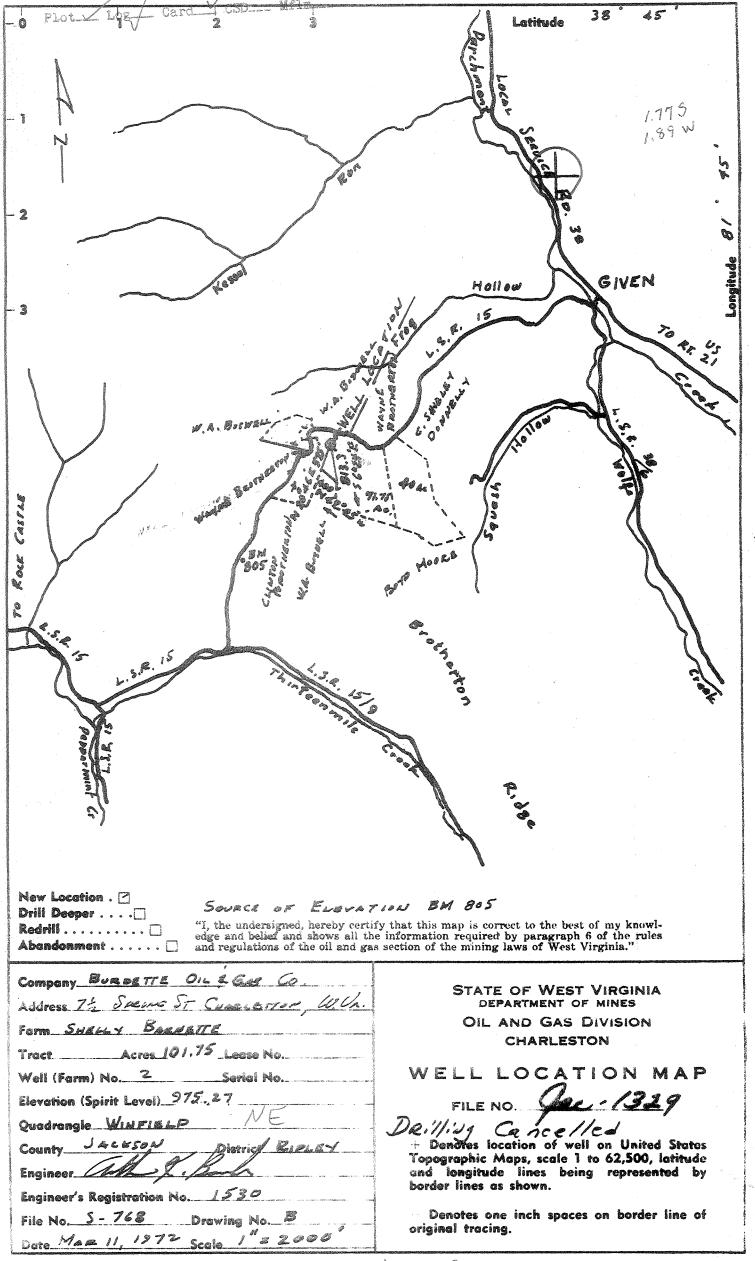

ALLEN BLUEPRINT & SUPPLY CO.

Newbulg Deep

Deep Weel

Eva

and the well operator authorized to proceed.



STATE OF WEST VIRGINIA

DEPARTMENT OF MINES

Oil and Gas Division

OIL AND GAS WELL PERMIT APPLICATION

TO THE DEPARTMENT OF MINES,					
Charleston, W. Va.	i) .	DATEMarch 17, 1972			
Surface Owner Shaley Barnett					
Address	Co	11:Datt 2	rleston,W.Va. 25302		
Mineral Owner		shaley Barnett			
Address					
Coal Owner		cation (waters)			
Address	Die	trict Ripley	Elevation		
Coal Operator	Ou.	adrangle Winfield	County		
Address	-	adrangie			
il provisions being in accordance with the W. Va. Code, the location is he or drilling. This permit she corations have not commenced by July pury Director - Oil & Gas Division	reby approved	NSPECTOR TO BE NOTIFIED BOX 1995 Sissonville, W. Va. PH: 25195	984-9263		
GENTLEMEN:					
The undersigned well operator is entitled to c	J.,.131		•		
title thereto, (or as the case may be) under grant Barnette made to Burdette O	at or lease dated	march 8 /2/2	Shelly S.		
19 72 in Jackson County, Book	121 _{Pa}	and recorded on the	day of		
NEW WELL DRILL D	EEPEK	_REDRILLFRACTI	JRE OR STIMULATE		
OIL AND GAS WELL ORIGINALL	I DRILLED BEFO	ORE JUNE 5, 1969.			
The enclosed plat was prepared by a registere have been notified as of the above date.					
The above named coal owners and/or operator to make by Section 3 of the Code, must be received.	are hereby notified ved by, or filed with	that any objection they wish to h the Department of Mines with	o make, or are required in ten (10) days. *		
Copies of this notice and the enclosed plat wer or coal owners at their above shown respective a same day with the mailing or delivery of this copy	agress	day	16		
		ulv yours,			
		ame)Original Copy sign	ed by.		
	(Sign W	Well Operator	Total Dy,		
		L. G. Burdette, Pr	esidant		
	Address of	Street Rurdetta Oil 2 Coo	Company		
	Well Operator	Burdette Oil & Gas 72 Spring St. Charl	eston, W.Va.		
		City or Town 25302			
1		State			
		orare.			

*SECTION 3 . . . If no objections are filed or found by the Department of mines, within said period of ten days from the receipt of notice and plat by the department of mines, to said proposed location, the department shall forthwith issue to the well operator a permit reciting the filing of such plat, that no objections have been made by the coal operators or found thereto by the department and that the same is approved

JAC-1329

PERMIT NUMBER

THIS IS AN ESTIMATE ONLY ACTUAL INFORMATION WILL BE SUBMITTED ON OG-10 UPON COMPLETION

PROPOSED WORK (ORDER TODRILL	DEFFEN	PAYMID C CHIND TAMB	
DRILLING CONTRACTOR: (If Known)		RESPONSIBLE AGENT		
NAME BordeHe Dulling Co. ADDRESS 71/2 Spring St				
			St Charlesta	
	.2171	¥ \$	271	
	OF COMPLETED WELL: 5700		CABLE TOOLS	
	ICAL FORMATION: Newburg		CABLE TOOLS	
	OIL GAS		TATOMOND S. T.	
			OOD OTHER	
	NBC I C	LING WAIER FU.	OTHER	
TENTATIVE CASING	PROGRAM:			
CASING AND TUB		LEFT IN	CEMENT FILL UP	
SIZI	DRILLING	WELL	OR SACKS - CUBIC FT.	
20 - 16 13 - 10				
9 - 5/8	20'	80'	70 Sirface	
8 - 5/8	2/00			
7	2/08	2100	ToScriface	
5 1/2	5700	5700	20028	
4 14				
3			Perf. Top	
			Perf. Bottom	
Liners			Perl. Top	
		to continuous and analysis (the control of the State of t	Perf. Bottom	
	H WATER DEPTHS 200 FEE			
APPROXIMATE COAL	ED IN THE AREA?	,		
		BY WHOM?		
TO DRILL:			•	
SUBMIT FIVE (S	5) COPIES OF OG - 1, \$100.00 PER	MIT FEE, PERFORMANCE BO	OND AND PERMANENT COPY	
OF PLAT.				
TO DRILL DEEPER O				
WELLS DRILLER MUST ALSO BE) COPIES OF OG - 1, SHOWING ORI D PRIOR TO 1929, A PERMANENT SUBMITTED.	GINAL PERMIT NUMBER AN COPY OF THE PLAT AND T	D PERFORMANCE BOND. ON HE ORIGINAL WELL RECORD	
TO FRACTURE - STIM	AIII ACE.			
OIL AND/OR GA	S WELL ORIGINALLY DRILLED BEF ENT PLAT AND ORIGINAL WELL R	ORE JUNE 5, 1929, FIVE (5) C	OPIES OG - 1, PERFORMANCE	
ING ORIGINAL P	S WELL ORIGINALLY DRILLED ON ERMIT NUMBER, AND PERFORMANC	E BOND.	v. FIVE COPIES OG - 1, SHOW-	
Required forms m four (24) hours in	ust be filed within ninety (90) days of advance.	completion for bond release.	Inspector to be notified twenty-	
		The second secon	C. Indices, 184. In 1969 (In 1969) A second control of the control	
The following wai hereof.	ver must be completed by the coal o	perator if the permit is to be is	ssued within ten days of receipt	
WAIVER: I the unders	igned, Agent for	Coal Company Owner	or Oppositor of the	
	ve examined and place on our mine			
providing ope	Coal Company erator has complied with all rules and re	egulations in Articles 4, 5, and 7	n being drilled at this location, , Chapter 22 of the West Virginia	
			:	
		Fo	r Coal Company	

Official Title