

4703501738A

WW-7  
8-30-06



West Virginia Department of Environmental Protection  
Office of Oil and Gas  
**WELL LOCATION FORM: GPS**

API: 47-035-01738 WELL NO.: KEM 237

FARM NAME: Elinore S. Hutchinson

RESPONSIBLE PARTY NAME: Diversified Production LLC

COUNTY: Jackson DISTRICT: Ravenswood

QUADRANGLE: Liverpool

SURFACE OWNER: Pamela Ghastin

ROYALTY OWNER: DP Bluegrass LLC

UTM GPS NORTHING: 449856.25

UTM GPS EASTING: 4305373.16 GPS ELEVATION: 880.83

The Responsible Party named above has chosen to submit GPS coordinates in lieu of preparing a new well location plat for a plugging permit or assigned API number on the above well. The Office of Oil and Gas will not accept GPS coordinates that do not meet the following requirements:

1. Datum: NAD 1983, Zone: 17 North, Coordinate Units: meters, Altitude: height above mean sea level (MSL) – meters.
2. Accuracy to Datum – 3.05 meters
3. Data Collection Method:

Survey grade GPS  : Post Processed Differential

Real-Time Differential

Mapping Grade GPS  : Post Processed Differential

Real-Time Differential

4. Letter size copy of the topography map showing the well location.

I the undersigned, hereby certify this data is correct to the best of my knowledge and belief and shows all the information required by law and the regulations issued and prescribed by the Office of Oil and Gas.

  
Signature

Digitally signed by Austin Sutler  
Date: 2022.02.23 14:05:57  
-05'00'

Sr. Proj. Manager  
Title

2/23/22  
Date


RECEIVED  
Office of Oil and Gas

MAR 10 2022

WV Department of  
Environmental Protection

05/06/2022

47-035-01738P

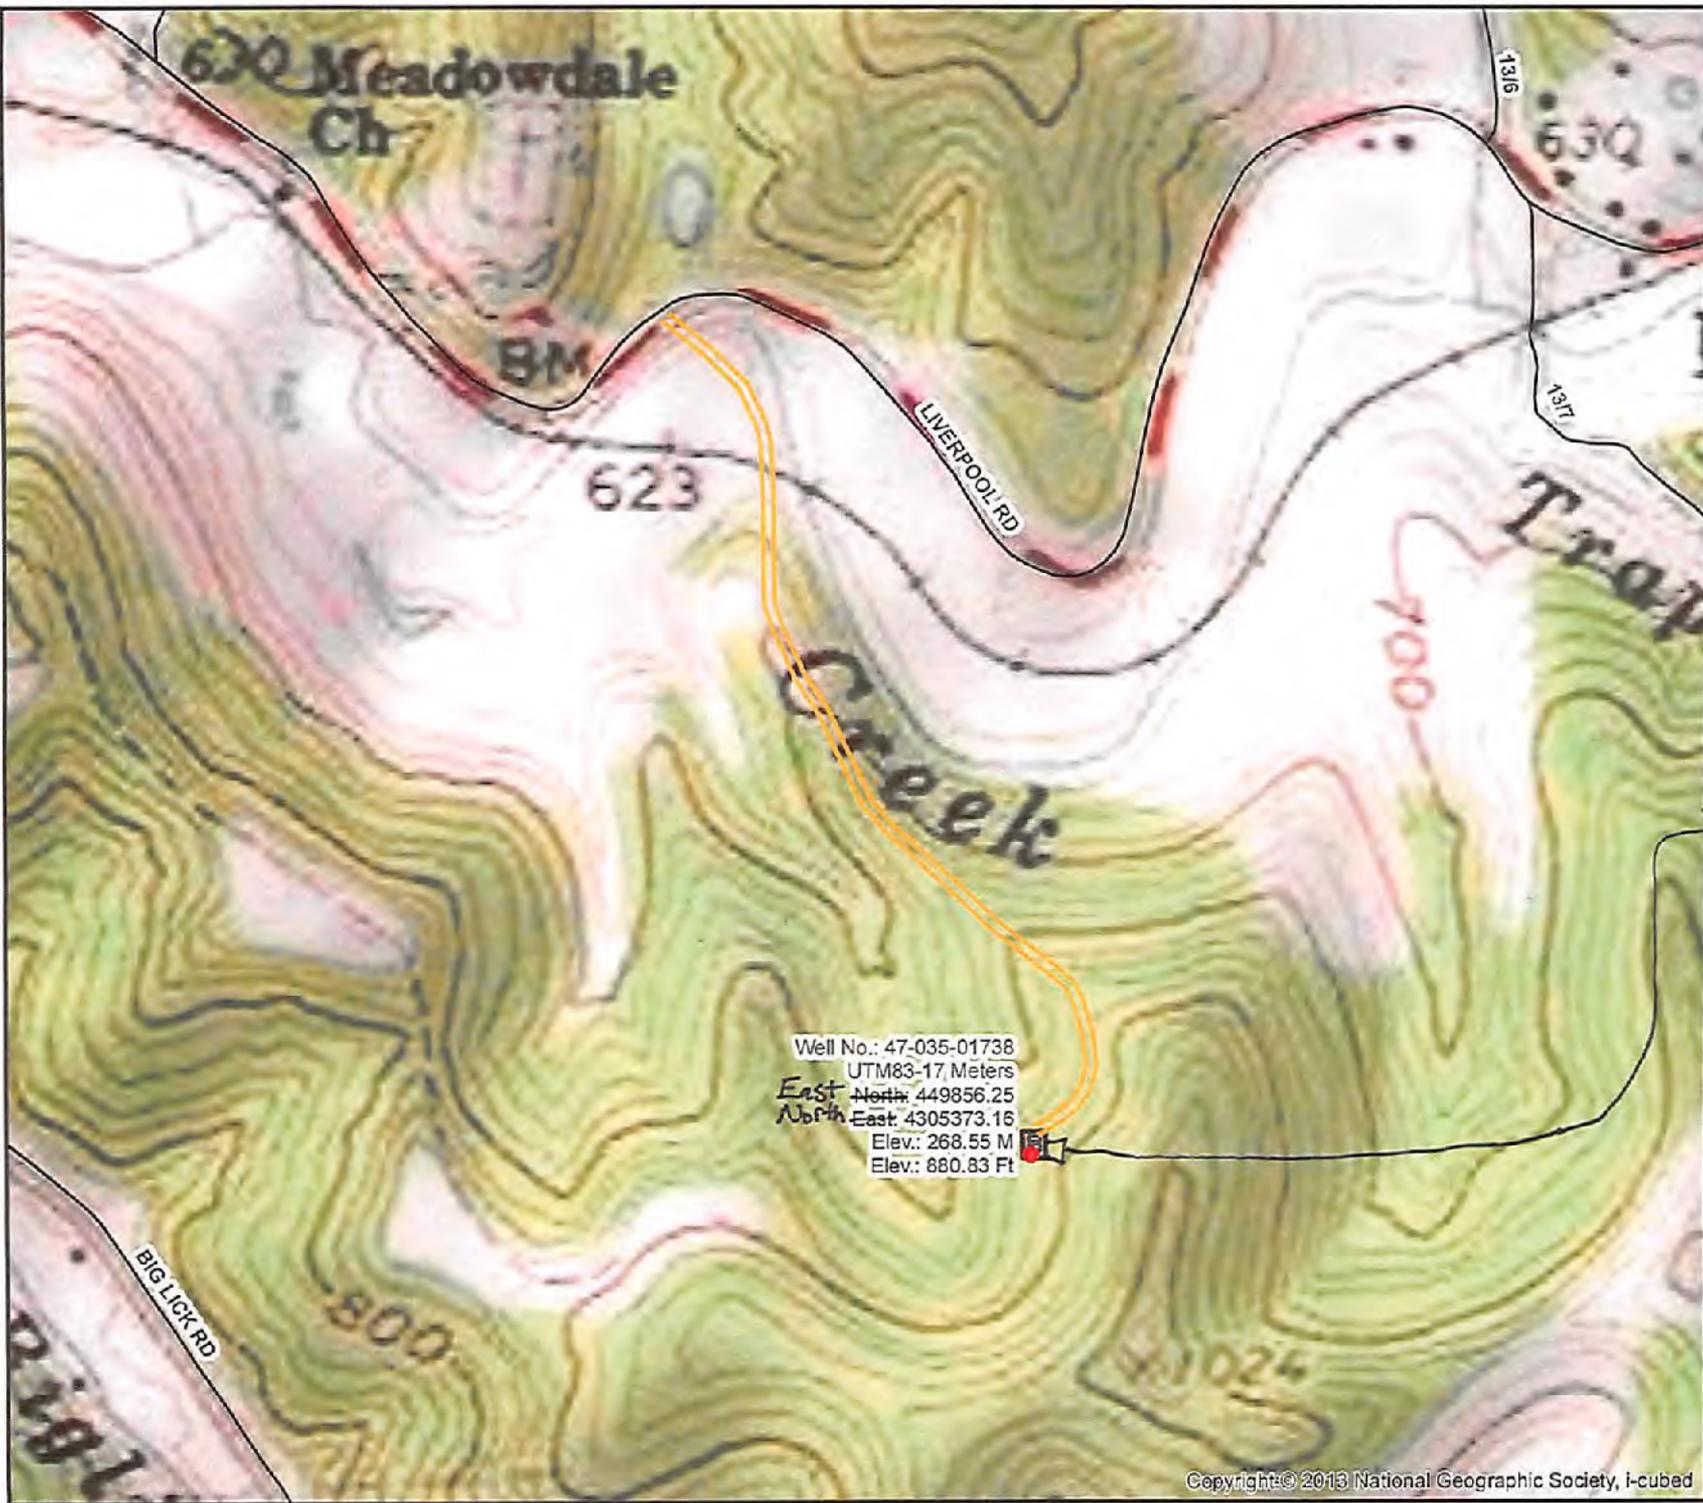

Diversified Gas & Oil Corporation  
 100 Diversified Way  
 Pikeville KY, 41051

47-035-01738

Plugging Map

**Legend**


- Well
- Access Road
- Pits
- Pad
- Public Roads

*1 Pit*  
*10' W*  
*20' L*  
*8' O*  


---

*285 bbl*

Well No.: 47-035-01738  
 UTM83-17, Meters  
 East North 449856.25  
 North East 4305373.16  
 Elev.: 268.55 M  
 Elev.: 880.83 Ft

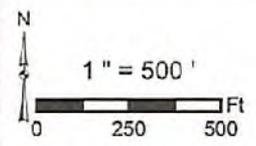

4703501738