

4703502506P

WW-7  
8-30-06



West Virginia Department of Environmental Protection  
Office of Oil and Gas  
**WELL LOCATION FORM: GPS**

API: 47-035-02506 WELL NO.: PKN 903

FARM NAME: Ray Dorothy Burdette

RESPONSIBLE PARTY NAME: Diversified Production LLC

COUNTY: Jackson DISTRICT: Ravenswood

QUADRANGLE: Sandyville

SURFACE OWNER: Justi L & Jami A. Meadows

ROYALTY OWNER: DP Bluegrass LLC

UTM GPS NORTHING: 4305223.34

UTM GPS EASTING: 449609.09 GPS ELEVATION: 963.77

The Responsible Party named above has chosen to submit GPS coordinates in lieu of preparing a new well location plat for a plugging permit or assigned API number on the above well. The Office of Oil and Gas will not accept GPS coordinates that do not meet the following requirements:

1. Datum: NAD 1983, Zone: 17 North, Coordinate Units: meters, Altitude: height above mean sea level (MSL) – meters.
2. Accuracy to Datum – 3.05 meters
3. Data Collection Method:

Survey grade GPS  : Post Processed Differential

Real-Time Differential

Mapping Grade GPS  : Post Processed Differential

Real-Time Differential

4. Letter size copy of the topography map showing the well location.

I the undersigned, hereby certify this data is correct to the best of my knowledge and belief and shows all the information required by law and the regulations issued and prescribed by the Office of Oil and Gas.

Digitally signed by Justin Suter  
Date: 2022.02.25 15:29:29  
-05'00'

Sr. Proj. Manager

2/25/2022

Signature

Title


Date

RECEIVED  
Office of Oil and Gas

MAR 14 2022

WV Department of  
Environmental Protection

05/06/2022

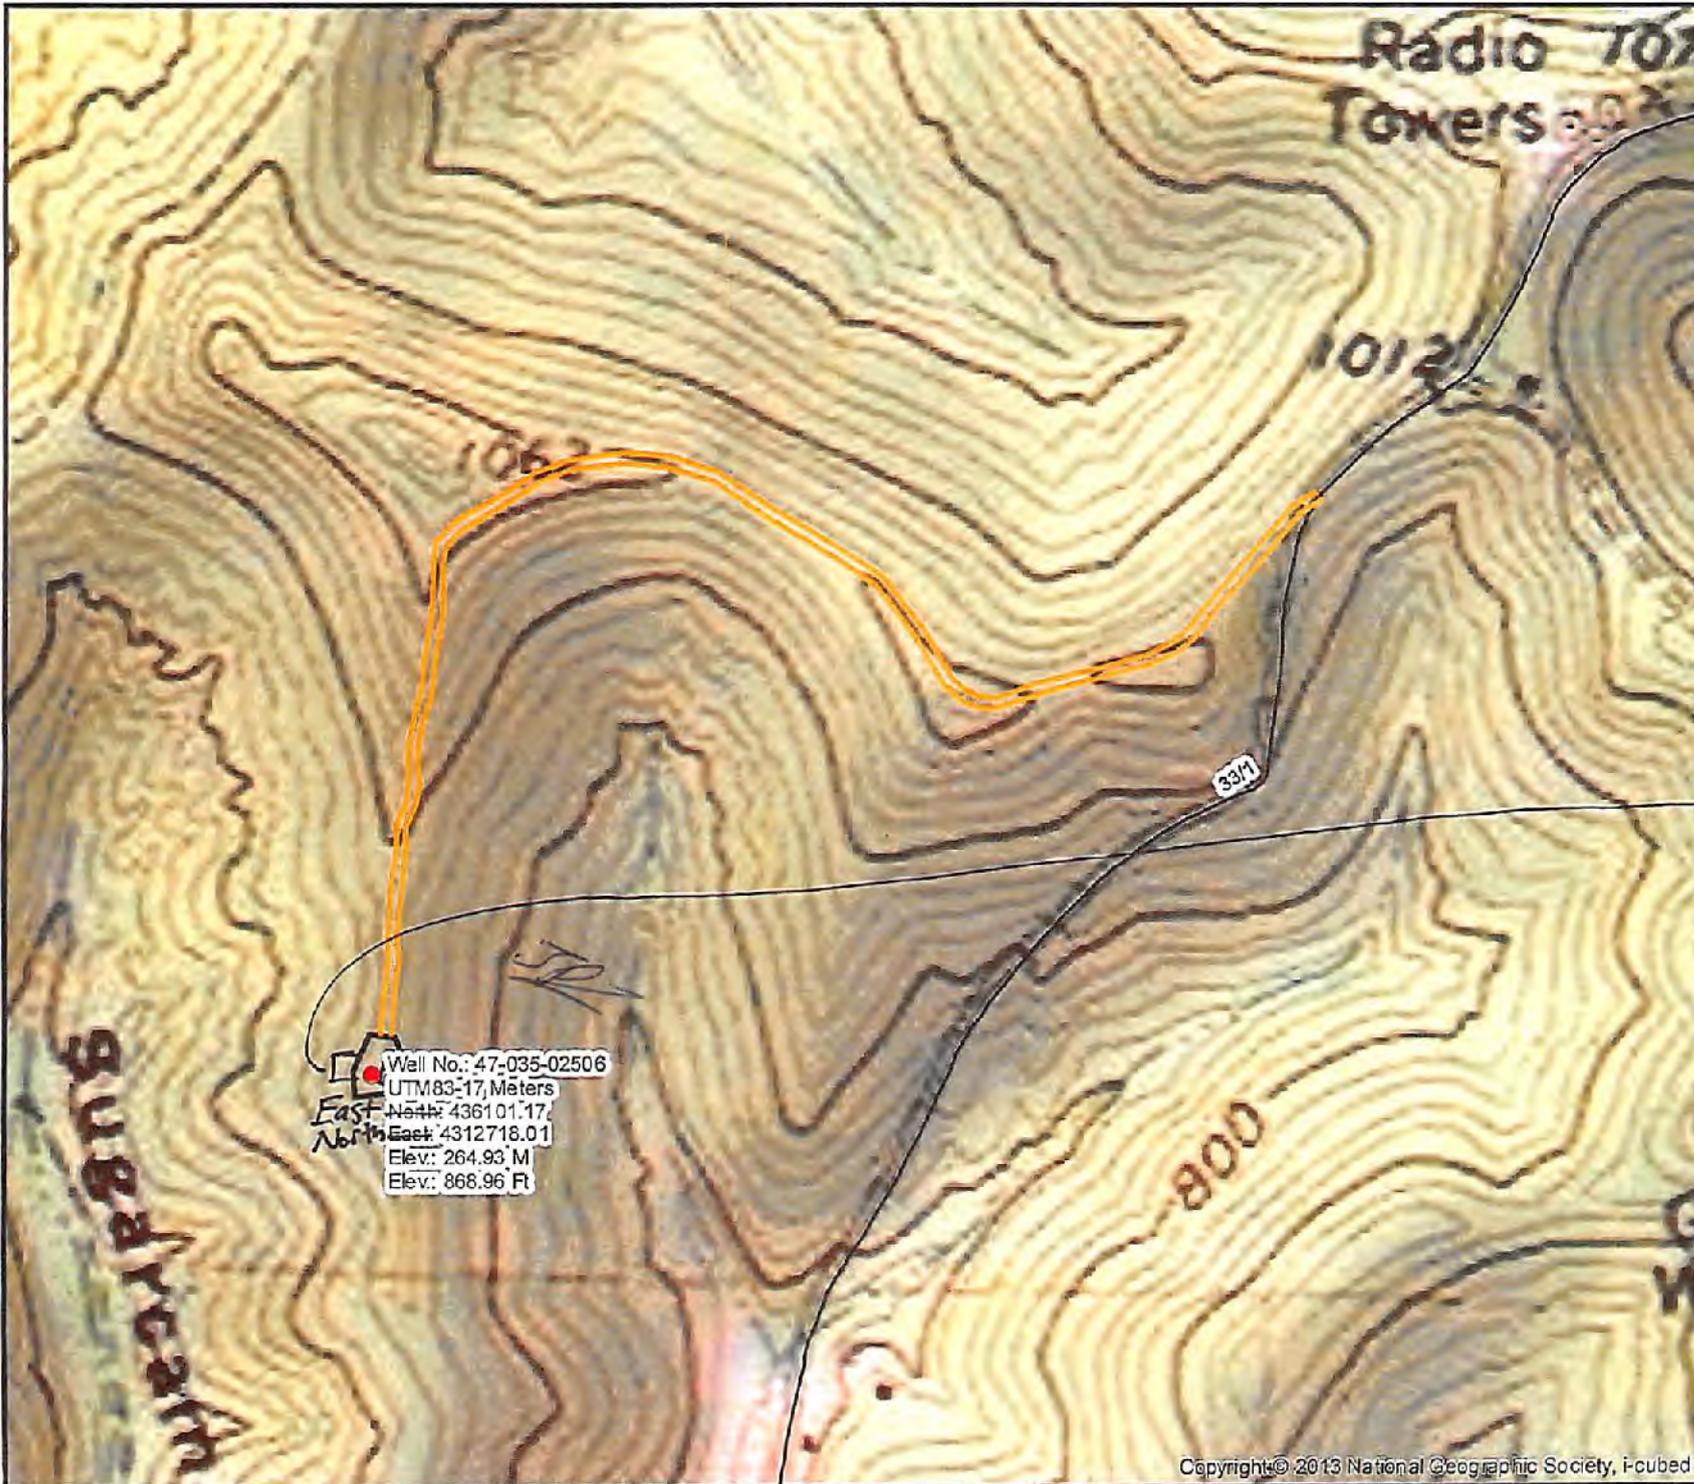

**DIVERSIFIED**  
 energy  
 100 Diversified Way  
 Pikeville KY, 41051


47-035-02506

Plugging Map

**Legend**

- Well
- Access Road
- Pits
- Pad
- Public Roads

→ Pit  
 10' W  
 20' L  
 8' D  
 285 bbl

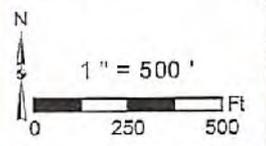

4703502506