


4703502818P

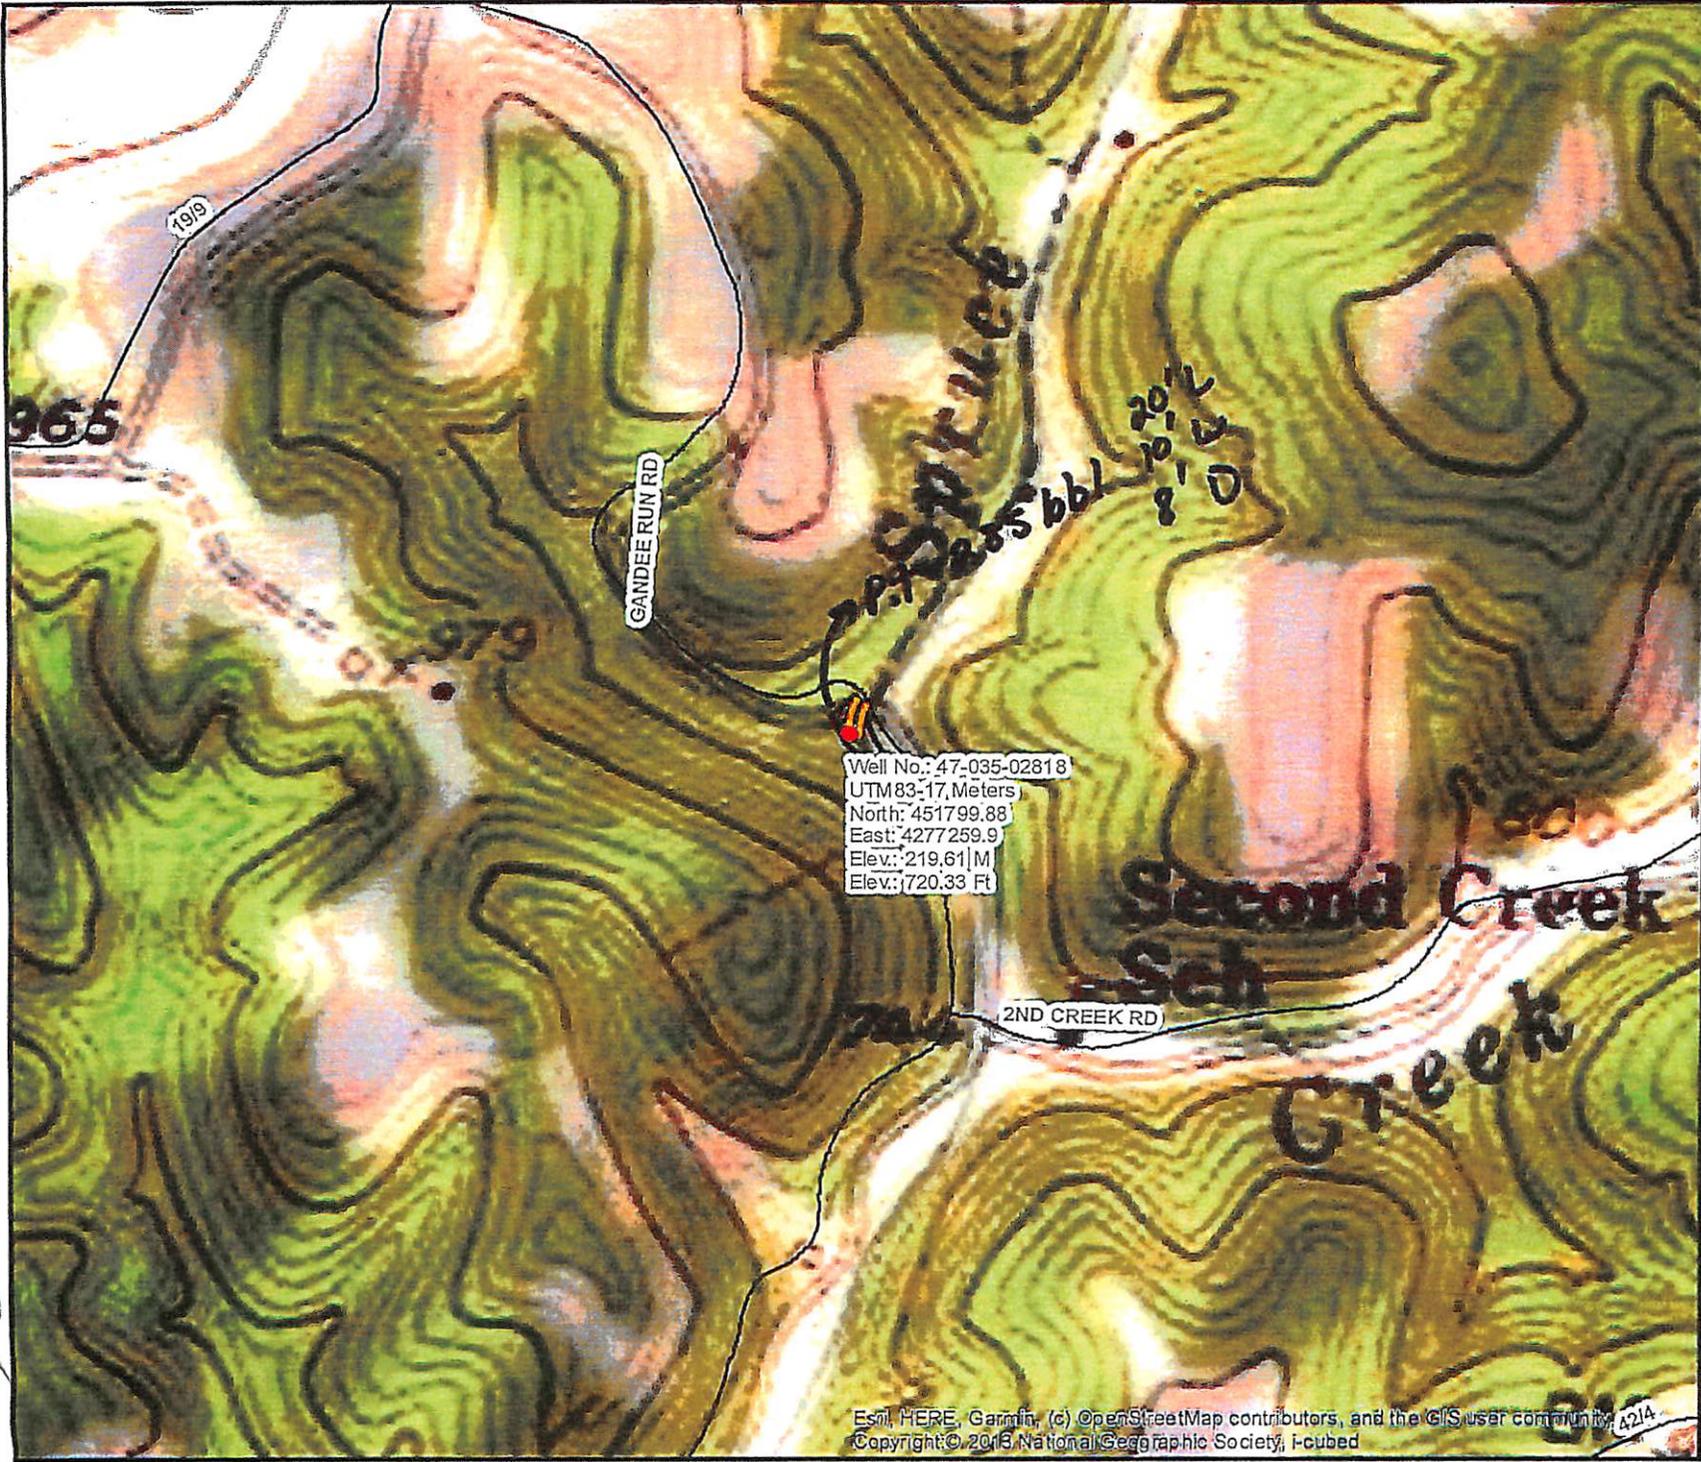



Diversified Gas & Oil Corporation
 100 Diversified Way
 Pikeville KY, 41051

47-035-02818

Plugging Map

Legend

- Well
- Access Road
- Pits
- Pad
- Public Roads

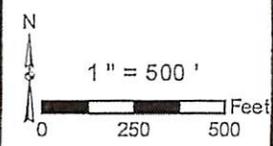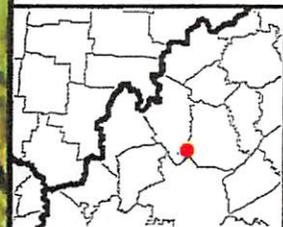

Handwritten initials/signature