


LATITUDE

38° 47' 30"  
38° 50' - 15'

81° 30' - 15'  
81° 30' 30"

LONGITUDE

FARM IS CORRECT,  
LOCATIONS ARE CORRECT,  
CORRESPONDING NUMBERS  
ARE QUESTIONABLE,  
46-A MAY BE 47-A  
LOCATION, etc.

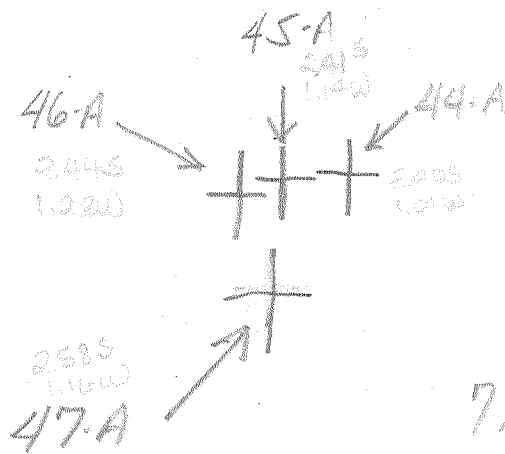

calc. 15' loc.s

- 44-A - E.295; 3.28W
- 45-A - E.295; 3.38W
- 46-A - E.325; 3.47W
- 47-A - E.465; 3.40W

Abd. Permit issued: 6-1-34 (all 4 wells)

\*LOCATED FROM OLD FARM-LINE MAPS

Company WALKER BEREN

Farm M.V. RHODES

- 44-A (3683)
- 45-A (3685)
- 46-A (3674)
- 47-A (3694)

Quad GAY 7 1/2 Ripley SE-15

County JACKSON

District WASHINGTON

WELL LOCATION MAP

Jac- File No. 44-A, 45-A, 46-A, 47-A

ABANDONED WELL FILE  
PRE-PERMIT

Washington District, Jackson County, W. Va. 45-A  
 Walker-Beren Oil Co., Parkersburg, W. Va. (W.W.Walker, partner).  
 On 50 acres.  
 Elevation, 792'.  
 13" conductor, 16'; 6-5/8" casing, 1292'.  
 No coal was encountered.  
 Abandonment reported to Dept. of Mines May 25, 1934.

	Top.	Bottom.
Red rock	0	60
Slate	60	100
Red rock	100	120
Sand	120	135
Slate	135	160
Sand	160	175
Slate	175	200
Red rock	200	235
Slate and shells	235	310
✓ Pittsburgh Sand = 1 <sup>st</sup>	310	410
Slate and shells	410	500
✓ 2nd Pittsburgh Sand	500	520
Red rock	520	550
Slate and shells	550	580
Red rock	580	600
Shell	600	610
Red rock	610	640
Slate and lime	640	720
Red rock	720	800
Slate and lime	800	1000
✓ Dunkard Sand - BIG DUNKARD	1000	1100
Slate	1100	1120
✓ Gas Sand	1120	1270
Slate	1270	1285
Sand	1285	1320
Slate	1320	1335
Sand	1335	1400
Slate and shells	1400	1579
✓ Salt Sand (oil), to bottom	1579	1601

oil @ 1579'

(285)