


LATITUDE

38° 47' 30"
38° 50' - 15'

81° 30' - 15'
81° 32' 30"

LONGITUDE

FARM IS CORRECT,
LOCATIONS ARE CORRECT,
CORRESPONDING NUMBERS
ARE QUESTIONABLE,
46-A MAY BE 47-A
LOCATION, etc.

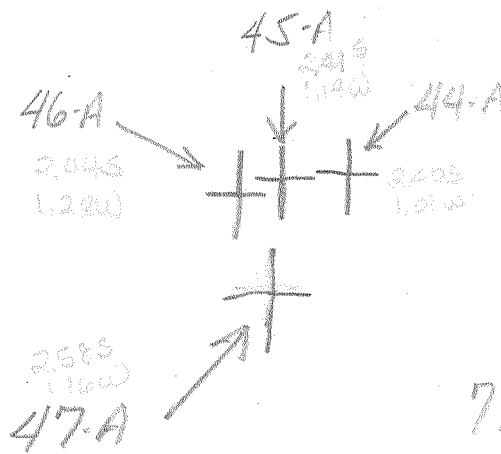

calc. 15' locs

- 44-A 5285; 3280
- 45-A 5295; 3320
- 46-A 5325; 3470
- 47-A 5465; 3400

Abd. permit issued: 6-1-34 (all 4 wells)

* LOCATED FROM OLD FARM-LINE MAPS

Company WALKER BEREN

Farm M. V. RHODES

- 44-A (3683)
- 45-A (3685)
- 46-A (3674)
- 47-A (3694)

Quad GAY 7 1/2'

County JACKSON

District WASHINGTON

WELL LOCATION MAP

Jac- File No. 44-A, 45-A, 46-A, 47-A

ABANDONED WELL FILE
PRE-PERMIT

Washington District, Jackson County, W. Va.

Walker-Beren Oil Co., Parkersburg, W. Va.

On 50 acres.

Elevation, 740'.

13" conductor, 16'; 6-5/8", 1290'.

No coal was encountered.

Abandonment reported to Dept. of Mines May 25, 1934.

47-A

	Top.	Bottom.
Red rock	0	90
Slate	90	100
Sand	100	140
Red rock	140	150
Slate	150	200
Red rock	200	250
Slate	250	300
Red rock	300	400
Lime	400	430
Pittsburgh Sand <i>which one?</i>	430	480
Slate	480	550
Red rock	550	640
Shell	640	650
Red rock	650	660
Shell	660	670
Red rock	670	800
Blue slate	800	960
✓ Sand - <i>BIG DUNKARD</i>	960	1050
Slate	1050	1060
✓ Gas Sand	1060	1140
Sand	1140	1245
Sand	1245	1270
Sand	1270	1320
Slate and shells	1320	1340
Sand	1340	1400
Slate	1400	1598
✓ Salt Sand (oil), to bottom	1598	1625 <i>(1625-1645)</i>

oil to 1598

285