


LATITUDE

38°47'30"
38°50'15"

81°30'15"
81°32'30"

LONGITUDE

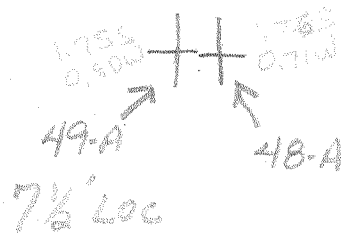

Abd permit issued: 6-1-34

Calc. 15' loc

48-A 4.645; 2.95W
49-A 4.635; 3.04W

*LOCATED FROM OLD FARM-LINE MAPS

Company WALKER-BEREN Oil Co

Farm J.G. GREENleaf
#1403 (48-A)
#1404 (49-A)

Quad Gay 7 1/2', Ripley 15' SE

County JACKSON

District WASHINGTON

WELL LOCATION MAP

JAC-
File No. 48-A, 49-A

ABANDONED WELL FILE
PRE-PERMIT

Washington District, Jackson County, W. Va. 48-A
Walker-Beren Oil Co., Parkersburg, W. Va. (W.W. Walker, partner).

On 32 acres.

Elevation, 725'.

13" conductor, 16'; 10" casing, 642'; 8 1/4", 1334'; 5-3/16", 1598'.

Disc Wall Packer, 6-5/8 x 8 1/2".

No coal was encountered.

Abandonment reported to Dept. of Mines May 25, 1934.

	Top.	Bottom.
Red rock	235	- 366
✓ 1st Cow-Run Sand - <i>LITTLE BUNKARD</i>	860	- 897
✓ 2nd Cow-Run Sand - <i>BIG BUNKARD</i>	1010	- 1090
✓ Third Salt Sand (oil), to bottom	1593	- 1631 <i>(72-1631)</i>

oil @ 1573'

205