


LATITUDE

38°47'30"

38°50' - 15'

91°30'

LONGITUDE

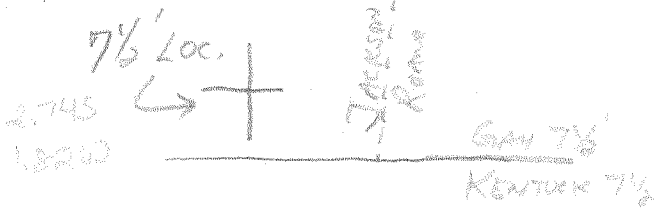

Abd. Permit issued: 12-9-35
 " " CANCELLED: DEC. 1937
 Abandoned? 1947

Calc 15' S 62.5
 loc. E 1,820 W

* LOCATED FROM OLD FARM-LINE MAPS

Company UFG #1160

Farm H. P. HALBERT ESTATE

Quad Gay 7 1/2'

County JACKSON

District WASH

WELL LOCATION MAP

File No. Jac-58-A

ABANDONED WELL FILE -
 PRE-PERMIT

Washington District, Jackson County, W. Va.

United Fuel Gas Co., Charleston, W. Va.

On 157 acres, surface and mineral rights owned by W. S. Halbert
et al., Gay, W. Va.

Drilled previous to June 1, 1929.

Elevation, 900' B.

6-5/8" casing, 1140'.

Anchor packer, 2 x 6-5/8, set at 1603'.

No coal was encountered.

Abandonment reported to Dept. of Mines Dec. 3, 1935.

Well was not shot.

Fresh water at 470'.

	Top.	Bottom.
✓Pittsburgh Sand (water, 470')	444	- 499
Slate	630	- 895
✓Cow Run Sand - LITTLE DUNKARD	895	- 965
✓Sand - BIG DUNKARD	1050	- 1190
Slate	1190	- 1300
✓Gas Sand	1300	- 1380
Slate and sand	1380	- 1649
✓Salt Sand (gas, 1664-1671')	1649	
Total depth		1684

28

Washington District, Jackson County, W. Va.
 By United Fuel Gas Co., Box 1273, Charleston, 25, W. Va.
 Abandoned under permit Jac-.....-A?
 On 157 acres, on Right Fork of Elk Fork of Mill Creek.
 Elevation, 916.8' L.
 Minerals owned by W. S. Holbert, Gay, W. Va.
 Drilling commenced March 19, 1920; completed May 1, 1920.
 Well was not shot.
 Volume, 1,000,000 cu. ft.
 Fresh water at 470'.
 8 1/2" casing, 688' (pulled); 6 5/8", 1440'; 2" tubing, 1684'.
 Snchor packer, 2 x 6 5/8, set at 1608'.
 Gas well. Abandonment reported to Dept. of Mines Oct. 30, 1946.
 Record to RCT from Mrs. Griffith Jan. 14, 1947. Old File No. 165.

	Top.	Bottom.
Sand	0	16
Red rock	16	245
Slate and shells	245	270
Slate and lime	270	312
Red rock	312	444
1st Pittsburgh Sand (water, 470')	444	499
Slate and shells	499	630
Slate	630	895
1st Cow Run Sand	895	965
Slate	965	1050
2nd Pittsburgh Sand	1050	1190
Slate	1190	1300
Gas Sand	1300	1380
Slate and sand	1380	1649
Salt Sand (gas, 1664-1671')	1649	1684
Total depth		1684