


Latitude 8° 45'

Longitude 81° 35'

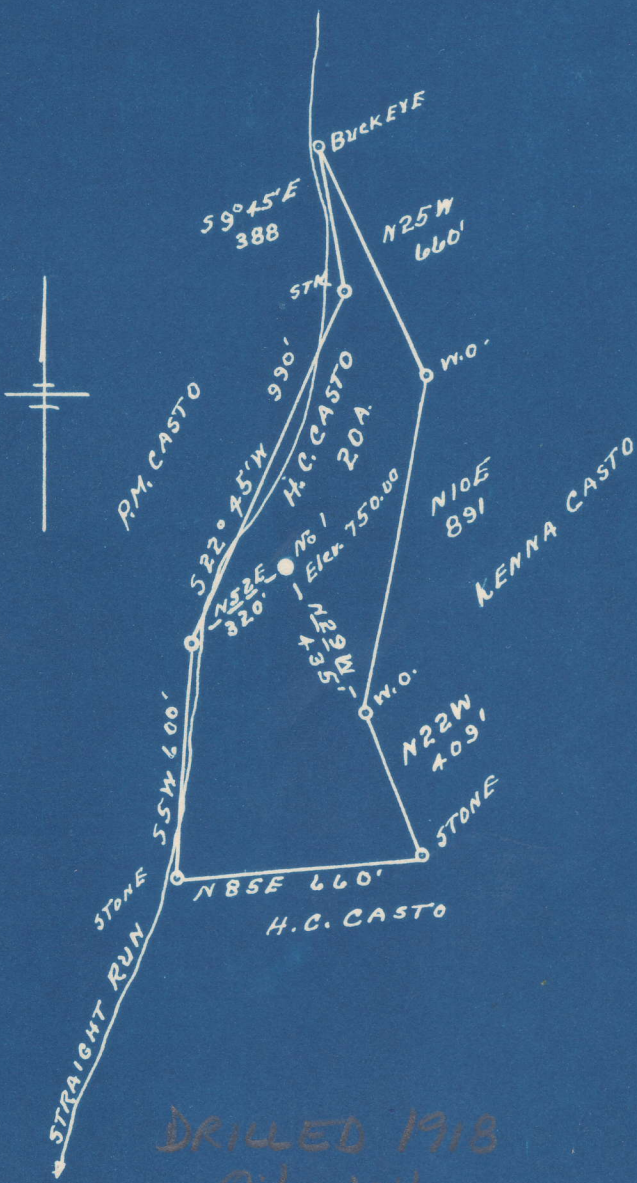

DRILLED 1918
 Oil Well
 TD-1575'
 Aug 9-15-50

S 1.77
 W 0.30

New Location
 Drill Deeper
 Abandonment

Company WALKER BEREN OIL & GAS CO.
P.O. BOX 1065
 Address PARKERS BURG, WVA.
 Farm H.C. CASTO
 Tract _____ Acres 20 Lease No. _____
 Well (Farm) No. 1 Serial No. 1382
 Elevation (Spirit Level) 750.00
 Quadrangle KENNA NC
 County JACKSON District WASHINGTON
 Engineer C.F. Dye
 Engineer's Registration No. 801
 File No. _____ Drawing No. _____
 Date 8-7-50 Scale 1" = 500'

STATE OF WEST VIRGINIA
 DEPARTMENT OF MINES
 OIL AND GAS DIVISION
 CHARLESTON

WELL LOCATION MAP
 FILE NO. JAC-122-A

+ Denotes location of well on United States Topographic Maps, scale 1 to 62,500, latitude and longitude lines being represented by border lines as shown.

- Denotes one inch spaces on border line of original tracing.

Gau (163)