

New Location..
 Drill Deeper.....
 Abandonment.....

APR 13 1955

Company	UNITED FUEL GAS CO.
Address	CHARLESTON, W. VA.
Farm	J. H. EVANS
Tract	Acres 185 Lease No. 7845
Well (Farm) No.	1 Serial No. 903
Elevation (Spirit Level)	882.20
Quadrangle	RIPLEY
County	JACKSON District WASHINGTON
Engineer	Seybert K. Farrell
Engineer's Registration No.	2529
File No.	66-87 Drawing No.
Date	3-25-55 Scale 1"=660'

STATE OF WEST VIRGINIA
 DEPARTMENT OF MINES
 OIL AND GAS DIVISION
 CHARLESTON

WELL LOCATION MAP
 FILE NO. JAC-139-A

+ Denotes location of well on United States Topographic Maps, scale 1 to 62,500, latitude and longitude lines being represented by border lines as shown.

- Denotes one inch spaces on border line of original tracing.

6-6 (163) Gay

J. H. EVANS No. 1 (903) — U. F. G. Co. — JAC-139-A



STATE OF WEST VIRGINIA
DEPARTMENT OF MINES
OIL AND GAS DIVISION

305

Quadrangle Ripley

WELL RECORD

Permit No. 132-A

Oil or Gas Well Gas
(KIND)

Company UNITED FUEL GAS COMPANY
Address P.O. Box 1273, Charleston 25, W. Va.
Farm J. H. Evans Acres 185
Location (waters) Left Fork of Elk Fork
Well No. 903 Elev. 882.20'
District Washington County Jackson

The surface of tract is owned in fee by _____
Address _____
Mineral rights are owned by Mrs. Mae Evans
Address Ravenswood, W. Va.

Drilling commenced 4-16-17
Drilling completed 6-3-17
Date Shot 6-4-28 From 2481 To 2489
With 20 qts. ABANDONED 4/27/55
Open Flow /10ths Water in Inch _____
/10ths Merc. in Inch _____
Volume 10,000,000 Cu. Ft.
Rock Pressure 830 lbs. 60 hrs.
Oil _____ bbls., 1st 24 hrs.
Fresh water _____ feet _____ feet
Salt water _____ feet _____ feet


Casing and Tubing	Used in Drilling	Left in Well	Packers
Size			
16		16	Kind of Packer Callanan
13			
10	155	160	Size of 5-3/16x3
8 1/4	1125		Depth set 2198'
6 1/2		1915	
5 3/16			
3		2527	Perf. top
2			Perf. bottom
Liners Used			Perf. top
			Perf. bottom

CASING CEMENTED _____ SIZE _____ No. Ft. _____ Date _____

COAL WAS ENCOUNTERED AT _____ FEET _____ INCHES
_____ FEET _____ INCHES _____ FEET _____ INCHES
_____ FEET _____ INCHES _____ FEET _____ INCHES

Formation	Color	Hard or Soft	Top	Bottom	Oil, Gas or Water	Depth Found	Remarks
✓ Pittsburgh Sand			480	560			
✓ 2nd Pittsburgh Sand			630	668			
✓ 1st Cow Run Sand	LITTLE DUNKARD		965	1025			
✓ 2nd Cow Run Sand	BIG DUNKARD		1110	1210			
✓ Gas Sand			1510	1565			
✓ Salt Sand			1680	1896			
✓ Pencil Cave			1896	1900			
✓ Big Lime			1900	2030			
✓ Big Injun Sand			2030	2080			
✓ Berea Sand			2481	2497			
Gas at			2485	2497			
Total depth			2527'				

410

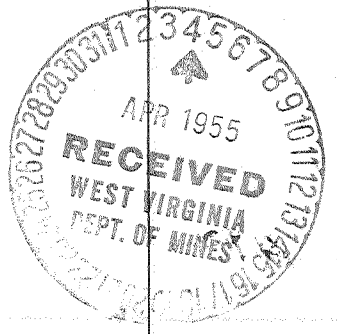

JAN. 23 1956

