


LATITUDE 38°45'

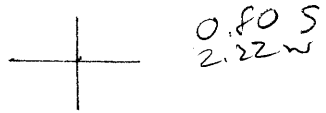

41° 45'

LONGITUDE

7'5 OGIS topo location

7.5' loc _____ 15' loc _____
 _____ (calc.) _____

Company Staats et Al

Farm Staats et Al 1

Quad _____

County Jackson

District Washington

WELL LOCATION MAP

File No. 035-70056

14 in WUGES

Jackson County Report