

- New Location .
- Drill Deeper
- Redrill
- Abandonment

"I, the undersigned, hereby certify that this map is correct to the best of my knowledge and belief and shows all the information required by paragraph 6 of the rules and regulations of the oil and gas section of the mining laws of West Virginia."

2-9-72

West Va. Department of Mines -
Company Oil & Gas Wells Division

Address Charleston, West Va., 25305

Farm John Haddox

Tract _____ Acres 192 Lease No. _____

Well (Farm) No. Three Serial No. _____

Elevation (Spirit Level) 1040'

Quadrangle Mannington S.C.

County Marion District Mannington

Engineer _____

Engineer's Registration No. _____

File No. _____ Drawing No. _____

Date Sept. 3, 1970 Scale 1" = 800'

STATE OF WEST VIRGINIA
DEPARTMENT OF MINES
OIL AND GAS DIVISION
CHARLESTON


WELL LOCATION MAP

FILE NO. MAR-943(A)

+ Denotes location of well on United States Topographic Maps, scale 1 to 62,500, latitude and longitude lines being represented by border lines as shown.

— Denotes one inch spaces on border line of original tracing.

5.65
4.02 W

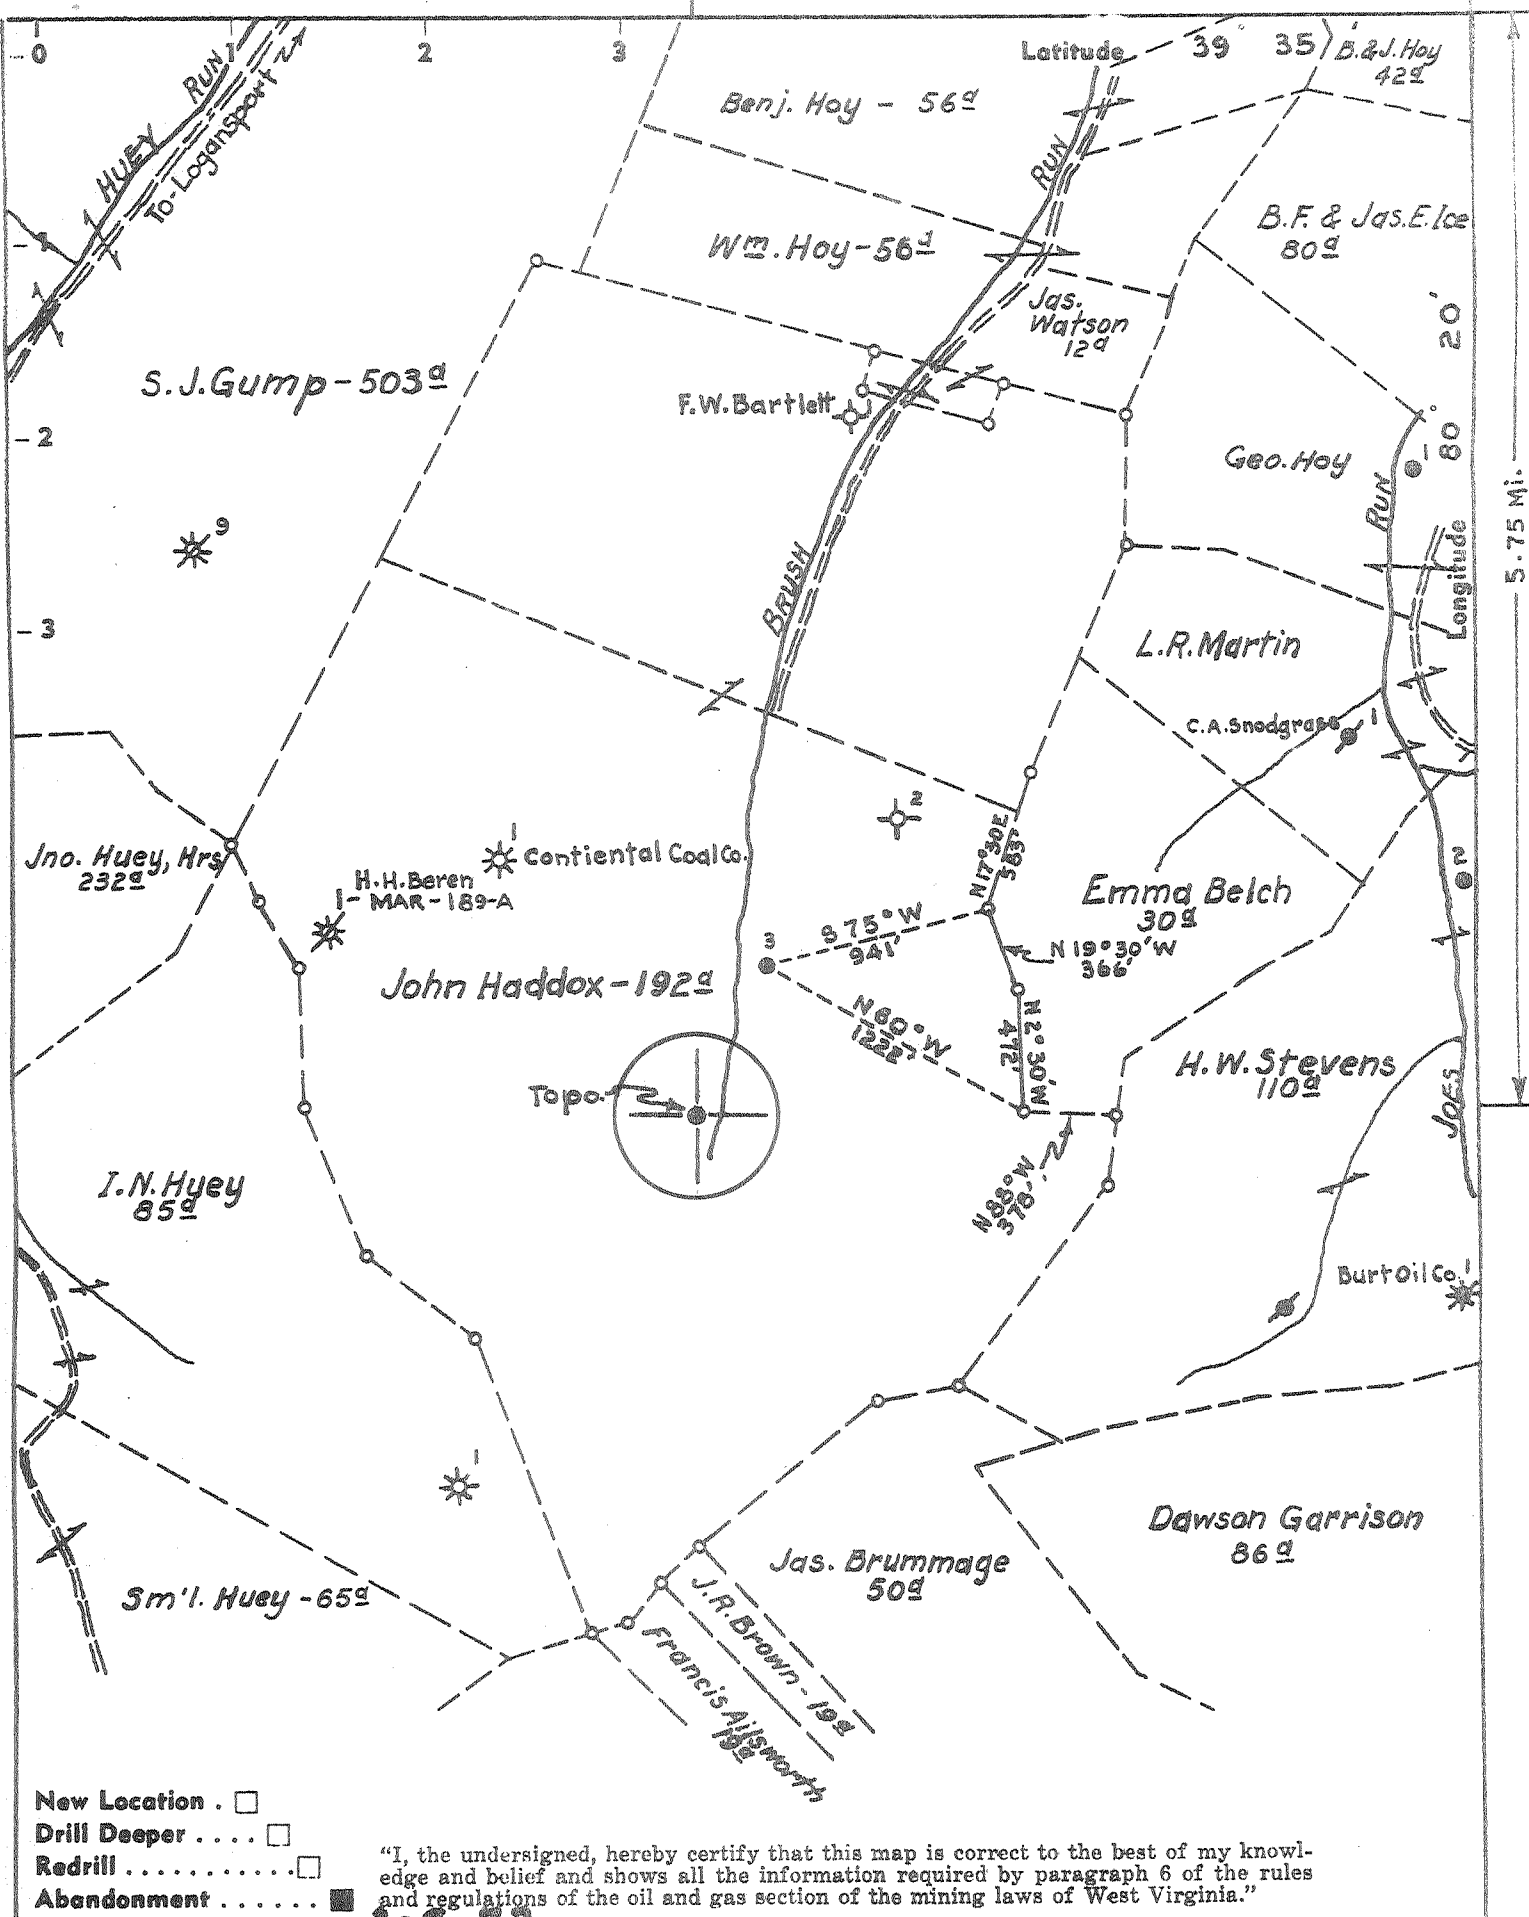

- New Location .
- Drill Deeper
- Redrill
- Abandonment

"I, the undersigned, hereby certify that this map is correct to the best of my knowledge and belief and shows all the information required by paragraph 6 of the rules and regulations of the oil and gas section of the mining laws of West Virginia."

West Va. Department of Mines -
Company Oil & Gas Wells Division

Address Charleston, West Va., 25305

Farm John Haddox

Tract _____ Acres 192 Lease No. _____

Well (Farm) No. Three Serial No. _____

Elevation (Spirit Level) 1040'

Quadrangle Mannington S.C.

County Marion District Mannington

Engineer _____

Engineer's Registration No. _____

File No. _____ Drawing No. _____

Date Sept. 3, 1970 Scale 1" = 800'

STATE OF WEST VIRGINIA
DEPARTMENT OF MINES
OIL AND GAS DIVISION
CHARLESTON

WELL LOCATION MAP

FILE NO. MAR-943(A)

CANCELLED - Reissued As 955-A

+ Denotes location of well on United States Topographic Maps, scale 1 to 62,500, latitude and longitude lines being represented by border lines as shown.

— Denotes one inch spaces on border line of original tracing.

see note

Marion 943A and Mar 954 are ~~entirely~~ different wells. 955 is approximately 1320' South of Mar 943A. The plat on 943A was made in this office from an old South Penn farm map and the topo location is wrong. actually - 943A and 954 ~~are~~ would spot at the same topo location with the 954 topo + correct. Mar 943A was cancelled and re bid and plugged with a corrected plat, and to save (I thought) confusion we used the corrected plat and farm name when we re advertised and plugged the well.

Marion 943A and Mar 955 are ~~actually~~ different wells. 955 is approximately 1320' south of Mar 943A. The plat on 943A was made in this office from an old South Penn farm map and the topo location is wrong. actually - 943A and 954 ~~are~~ would spot at the same topo location with the 954 topo + Corred. Mar 943A was cancelled and re bid and plugged with a Correded plat, and to save (I thought) confusion we used the Correded Plat and farm name when we readvertised and plugged the well.