


111 No. 6  
+ 129  
0.475  
0.580

Longitude 80° 50'

Pittsburgh Plate Glass Co.

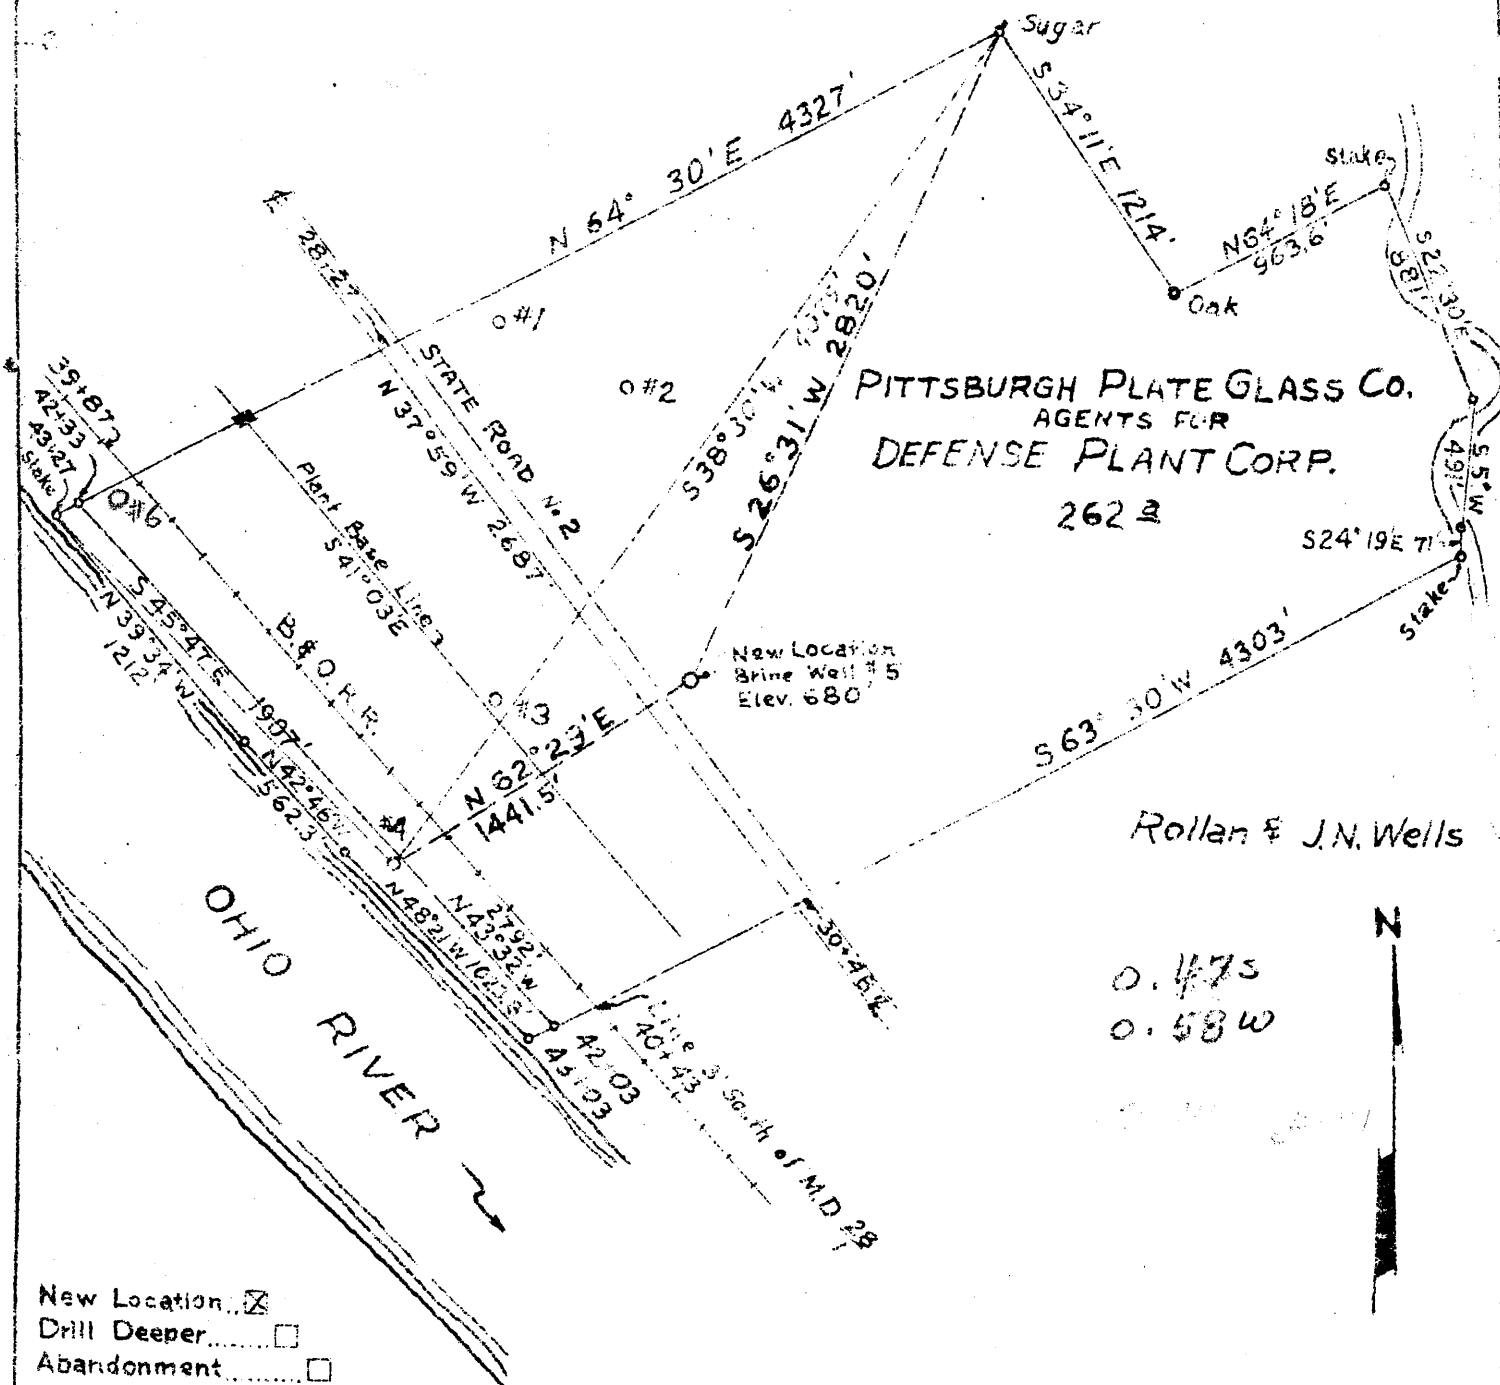

Rollan & J.N. Wells

0.475  
0.580



- New Location
- Drill Deeper
- Abandonment

Company PITTSBURGH PLATE GLASS Co  
 Address AGENTS NEW MARTINSVILLE W.VA.  
 Farm DEFENSE PLANT CORP  
 Tract \_\_\_\_\_ Acres 262 Lease No. \_\_\_\_\_  
 Well (Farm) No. X 6 Serial No. \_\_\_\_\_  
 Elevation (Spirit Level) ~~588~~ 647  
 Quadrangle NEW MARTINSVILLE - NC  
 County MARSHALL District FRANKLIN  
 Engineer John L. Michaelis  
 Engineer's Registration No. 1242  
 File No. \_\_\_\_\_ Drawing No. \_\_\_\_\_  
 Date 3-19-46 Scale 1" = 800'

STATE OF WEST VIRGINIA  
 DEPARTMENT OF MINES  
 OIL AND GAS DIVISION  
 CHARLESTON

WELL LOCATION MAP

FILE NO. ~~MARS 169~~  
MARS-191

+ Denotes location of well on United States Topographic Maps, scale 1 to 62,500, latitude and longitude lines being represented by border lines as shown.

- Denotes one inch spaces on border line of original tracing.

1-0 23  
 Deep Well

4 5 4 39045'  
 7 W  
 2 NE (E-8) 80' 50'

WEST VIRGINIA DEPARTMENT OF MINES  
 OIL & GAS DIVISION  
 WELL RECORD

P

Permit No. Mars 191  
 New Martinsville Quad.  
 Company  
 Address  
 Farm  
 Location  
 Well No.  
 District  
 Surface  
 Mineral  
 Commenced  
 Completed

Pittsburgh Plate Glass Company  
 New Martinsville, W.Va.  
 Snow Farm Acres 42.83 plus or minus  
 Ohio River  
 6 Elev. 647  
 Franklin Marshall County  
 Pittsburgh Plate Glass Co.  
 New Martinsville, W.Va.  
 Same  
 Sept. 20, 1948  
 Jan. 15, 1949

Brine Well  
 CASING & TUBING

13 3/8 922 922  
 10 3/4 950  
 8 5/8 5709  
 4 1/2 6739

Casing cemented:  
 13 3/8 922' 9-28-48  
 8 5/8 2500' 1-10-49

Red Red, Sand, Shells	0	42
Shale, Lime	42	100
Shale, Lime, Sand	130	273
Shale, Lime	278	355
Lime	355	1135
Sand	1135	1157
Lime	1157	1340
Sand	1340	1358
Lime, Sand	1358	1381
Sand	1381	1540
Shale	1540	1545
Lime	1545	1552
Lime, Sand	1552	1578
Lime, Shale	1578	1607
Shale	1607	1615
Sand	1615	1623
Shale	1623	1664
Shale, Lime	1664	1746
Lime	1746	1805
Lime Shale	1805	2296
Shale, Sand	2296	2320
Sand, Lime	2320	2452
Shale, Shells	2452	2489
Shale, Lime	2489	2558
Shale, Shells	2558	2650
Shale	2650	2906
Shale, Lime	2906	2948
Shale	2948	2975
Shale, Lime	2975	3016
Shale	3016	3079
Shale, Shells	3079	3107
Shale	3107	3132
Shale, Lime	3132	3444
Shale	3444	3462
Shale, Lime	3462	3559
Shale	3559	3600
Shale, Lime	3600	3746
Shale	3746	3755
Shale, Lime	3755	3797
Shale, Shells	3797	3824
Shale	3824	4017
Shale, Shells	4017	4035
Shale	4035	4154
Shale, Shells	4154	4198
Shale	4198	4388
Shale, Lime	4388	4415
Shale	4415	5735
Shale, Lime	5735	5757
Lime	5757	5979
Sand	5979	5986
Sand, Lime	5986	6023
Lime	6023	6354
Lime, Shale	6354	6355
Lime	6355	6664
Salt	6664	6713
Lime	6713	6729
Salt	6729	6751
Lime	6751	6809

No cores taken

1358  
 647  
 ---  
 711

6023  
 647  
 ---  
 5376

Oriskany  
 Niagara Lime  
 Oriskany Sand  
 Oriskany Sand  
 Helderberg Lime

5757  
 647  
 ---  
 5110

5979  
 647  
 ---  
 5332