

LATITUDE 39 0 55
NOTE

LONGITUDE 80 0 30'

COAL OWNED BY _____
 RECONDITIONED
 NEW LOCATION.....
 DRILL DEEPER.....
 ABANDONMENT.....

0-25-15


COMPANY THE MANUFACTURERS LIGHT & HEAT CO.
 ADDRESS 800 UNION TRUST BLDG. PSH. PA.
 FARM W. T. PHILLIPS
 TRACT _____ ACRES 138 LEASE No. 27245
 WELL (FARM) No. 1 SERIAL No. L-1545
 ELEVATION (SPIRIT LEVEL) 1283.30'
 QUADRANGLE CAMERON - EC
 COUNTY MARSHALL DISTRICT WEBSTER
 ENGINEER A. C. Steator M.
 ENGINEER'S REGISTRATION No. 9422
 FILE No. _____ DRAWING No. Y-15-732
 DATE 7 APR. 58 SCALE 1" = 800'

STATE OF WEST VIRGINIA
 DEPARTMENT OF MINES
 OIL AND GAS DIVISION
 CHARLESTON

WELL LOCATION MAP

FILE No. MARS-323-REDRILL

+ DENOTES LOCATION OF WELL ON UNITED STATES TOPOGRAPHIC MAPS. SCALE 1 TO 62,500. LATITUDE AND LONGITUDE LINES BEING REPRESENTED BY BORDER LINES AS SHOWN.
 — DENOTES ONE INCH SPACES ON BORDER LINE OF ORIGINAL TRACING.

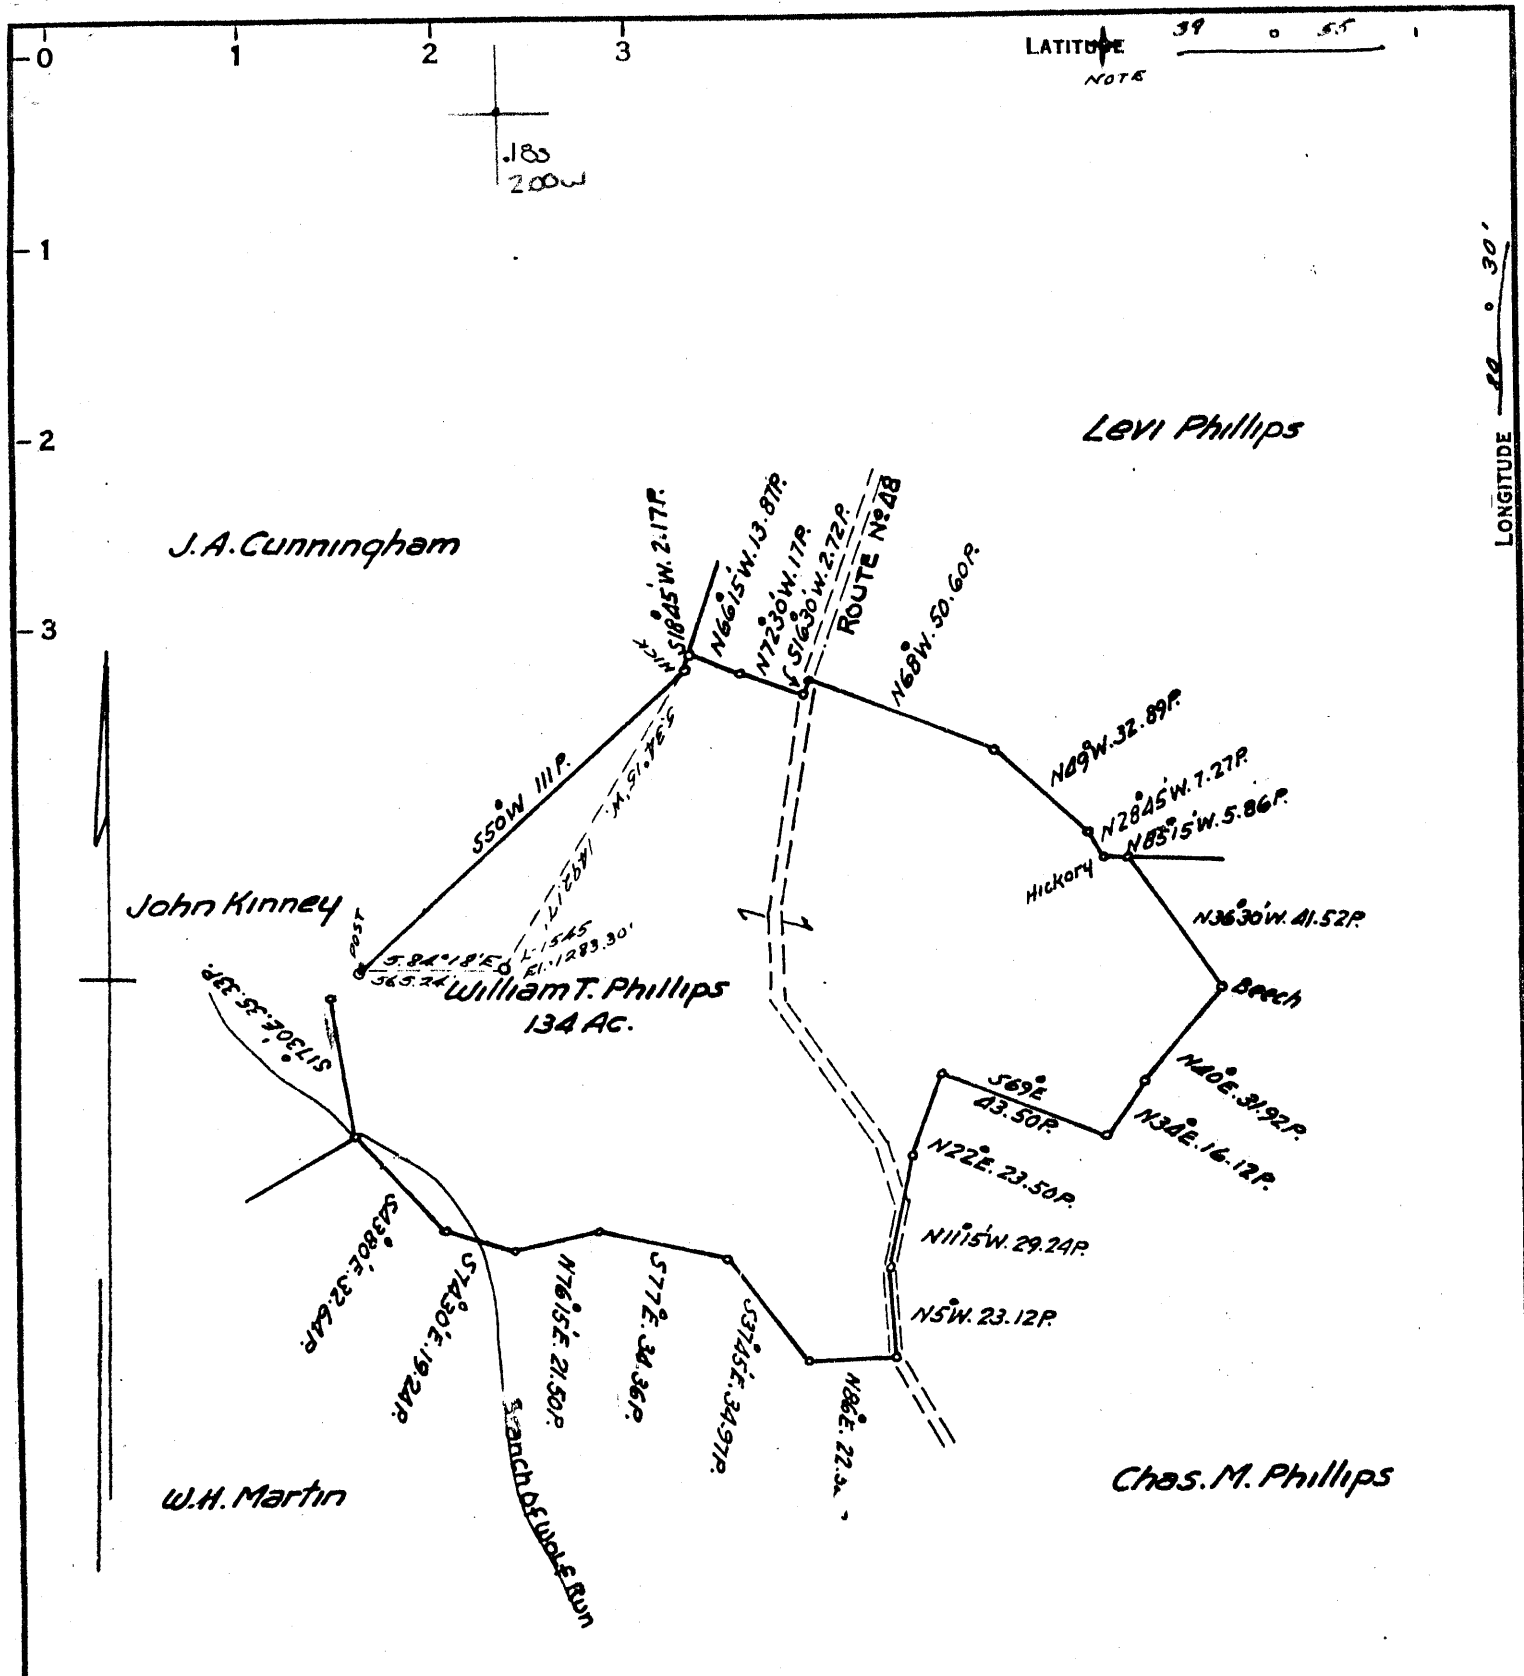

Manor Real Estate Co., PennCentral
~~Emerald Coal & Coke Co.~~

COAL OWNED BY ~~RECORDED~~

NEW LOCATION
 DRILL DEEPER
 ABANDONMENT

issued 8-24-70

0-25-15

COMPANY THE MANUFACTURERS LIGHT & HEAT CO.
 ADDRESS 800 UNION TRUST BLDG. PGH. PA.
 FARM W. T. PHILLIPS
 TRACT _____ ACRES 138 LEASE NO. 27245
 WELL (FARM) NO. 1 SERIAL NO. L-1545
 ELEVATION (SPIRIT LEVEL) 1283.90'
 QUADRANGLE CAMERON FC
 COUNTY MARSHALL DISTRICT WEBSTER
 ENGINEER A. B. Streator M.
 ENGINEER'S REGISTRATION NO. 9442
 FILE NO. _____ DRAWING NO. Y-15-732
 DATE 7 APR. 58 SCALE 1" = 800'

STATE OF WEST VIRGINIA
 DEPARTMENT OF MINES
 OIL AND GAS DIVISION
 CHARLESTON

WELL LOCATION MAP
 FILE NO. MARS-323-REDRILL-P

+ DENOTES LOCATION OF WELL ON UNITED STATES TOPOGRAPHIC MAPS. SCALE 1 TO 62,500. LATITUDE AND LONGITUDE LINES BEING REPRESENTED BY BORDER LINES AS SHOWN.

- DENOTES ONE INCH SPACES ON BORDER LINE OF ORIGINAL TRACING.