


10,400'

LATITUDE 39° 45' 00"

LONGITUDE 80° 40' 00"

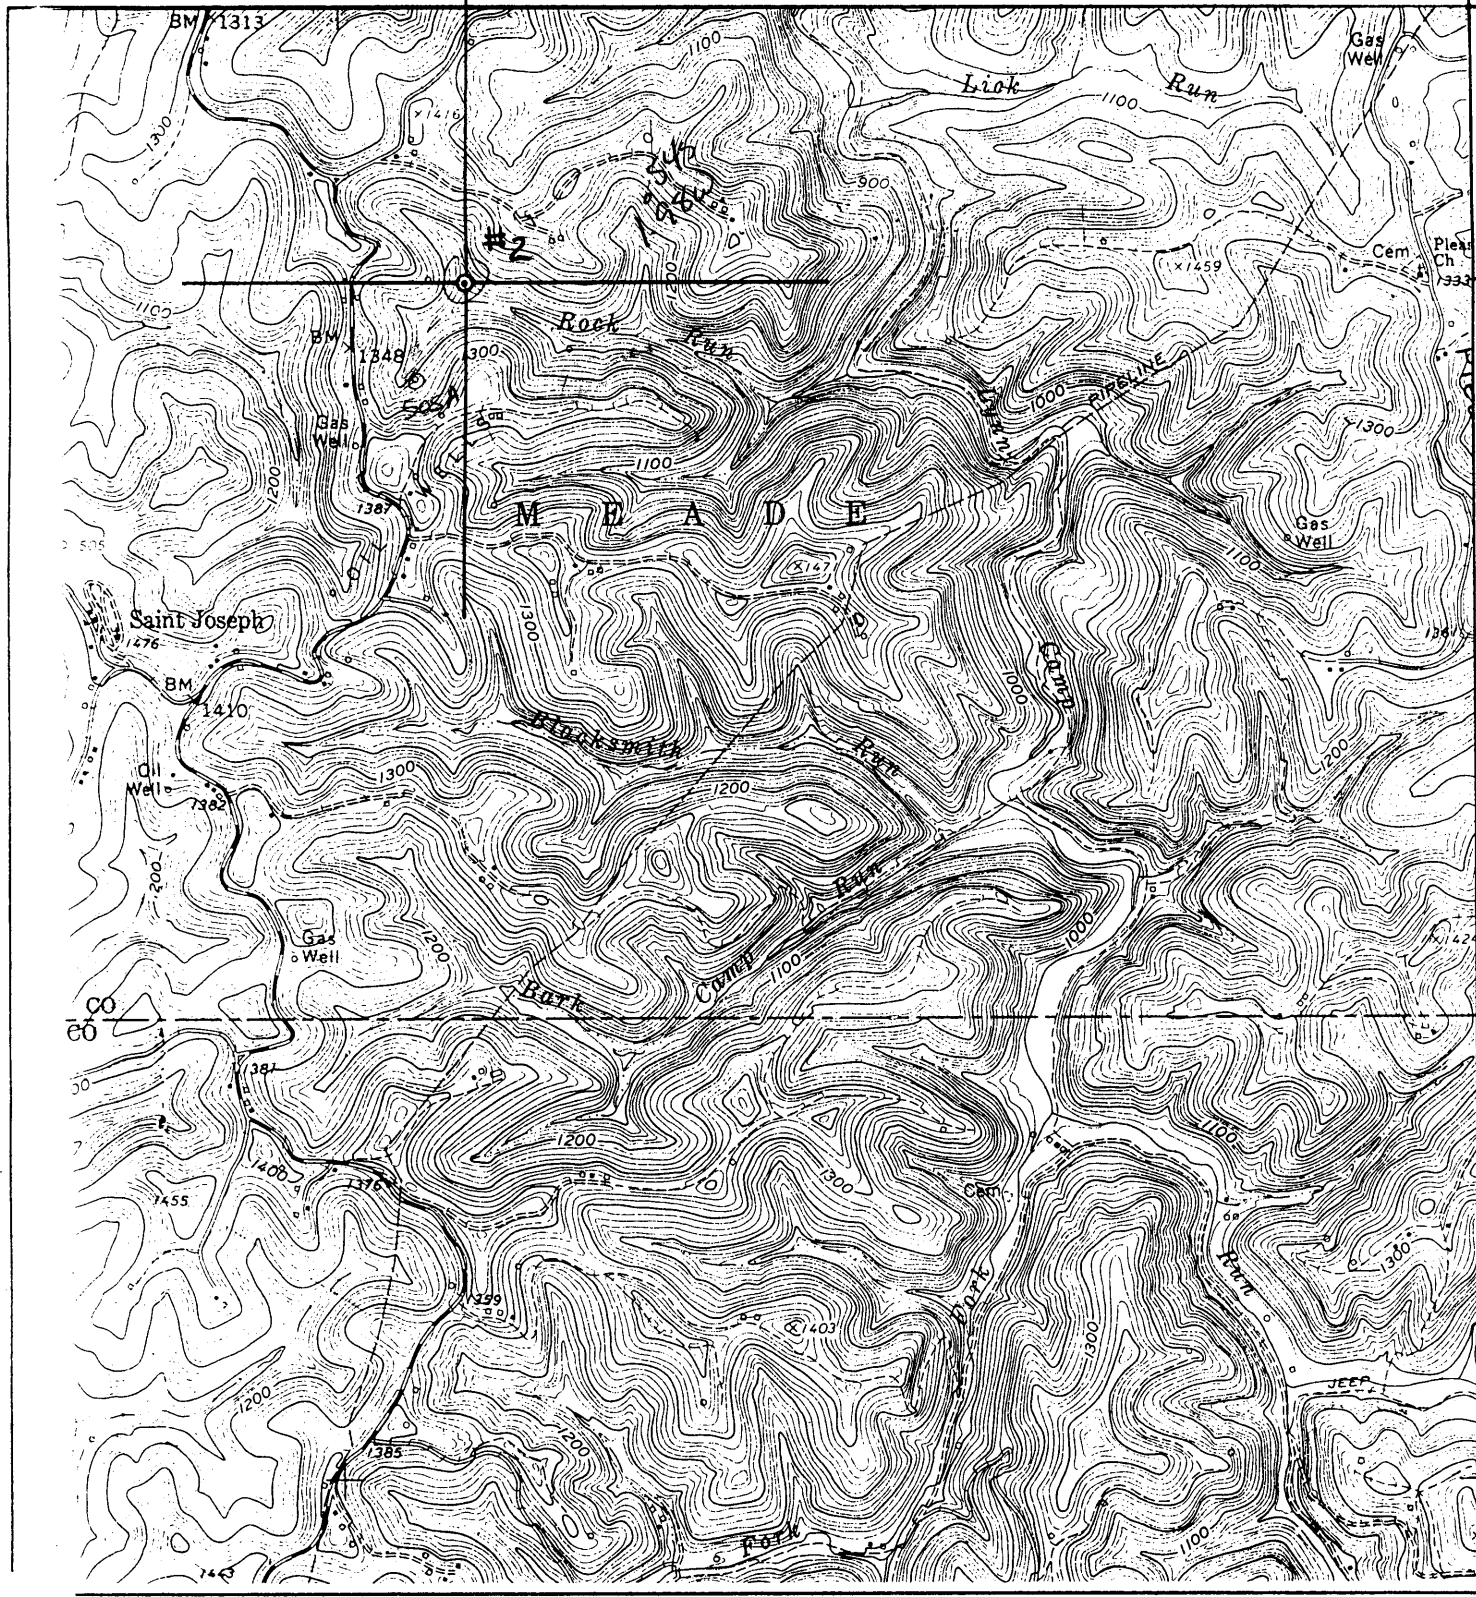

20482

THE UNDERSIGNED, HEREBY CERTIFY THAT THIS PLAT IS CORRECT TO THE BEST OF MY KNOWLEDGE AND BELIEF.


Calc 15' loc
 0.545 SIGNED Deryl Perkins
 1,98W
 TITLE Deryl Perkins - VICE PRESIDENT

STATE OF WEST VIRGINIA
 DIVISION OF ENVIRONMENTAL PROTECTION
 OFFICE OF OIL AND GAS

DATE March 27, 19 95
 FARM Adolph Breiding NO. 2
 API WELL NO.
47-051-0819-N

WELL TYPE: OIL GAS LIQUID INJECTION WASTE DISPOSAL
 (IF "GAS") PRODUCTION STORAGE DEEP SHALLOW
 LOCATION: ELEVATION 1130' Topo WATERSHED Rock Run
 DISTRICT Meade (5) COUNTY Marshall
 QUADRANGLE Wileyville 681 Littleton NW

SURFACE OWNER Unknown ACREAGE ?
 OIL & GAS ROYALTY OWNER Unknown LEASE ACREAGE 40 Ac.
 LEASE NO. _____
 PRODUCING FORMATION Gordon TOTAL DEPTH 2900 +/-
 WELL OPERATOR Perkins Oil & Gas ²⁷⁵⁰⁰ DESIGNATED AGENT Deryl Perkins
 ADDRESS P.O. Box 547 ADDRESS P.O. Box 547

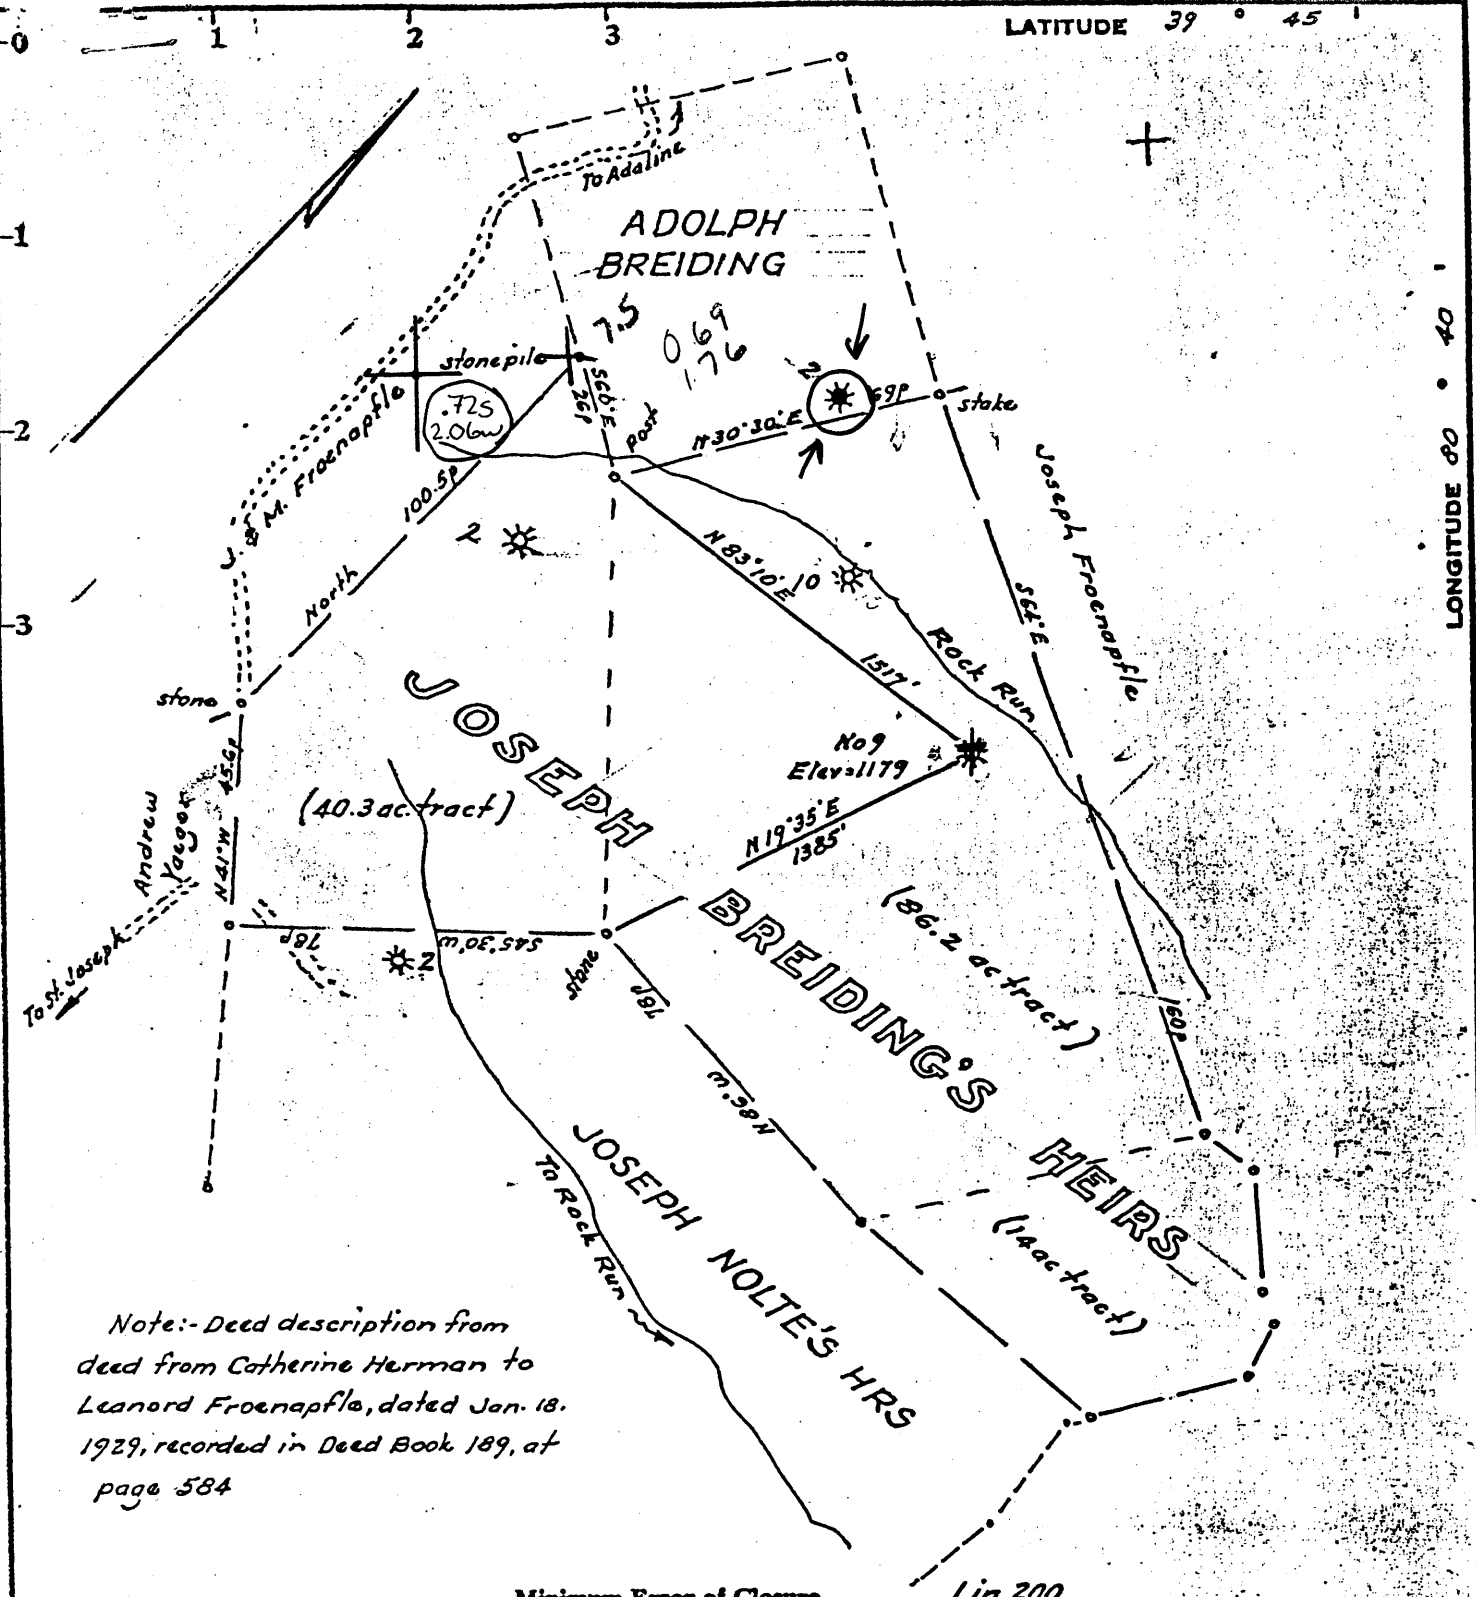

Note:- Deed description from deed from Catherine Herman to Leonard Froenapfle, dated Jan. 18, 1929, recorded in Deed Book 189, at page 584

Minimum Error of Closure 1 in 200
 Source of Elevation Elev. Jas. Nolte's Hrs No 2 = 1241

I, the undersigned, hereby certify that this map is correct to the best of my knowledge and belief and shows all the information required by paragraph 6 of the rules and regulations of the oil and gas section of the mining laws of West Virginia.

- Fracture.....
- New Location.....
- Drill Deeper.....
- Abandonment.....

Signed: Mustard J.
 Squares: N S E W

Map No. _____

Company	CARL PERKINS	3150.0
Address	Route 2, Pennsboro, W. Va.	
Farm	Joseph Breiding's Heirs	
Tract	Acres 144	Lease No. _____
Well (Farm) No.	Nine 2	Serial No. _____
Elevation (Spirit Level)	1179	
Quadrangle	Littleton W. Meyville	7.5
County	Marshall	District Meade
Engineer	<u>Mustard J.</u>	
Engineer's Registration No.	1227	
File No.	Drawing No. _____	
Date	July 30, 1974	Scale _____

STATE OF WEST VIRGINIA
 DEPARTMENT OF MINES
 OIL AND GAS DIVISION
 CHARLESTON

WELL LOCATION MAP

FILE NO. 051 ~~_____~~
70022-819

+ Denotes location of well on United States Topographic Maps, scale 1 to 62,500, latitude and longitude lines being represented by border lines as shown.
 - Denotes one inch spaces on border line of original tracing.

BRIDGING HEIRS NO. 2 WELL.

No. 10 O.F.-Marshall.
Vol. I(a), p. 220.

Heads District, Marshall County, W. Va.
South Penn Oil Co.

(see plat 051 727)
→ ~~NDW~~ 051 819

	Top.	Bottom.
Native coal	625	- 630
Mapletown Coal	845	- 850
Pittsburgh Coal	935	- 945
Salt Sand	1680	- 1800
Big Line	2000	- 2040
Big Injun Sand	2040	- 2350
Stray Sand	2890	- 2895
Gordon Sand	2925	- 2943
Total depth		2949

STATE OF WEST VIRGINIA
DIVISION OF ENVIRONMENTAL PROTECTION
SECTION OF OIL AND GAS

WELL REGISTER ASSIGNMENT

This API Number 47- 51-00819, issued to PERKINS OIL & GAS, INC. is evidence of permission to operate the well that is referenced at the location described on the attached plat, subject to the provisions of Chapters 22 and 22B of the West Virginia Code of 1931, as amended, and all rules and regulations promulgated thereunder. The name and telephone number of the Oil and Gas Inspector for this well is RANDAL MICK -
304-986-3324.

Spills or emergency discharges must be reported to 1-800-654-3312.

Failure to abide by all statutory and regulatory provisions governing all duties and operations hereunder may result in suspension or revocation of your permits and in addition may result in civil and/or criminal penalties.

The enclosed WR-35 must be completed by you and returned to this office. In addition annual production reports must be submitted on this well and failure to do so may require you to plug the well.

Theodore M. Streit
Chief

By: 

Title: _____

Operator's Well No: BREIDING #2

Farm Name: BREIDING, ADOLPH

API Well Number : 47- 51-00819 N

Date Issued : 04/18/95