


LATITUDE 39° 45'

LONGITUDE 80° 05'

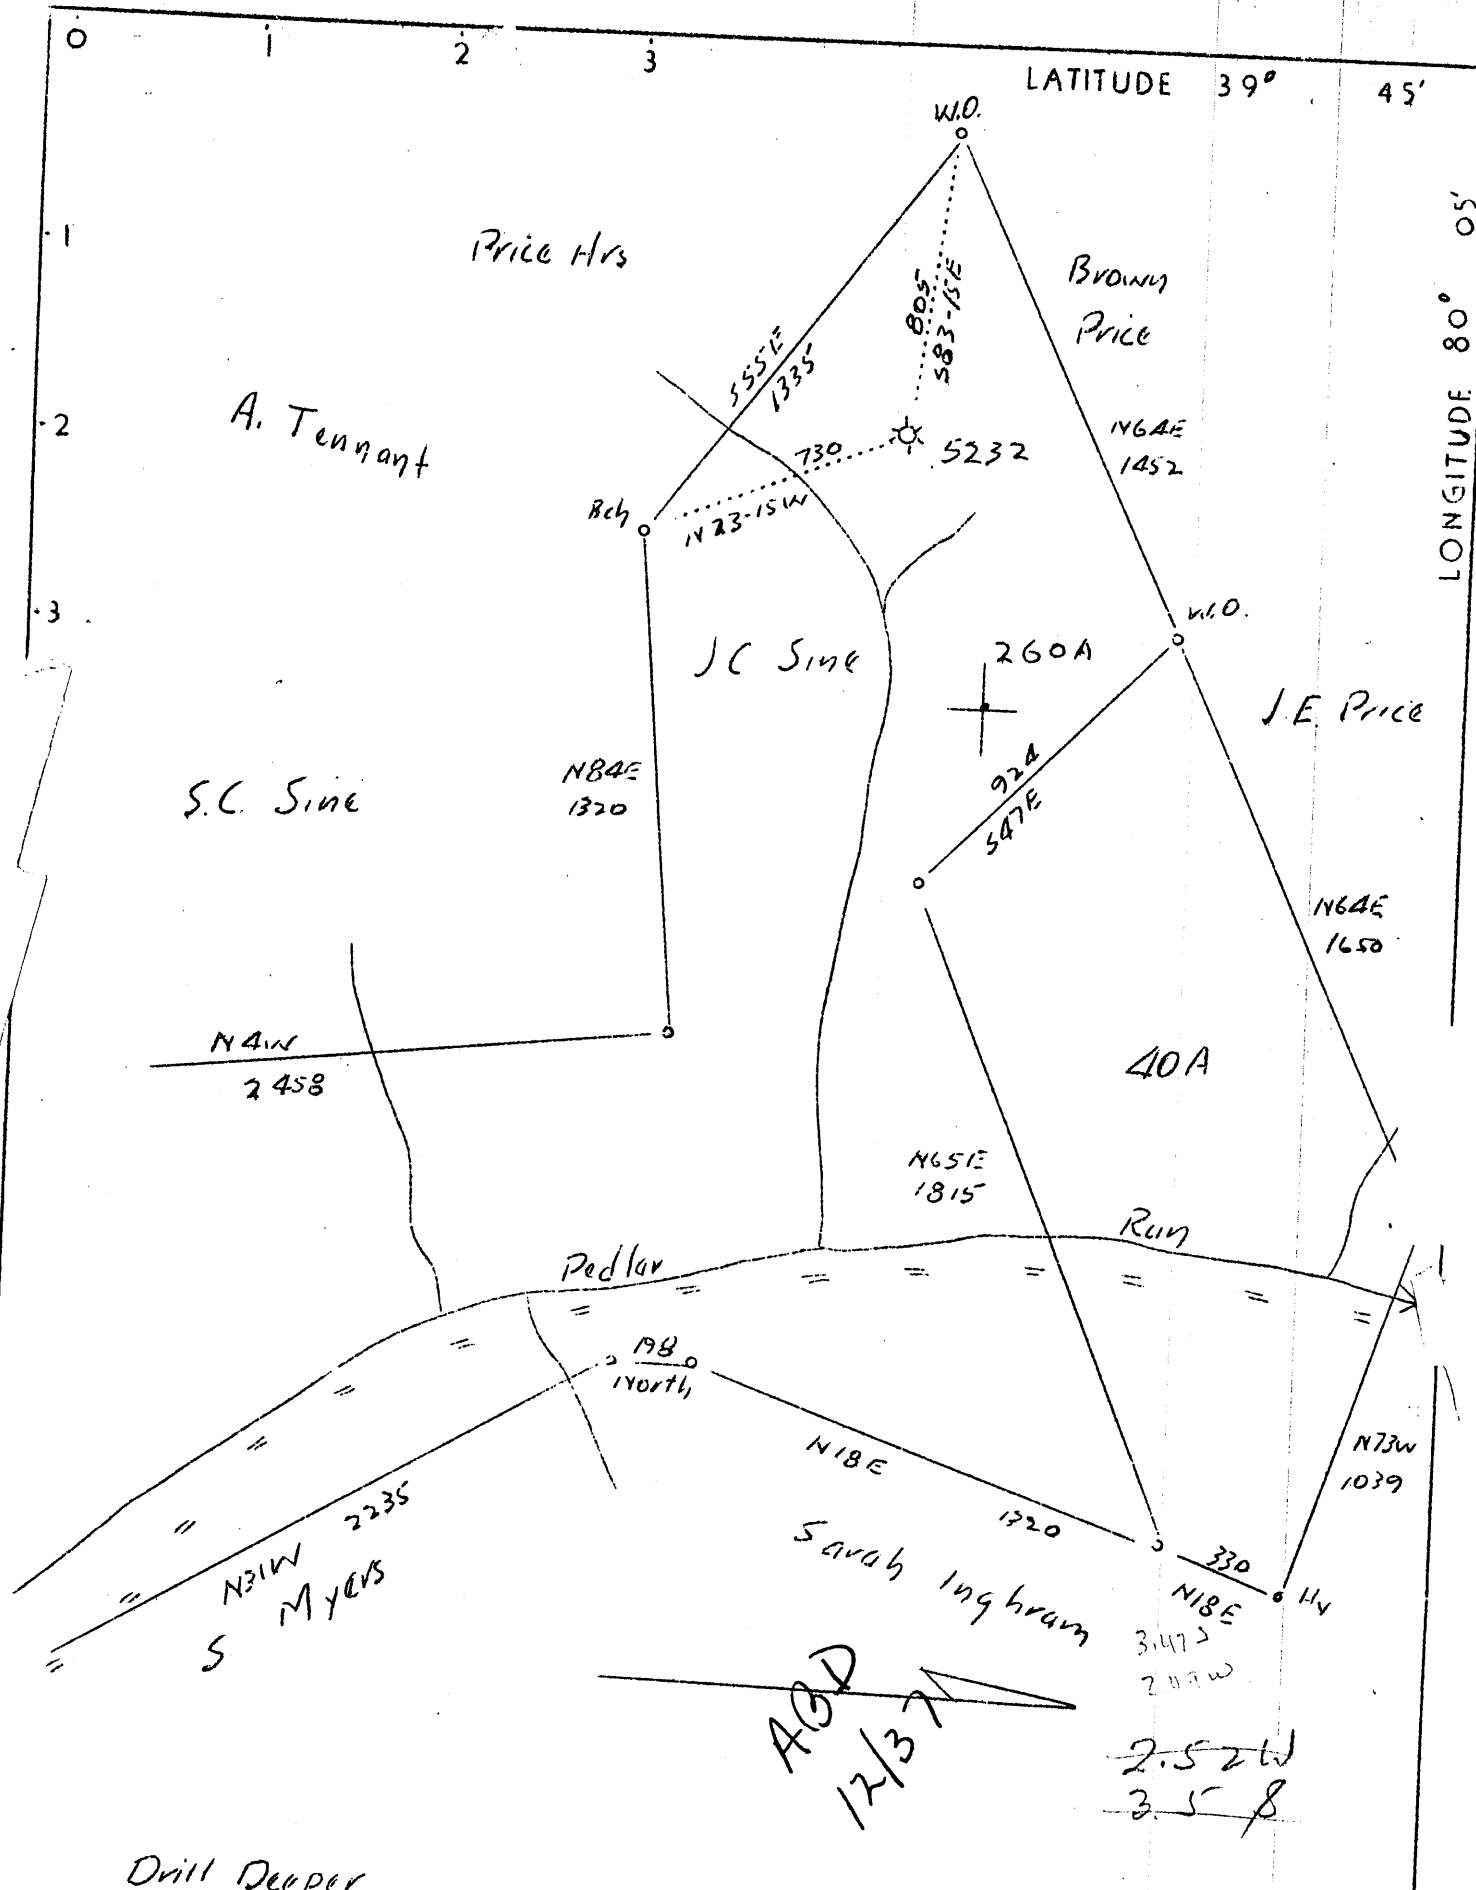

Drill Deeper

Company Pitts. & W. Va. Gas Co.
 Address 608 Union Bank, Clarksburg, W. Va.
 Farm J.C. Sine
 Tract Acres 300 Lease No. 15298
 Well (Farm) No. 1 Serial No. 5232
 Elevation (Spirit Level) 1145L
 Quadrangle Blacksville
 County Monongalia District Clay
 Engineer F.E. Brigden
 Engineer's Registration No. 764
 File Drawing No.

STATE OF WEST VIRGINIA
 Department of Mines
 OIL AND GAS DIVISION
 CHARLESTON

WELL LOCATION MAP
 File No. MON-100

+ Denotes location of well on United States Topographic Maps, scale 1:62,500, latitude and longitude lines being represented by border lines as shown.

note one inch spaces on border