

Company - Monongahela Oil & Gas Co.  
 Address - Granttown, W. Va.  
 Farm - Elias Fox  
 Tract 1 Acres 55 Lease No. 1  
 Well (farm) 1 Serial No. W. Va. 3  
 Quadrangle Wannington N.E.  
 County - Monongalia  
 District - Battelle  
 Engineer - A. S. Hartley  
 Engineer's Registration No. 432  
 File No. 2-102-249 Drawing No. 5287  
 Date July 31, 1940 Scale 1" = 300'

STATE OF WEST VIRGINIA  
 Department of Mines  
 OIL AND GAS DIVISION  
 CHARLESTON

WELL LOCATION MAP  
 File No. MON-122

+ Denotes Location of Well on United States Topographic Maps, scale 1 to 62,500, latitude and longitude lines being represented by border lines as shown.  
 - Denotes one inch spaces on border line of original tracing.

STATE OF WEST VIRGINIA  
DEPARTMENT OF MINES  
OIL AND GAS DIVISION

298

WELL RECORD


Permit No. 122

Oil or Gas Well \_\_\_\_\_  
(KIND)

Company <u>Monongahela Oil &amp; Gas. Co.</u>	Casing and Tubing	Used in Drilling	Left in Well	Packers
Address <u>Morgantown, West Virginia</u>	Size			
Farm <u>Elias Fox</u> Acres <u>55</u>	16			Kind of Packer
Location (waters) <u>Miracle Run</u>	13			
Well No. <u>1</u> Elev. _____	10	<u>395</u>		Size of
District <u>Battelle</u> County <u>Monongalia</u>	8 1/4	<u>1195</u>		Depth set
The surface of tract is owned in fee by <u>Elias Fox and Ida Fox</u> Address <u>Wadestown, W. Va.</u>	6 5/8	<u>2030</u>		Perf. top
Mineral rights are owned by <u>Elias Fox and Ida Fox</u> Address _____	5 3/16			Perf. bottom
Drilling commenced <u>July 22, 1940</u>	3			Perf. top
Drilling completed <u>September 30, 1940</u>	2			Perf. bottom
Date shot <u>October 7</u> Depth of shot <u>3273</u>	Liners Used			Perf. top
Open Flow - /10ths Water in _____ Inch				Perf. bottom
Volume _____ Cu. Ft.				
Rock Pressure _____ lbs. _____ hrs.				
Oil _____ bbls., 1st 24 hrs.				
Fresh water _____ feet _____ feet				
Salt water <u>1960</u> feet _____ feet				

CASING CEMENTED NO SIZE \_\_\_\_\_ No. Ft. \_\_\_\_\_ Date \_\_\_\_\_  
COAL WAS ENCOUNTERED AT 1025 FEET \_\_\_\_\_ INCHES  
\_\_\_\_\_ FEET \_\_\_\_\_ INCHES 900 FEET \_\_\_\_\_ INCHES  
\_\_\_\_\_ FEET \_\_\_\_\_ INCHES 640 FEET \_\_\_\_\_ INCHES

Formation	Color	Hard or Soft	Top	Bottom	Oil, Gas or Water	Depth Found	Remarks
✓ Wbg Coal			640	643			
✓ M M Coal			900	904			
✓ Pbh Coal			1025	1034			
M Sand		Soft	1159	1179			
✓ L Dunkard		Soft	1330	1355			
✓ B. Dunkard		Soft	1520	1627			
✓ Gas Sand		Soft	1778	1798			
1st Salt Sand		Broken and shells					
2nd Salt sand) Hole		Hard	1920	2025			
3rd Salt Sand) full of water							
✓ L. Lime		Hard	2179	2193			
✓ Pencil Cave			2193	2197			
✓ B. Lime		Hard	2197	2281			
✓ Injun Sand	371	Hard	2281	2491			
Upper 30 and 50 feet			2831	2897			
30 feet		Hard	2959	3016			
Gordon stray		Hard	3150	3162			
Gordon		Hard	3198	3220			
4 Sand		Hard	3256	3286			
(5 Sand )							
(Byard )			3500	3560			
(Elizabeth)							
			<b>Total Depth</b>	<b>3560</b>			

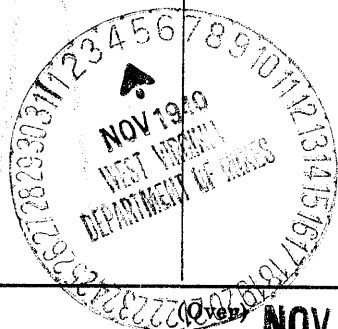

NOV 19 1940