

Latitude

Longitude

2.33s
1.62w

Topo Location


7.5' Loc. _____ 15' Loc. _____
 (calc.) _____

Company Roy W Clovis
 Farm C E Moore #2
 15' Quad _____
 (sec.)
 7.5' Quad Blacksville
 District Clay

WELL LOCATION PLAT

County 061 Permit 129

Peter Chalfant

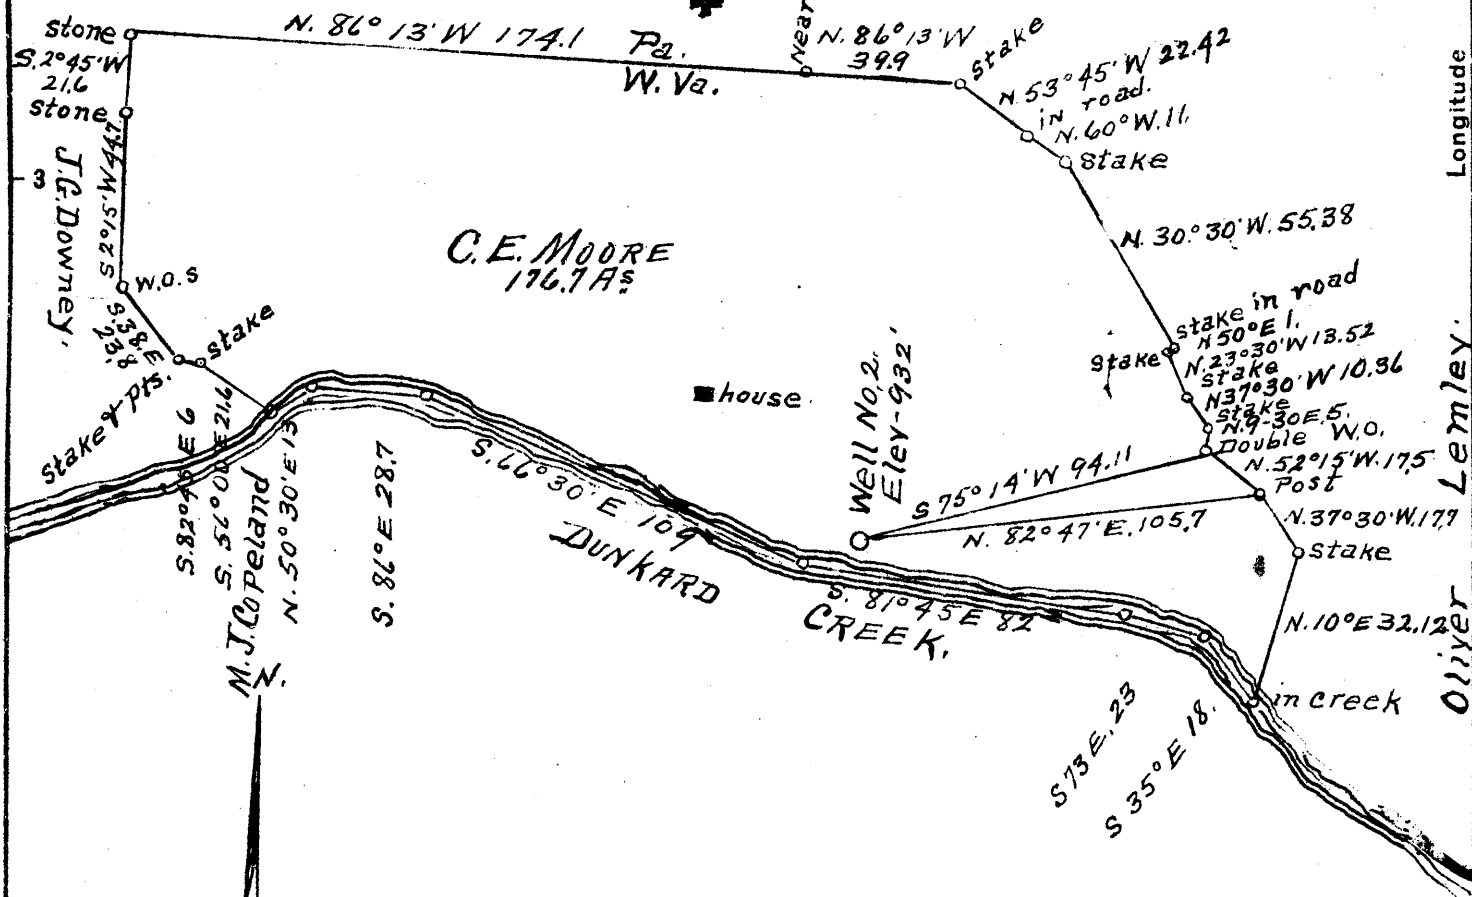

- New Location.
- Drill Deeper.
- Abandonment.

COAL NOT OPERATED.

~~W - 4.1~~
 W - 3.93
~~S - 2.9~~
 E - 2.25

Company Roy W. Clovis.
 Address Waynesburg Pa.
 Farm C. E. MOORE
 Tract ONE Acres 176+ Lease No. _____
 Well (Farm) No. TWO Serial No. _____
 Elevation (Spirit Level) 932'
 Quadrangle Blacksville
 County Monongalia District Clay
 Engineer A. L. Headley
 Engineer's Registration No. _____
 File No. _____ Drawing No. _____
 Date 4-12-1941 Scale One inch = 50 poles

STATE OF WEST VIRGINIA
 DEPARTMENT OF MINES
 OIL AND GAS DIVISION
 CHARLESTON

WELL LOCATION MAP
 FILE NO. MON-129

+ Denotes location of well on United States Topographic Maps, scale 1 to 62,500, latitude and longitude lines being represented by border lines as shown.
 - Denotes one inch spaces on border line of original tracing.

WEST VIRGINIA DEPARTMENT OF MINES
OIL & GAS DIVISION
WELL RECORD

Permit No. Mon-129
Blacksville Quad.

Dry Hole

Company Roy W. Clovis
Address Waynesburg, Pa.
Farm C. E. Moore ACRES 1767
Location Dunkard
Well No. 2 ELEV. 932
District Clay - Monongalia County
Surface & Mineral C. E. Moore, Morgantown, W. Va.
Commenced April 29, 1941
Completed May 20, 1941
Volume Dry Hole
Fresh Water 55 and 140

CASING & TUBING
10 26
8-1/4 200*8"
6-5/8 555

Coal at: 181, 439 & 523

Soil	yl	s	0	25	Slate	lt	m	911	953	
Mud	bl	s	25	30	Sand	lt	m	953	971	-L. Dunkard
Lime	gr	m	30	35	Slate	dk	m	971	1150	LF Dunkard
Slate	bl	s	35	40	Sand	gr	h	1150	1188	
Lime	gr	h	40	70	Slate	dk	s	1188	1198	
Slate	bl	s	70	90	Lime	gr	h	1198	1200	
Lime	gr	m	90	100	Slate	drk	s	1200	1203	
Slate	dk	s	100	115	Lime	dk	h	1203	1223	
Lime	gr	h	115	125	Sand	lt	h	1223	1246	Little
Sand	wh	m	125	165						Water 1246
Slate	dk	s	165	175						1/2 blr.
Lime	gr	h	175	187	Slate	dk	s	1246	1271	
Coal	bk	s	187	191	Total Depth				1271	
Slate	dk	s	191	200						
Lime	lt	h	200	239						
Slate	dk	s	239	277						
Lime	gr	m	277	334						
Slate	dk	m	334	344						
Lime	gr	m	344	350						
Slate	lt	m	350	362						
Lime	gr	m	362	390						
Slate	gr	m	390	398						
Lime	gr	m	398	406						
Slate	gr	m	406	424						
Lime	gr	m	424	433						
Slate	dk	s	433	439						
Coal	bk	s	439	445						
Slate	dk	s	445	451						
Lime	gr	h	451	496						
Slate&Lime	gr	m	496	510						
Slate	bl	s	510	523						
Coal	bk	s	523	529	HFV					
Slate	dk	s	529	540						
Lime	gr	m	540	545						
Slate	dk	s	545	565						
Lime	gr	m	565	590						
Slate	lt	m	590	615						
Lime	dk	h	615	618						
Slate	dk	s	618	636						
Sand	gr	m	636	652						
Slate	dk	s	652	663						
Sand	gr	m	663	681						
Slate	bl	s	681	705	Some water					
Sand	gr	m	705	758	Show of gas - not enough to test					Murphy
Slate	bl	s	758	772						
Lime	gr	m	772	791						
Mud	bl	s	791	810						
Red Rock	rd	s	810	835						
Slate	bl	s	835	854						
Lime	gr	h	854	868						
Slate	gr	h	868	908						
Lime	dk	h	908	911						