

Latitude

1.73s
1.53w

Longitude

Topo Location

7.5' Loc. _____ 15' Loc. _____
(calc.) _____

Company Roy Clavis

Farm CH Hasker #2


15' Quad _____
(sec.)

7.5' Quad Blacksville

District Clay

WELL LOCATION PLAT

County Clay Permit 148

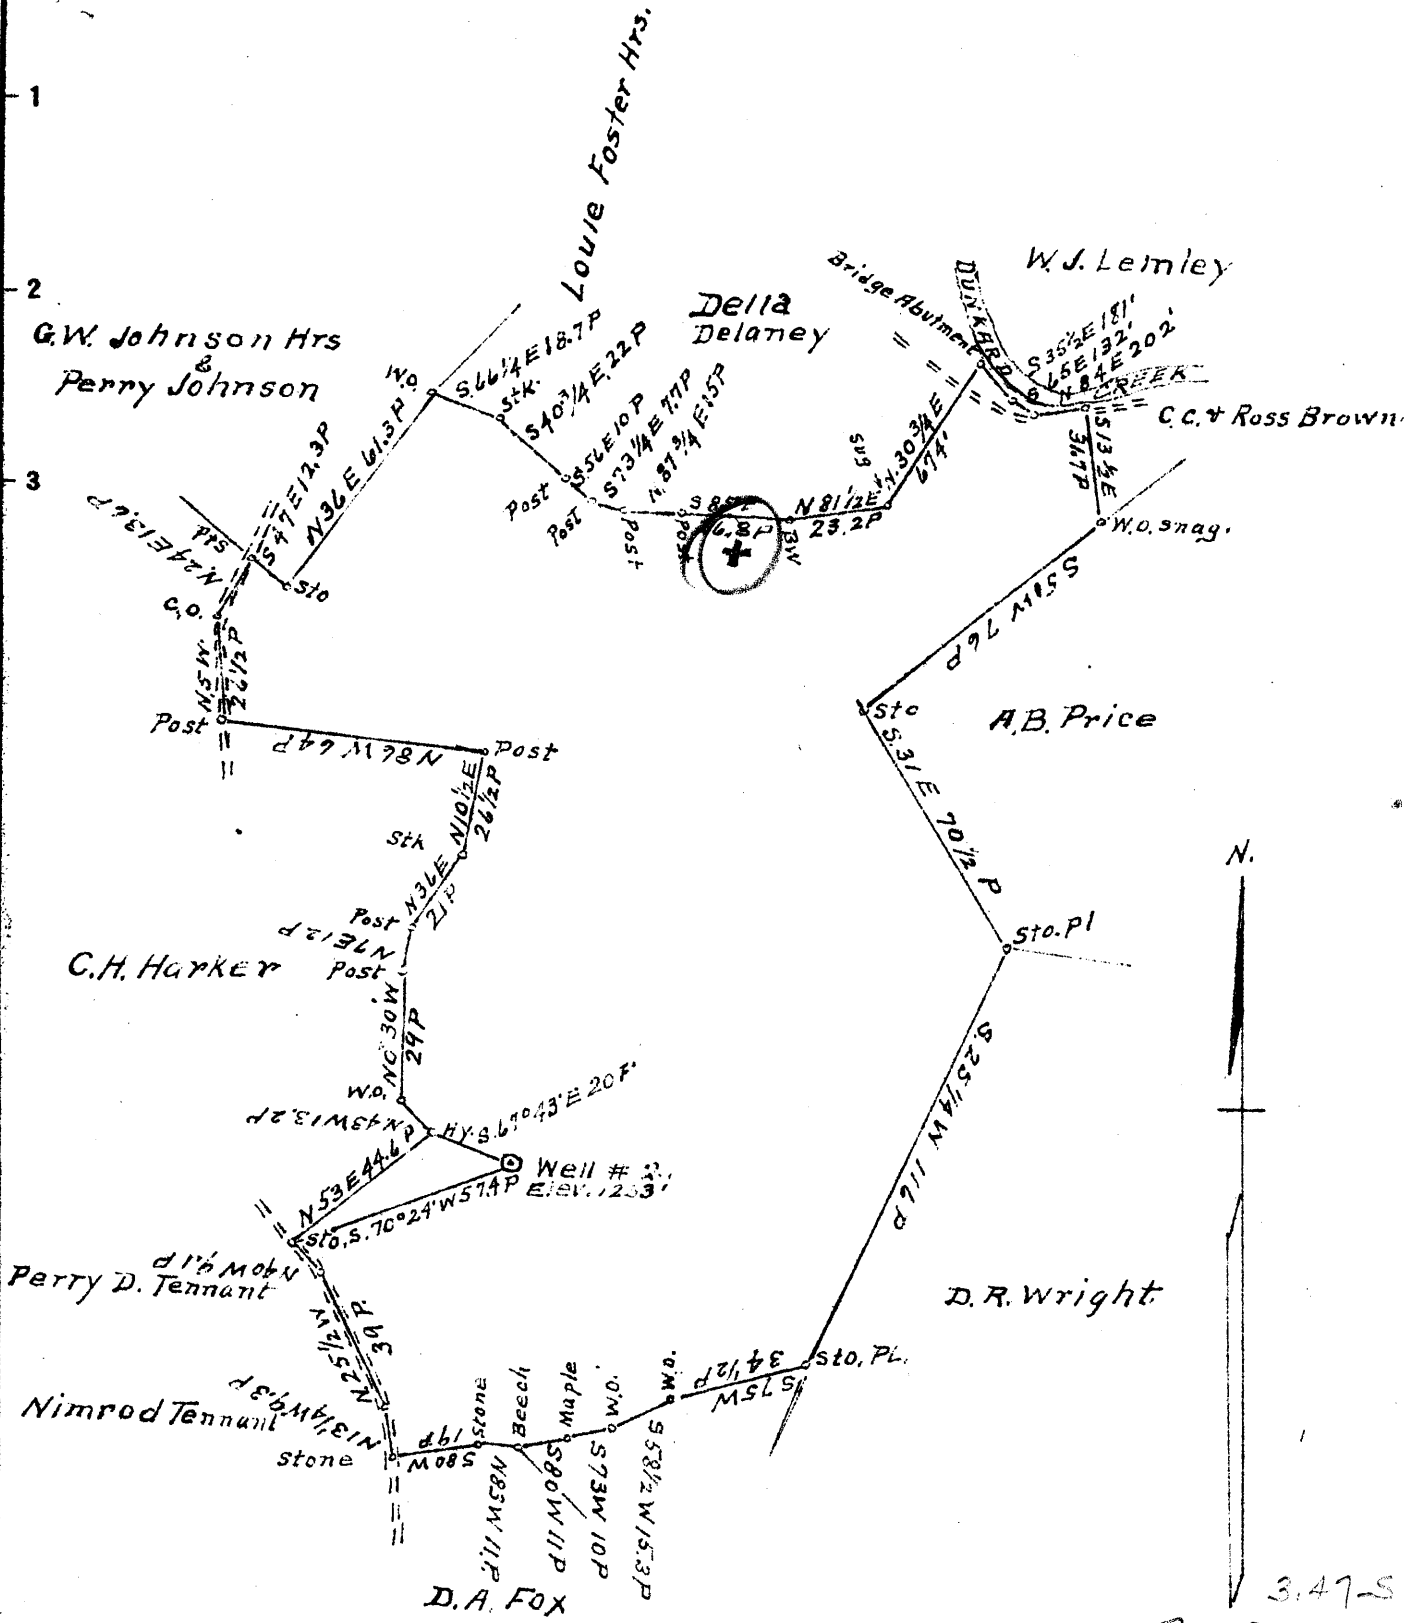

New Location X
 Drill Deeper
 Abandonment

Company Roy W. Clovis
 Address Waynesburg, Pa.
 Farm C.H. Harker
 Tract _____ Acres 204 1/4 Lease No. _____
 Well (Farm) No. Two Serial No. _____
 Elevation (Spirit Level) 1233'
 Quadrangle Blacksville
 County Monongalia District Clay
 Engineer A.L. Headley
 Engineer's Registration No. _____
 File No. _____ Drawing No. _____
 Date 7-8-1942 Scale 1 IN = 800'

STATE OF WEST VIRGINIA
 DEPARTMENT OF MINES
 OIL AND GAS DIVISION
 CHARLESTON

WELL LOCATION MAP
 FILE NO. Mon 148

+ Denotes location of well on United States Topographic Maps, scale 1 to 62,500, latitude and longitude lines being represented by border lines as shown.

- Denotes one inch spaces on border line of original tracing.

WEST VIRGINIA DEPARTMENT OF MINES
OIL & GAS DIVISION
WELL RECORD

Permit No. Mon 148
Blacksville Quad.
Company
Address
Farm
Location
Well No
District
Surface
Mineral
Commenced
Completed
Flow
Fresh Water

Roy W. Clovis
Waynesburg, Pa.
C.H. Harker Acres 209
Dunkard
2 Elev. 1233
Clay Monongalia County
C.H. Harker, Core, W.Va.
Same
July 30, 1942
Sept. 3, 1942
None
115' HFW

Dry Hole
CASING & TUBING

8 1/2 501 -
6 5/8 845' 845'

Coal at 730'; 814'

Soil	Dk	S	0	24	Lime	Wh	H	925	938
Red Rock		S	24	34	Sand	Lt	H	938	960
Lime	Gr	M	34	44	Slate	Lt	S	960	972
Slate	Gr	S	44	82	R.Rock		S	972	975
Lime	Gr	H	82	96	Lime	Dk	M	975	1046
Slate	Bl	S	96	134	Slate	Bl	S	1046	1058
R.Rock		S	134	140	Lime	Gr	M	1058	1080
Slate	Bl	S	140	155	R.Rock		S	1080	1084
Lime	Gr	H	155	165	Slate	Wh	S	1084	1100
Slate	Gr	S	165	173	R.Rock		S	1100	1143
Lime	Gr	H	173	177	Slate	Bl	S	1143	1163
Slate	Gr	S	177	188	Lime	Gr	H	1163	1188
R. Rock		S	188	190	Slate	Bl	S	1188	1290
Slate	Bl	S	190	200	Lime	Gr	M	1290	1320
R.Rock		S	200	205	Sand	Lt	M	1320	1356 <i>Dunkard</i>
Slate	Bl	S	205	235	Slate	Dk	S	1356	1378
Sand	Gr	M	235	240	Lime	Gr	H	1378	1407
Slate	Bl	S	240	282	Slate	Gr	S	1407	1437
Lime	Gr	H	282	292	Lime	Gr	H	1437	1447
Slate	Gr	S	292	301	Slate	Dk	S	1447	1480
Slate	Bk	S	301	323	Lime	Lt	H	1480	1485
Slate Shells	Gr	M	323	352	Sand	Lt	H	1485	1525 <i>Gas?</i>
Lime	Gr	H	352	400	Slate	Dk	S	1525	
Slate	Dk	S	400	409	TOTAL DEPTH				1530
Lime	Gr	H	409	422					
Sand	Gr	H	422	447					
Slate	Dk	S	447	494					
Lime	Gr	H	494	530					
Slate	Gr	S	530	560					
Lime	Gr	H	560	576					
Slate	Dk	S	576	581					
Lime	Gr	H	581	592					
Slate	Bl	S	592	606					
Lime	Gr	H	606	632					
Slate	Bl	S	632	637					
Lime	Gr	H	637	649					
Slate	Gr	S	649	655					
Lime	Gr	H	655	680					
Slate	Gr	S	680	695					
Sand	Gr	M	695	713					
Slate	Bl	S	713	720					
Lime	Gr	H	720	724					
Slate	Dk	S	724	730					
Coal	Dk	S	730	736	4 blrs. water			736	
Lime	Gr	H	736	812					
Slate	Dk	S	812	814					
Coal <i>Page?</i>	Bk	S	814	820	HFW			820	
Slate	Dk	S	820	827					
Lime	Gr	M	827	833					
Slate	Lt	S	833	840					
Lime	Gr	H	840	895					
Slate	Gr	S	895	900					
R.Rock		S	900	912					
Slate	Lt	S	912	925					