


39° 45'
80° 15'

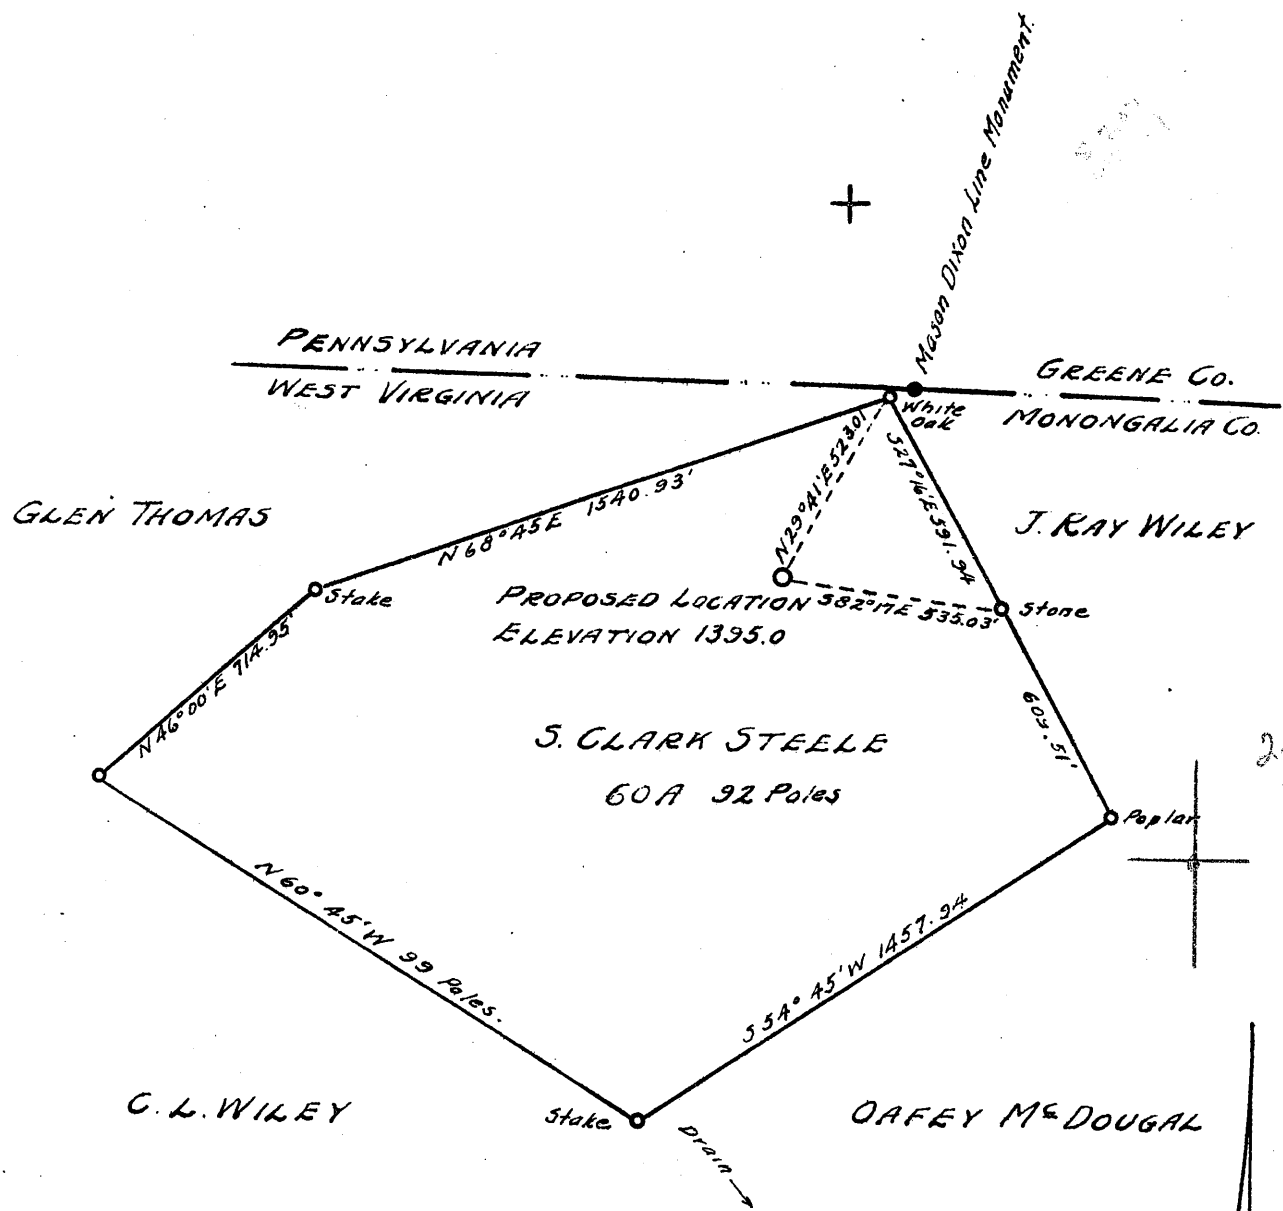

Company H. D. FREELAND
 Address WAYNESBURG, PA.
 Form S. CLARK STEELE
 Tract 1 Acres 60.92 P. Lease No. _____
 Well (Farm No.) 104 Serial No. _____
 Quadrangle MANNINGTON
 County MONONGALIA
 District BATTELLE
 Engineer Paul H. Jones
 Engineer's Registration No. 380
 State 2-190-163 Drawing No. 5995
 Date Aug. 4, 1943 Scale 1 inch = 500'

STATE OF WEST VIRGINIA
 DEPARTMENT OF MINES
 SURVEYING DIVISION
 CHARLESTON

WELL LOCATION MAP
 FILE NO. MON-161

+ Denotes location of well on United States Topographic Maps, scale 1" to 62,500, Latitude and Longitude being represented by bearing lines as shown.

- Verster C. S. Co. Surveyors