


New Location   
 One Deeper   
 Abandonment

Company CWENS ILLINOIS GLASS CO. GAS DEPT.  
 Address BOX 211 CHARLESTON 28, W. VA.  
 Farm J. N. EDDY  
 Tract \_\_\_\_\_ Acres 61 Lease No. 131  
 Well (Farm) No. 2 Serial No. 151  
 Elevation (Spirit Level) 1178.45  
 Quadrangle BLACKSVILLE SC  
 County MONONGALIA District GRANT  
 Engineer T. S. Flournoy  
 Engineer's Registration No. 269  
 File No. \_\_\_\_\_ Drawing No. \_\_\_\_\_  
 Date 6-30-44 Scale 1" = 500 FT.

STATE OF WEST VIRGINIA  
 DEPARTMENT OF MINES  
 OIL AND GAS DIVISION  
 CHARLESTON

WELL LOCATION MAP  
 FILE NO. MON-172

WGS 061-30538  
 + Denotes location of well on United States Topographic Maps, scale 1 to 62,500, latitude and longitude lines being represented by border lines as shown.  
 - Denotes one inch spaces on border line of original tracing.

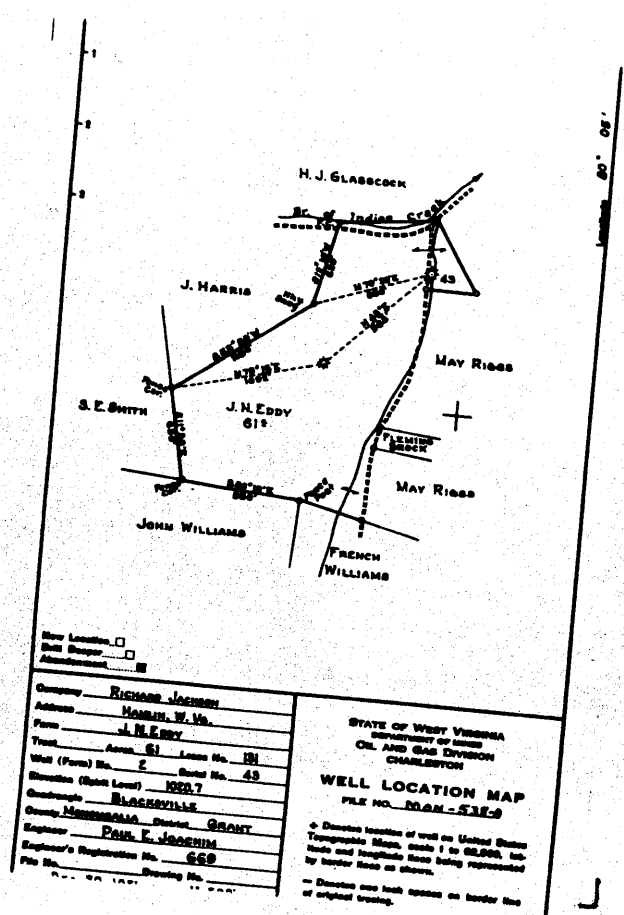

WEST VIRGINIA DEPARTMENT OF MINES  
OIL & GAS DIVISION  
WELL RECORD

Permit No. Mon 172  
Blacksville Quad.

Company  
Address  
Farm

The Owens-Illinois Glass Co. Gas Dept.  
P.O. Box 2111, Charleston 28, W.Va.  
J.N. Eddy #2 Acres 61

Location

Well No.

151 Elev. 478.45  
Grant Monongalia County

Gas Well  
CASING & TUBING  
Tubed 12-22-44 Test  
61 M

District

Surface

Mineral

Commenced

Nov. 6, 1944

Completed

Dec. 22, 1944

Open flow

19/10ths W in 1 1/2"

Volume

77 M.F.

Coal at 385' 120"

Fresh Water

60' 5 bail hr.

482' 60"

Salt Water

1440' show

Clay	Y	S	0	20 Sand	Gr	H	1095	1101
Slate	Dk	S	20	28 Slate	Gr	S	1101	1105
Lime	Gr	H	28	32 Lime	Gr	M	1105	1133
Sand	Gr	H	32	65 Sand	Gr	M	1133	1184
Slate	Dk	S	65	96 Slate	Dk	S	1184	1214
Lime	Wh	H	96	111 Sand	Gr	H	1214	1223
Sand	Gr	H	111	137 Slate & Shells	Dk	M	1223	1242
Slate	Gr	S	137	147 Lime	Gr	M	1242	1262
Lime	Gr	H	147	167 Slate	Bk	S	1262	1277
Slate	Gr	S	167	178 Lime	Gr	H	1277	1291
Lime	Gr	H	178	187 Sand	Gr	H	1291	1341
Slate	Dk	S	187	192 Sl & Sd. Shells	Gr	M	1341	1378
Lime	Gr	H	192	209 Slate	Dk	S	1378	1403
Lime-Slate	Gr	M	209	229 Lime	Gr	M	1403	1409
Lime	Gr	H	229	244 Sand	Gr	H	1409	1478
Slate	Gr	S	244	256 Slate	Gr	S	1478	1481
Lime	Gr	H	256	356 Sand	Gr	H	1481	1511
Sand	Gr	M	356	385 Slate & Shells	Gr	M	1511	1533
Coal	Bk	S	385	395 Gritty Lime	Gr	H	1533	1543
Lime	Gr	H	395	409 Slate	Gr	S	1543	1575
Slate	Gr	S	409	416 Lime & Slate	Dk	M	1575	1612
Lime	Gr	H	416	478 Slate & Lm. Shells	M		1612	1647
Slate	Dk	S	478	482 Sand	Wh	H	1647	1671
Coal	Bk	S	482	487 Red Rock & Lime Shells				
Slate	Gr	S	487	497	Red	M	1671	1699
Lime	Gr	H	497	511 Slate & Lm. Shells	Gr	M	1699	1721
Slate	Gr	S	511	515 Lime	Gr	H	1721	1730
Lime	Gr	H	515	527 Slate	Gr	S	1730	1747
Slate	Gr	S	527	547 Lime	Gr	H	1747	1771
Slate & Lime	Gr	H	547	585 Slate	Dk	S	1771	1775
Slate	Gr	S	585	600 Lime	Gr	H	1775	1794
Sand	Wh	M	600	630 Lime	Gr	H	1794	1834
Slate	Gr	S	630	634 Sand	Gr	H	1834	1848
Lime	Gr	H	634	639 Sand	Gr	S	1848	1850
Slate	Dk	S	639	667 Sand	Gr	H	1850	1868
Sand	Gr	H	667	695 Sand	Gr	M	1868	1873
Slate	Gr	S	695	705 Sand	Gr	H	1873	1912
Lime	Gr	H	705	724 Sand	Wh	M	1912	1934
Sand	Gr	M	724	780 TOTAL DEPTH				1934
Slate	Gr	S	780	820				
Red Rock		S	820	825 Gas	1853	40 M		
Lime	Gr	H	825	866 Gas	1868-1873			
Slate	Gr	S	866	878 Gas	1921-1926			
Lime	Gr	H	878	890				
Slate	Gr	S	890	896				
Lime	Gr	H	896	901				
Sand	Gr	H	901	914 L. Dunkard				
Slate	Gr	S	914	929				
Red Rock		S	929	934				
Lime	Gr	M	934	975				
Slate	Dk	S	975	983				
Lime Sh. & Slate	Dk	H	983	1015				
Slate & Shells	Gr	S	1015	1055				
Sand	Gr	H	1055	1060	Upper Freeport ss Mahoning?			
Slate	Dk	S	1060	1095				





STATE OF WEST VIRGINIA  
DEPARTMENT OF MINES  
OIL AND GAS DIVISION

576

WELL RECORD

Permit No. MON-538-A


Oil or Gas Well (KIND)

Company Wilhelm & Jackson  
Address Hamlin, West Virginia  
Farm J. N. Eddy Acres 61  
Location (waters) Tr. of Indian Creek  
Well No. 2 Elev. 1020.7'  
District Grant County Monongalia  
The surface of tract is owned in fee by \_\_\_\_\_  
Address \_\_\_\_\_  
Mineral rights are owned by \_\_\_\_\_  
Address \_\_\_\_\_  
Drilling commenced \_\_\_\_\_  
Drilling completed May 30, 1923  
Date Shot From \_\_\_\_\_ To \_\_\_\_\_  
With \_\_\_\_\_  
Open Flow /10ths Water in \_\_\_\_\_ Inch  
/10ths Merc. in \_\_\_\_\_ Inch  
Volume \_\_\_\_\_ Cu. Ft.  
Rock Pressure \_\_\_\_\_ lbs. \_\_\_\_\_ hrs.  
Oil \_\_\_\_\_ bbls., 1st 24 hrs.  
Fresh water \_\_\_\_\_ feet \_\_\_\_\_ feet  
Salt water \_\_\_\_\_ feet \_\_\_\_\_ feet

Casing and Tubing	Used in Drilling	Left in Well	Packers
Size			Kind of Packer
16			
18	16'	16'	
10	368'	368'	Size of
8 1/4	1126'	pulled	
6 1/2	1610'	1610'	Depth set
5 3/16			
3			Perf. top
2	2192'	2192'	Perf. bottom
Liners Used			Perf. top
			Perf. bottom

CASING CEMENTED \_\_\_\_\_ SIZE \_\_\_\_\_ No. Ft. \_\_\_\_\_ Date \_\_\_\_\_  
COAL WAS ENCOUNTERED AT \_\_\_\_\_ FEET \_\_\_\_\_ INCHES  
\_\_\_\_\_ FEET \_\_\_\_\_ INCHES \_\_\_\_\_ FEET \_\_\_\_\_ INCHES  
\_\_\_\_\_ FEET \_\_\_\_\_ INCHES \_\_\_\_\_ FEET \_\_\_\_\_ INCHES

Formation	Color	Hard or Soft	Top	Bottom	Oil, Gas or Water	Depth Found	Remarks
Surface	Gravel		0	8			
Line, slate			8	105			hole full of water 40'
Hard Line			105	232			
Mapletown Coal			232	237			
Hard Line			237	314			
Fitts urg. Coal			314	318			
Slate, lime shells and Red Rock			318	507			Cemented from 264'-368' - 40 sacks cement and 80 sacks of sand
Slate & shells			507	680			
Little Dunkard Sand			680	715			
Slate, shells and red rock			715	785			
Big Dunkard			785	830			
Slate and shells			830	970			
Gas Sand			970	1052			
Slate & shells			1052	1123			
First Salt Sand			1123	1195			
Line and shells			1195	1237			
Second Salt Sand			1237	1348			
Black shale, Red Rock & slate			1348	1482			
Hard Line			1482	1490			
Slate & shells			1490	1573			
Little Line			1573	1588			
Pencil Cave			1588	1592			
Big Line			1592	1659			
Big Injun Sand			1659	1790			Gas 1754-1758' - 39%
Slate & shells			1790	1880'			Gas 1778'-1781' - 73%
Korea Sand			1880	1927			
Slate & shells			1927	2150			
Gants Sand			2150	2195			
Slate			2195	2207			Gas 2178-2181 - 73%
Fifty-Foot Sand (hard)			2207	2292			
Line shells			2292	2345			
Thirty-Foot Sand			2345	2367			(OVER)
Red Rock, shells, Line			2367	2555			
Red-Rock Gordon Sand			2555	2573			Fifth Sand (hard) 2686'-2742'
Red Rock			2573	2610			Slate & shells 2742'-2847'
Fourth Sand			2610	2628			Total Depth 2847'

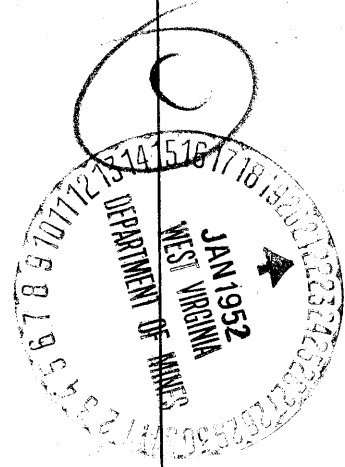

Formation	Color	Hard or Soft	Top	Bottom	Oil, Gas or Water	Depth Found	Remarks
<p>Hole bridged at 2750' from top.  Filled up with stone 2690' - 2750'  3' wooden plug at 2687'  Stones and clay 2687' - 2672'  bridged at 2285' from top  stones and etc. 2285' - 2213' from top  3' wooden plug at 2213' from top</p> <p>Bottom hole packer set at 1610' from top</p> <p>First perforation set 1793' from top  Second perforation set 2133' from top</p>							

Date \_\_\_\_\_, 19\_\_\_\_

APPROVED \_\_\_\_\_, Owner

By \_\_\_\_\_ (Title)

Grant District, Monongalia County, W. Va.

By Wilhelm & Jackson, Hazlett, W. Va.

Abandoned under permit 1000-.....-17

On 61 acres, on branch of Indian Creek.

Elevation, 1020.7' L.

Drilling completed May 30, 1923.

13" casing, 16'; 10", 368'; 8 1/2", 1126' (pulled); 6 3/4", 1610'; 2" tubing, 2192'

Hole full of water, 40'.

Cemented at 264-368', with 40 sacks cement and 80 sacks of sand.

Gas, 1754-1758', 39 M. Gas, 1778-1781', 73 M. Gas, 2178-2181', 73 M.

Gas well. Record to Dept. of Mines stamped Jan. 22, 1952.

Record to ROT from Mrs. Griffith July 9, 1952. O. P. No. 576.

	Top.	Bottom.
Surface, gravel	0	8
Lime, slate	8	105
Hard lime	105	232
Hopkinton (Sewickley) Coal	232	237
Hard lime	237	314
Pittsburgh Coal	314	318
Slate, lime shells, and red rock	318	507
Slate and shells	507	680
Little Bankard Sand	680	715
Slate, shells, and red rock	715	785
Big Bankard Sand	785	830
Slate and shells	830	970
Gas Sand	970	1052
Slate and shells	1052	1123
First salt sand	1123	1195
Lime and shells	1195	1237
Second salt sand	1237	1348
Black shale, red rock, and slate	1348	1482
Hard lime	1482	1490
Slate and shells	1490	1573
Little Lime	1573	1588
Pencil Cove	1588	1592
Big Lime	1592	1639
Big Injan Sand, sand	1639	1790
Slate and shells	1790	1880
Berea Sand	1880	1927
Slate and shells	1927	2150
Gants Sand	2150	2195
Slate	2195	2207
Fifty-foot Sand, hard	2207	2292
Lime shells	2292	2345
Thirty-foot Sand	2345	2367
Red rock, shells, lime	2367	2555
Gordon Sand	2555	2573
Red rock	2573	2610
Fourth Sand	2610	2638
Fifth Sand, hard	2638	2742
Slate and shells	2742	2847
Total depth		2847

---line did not print; write for it.

(OVER)

J. W. BINY NO. 2 WELL (Continued).

Hole bridged at 2750' from top.  
Filled up with stone, 2690-2750'.  
3' wooden plug at 2687'.  
Stems and clay, 2687-2672'.  
Bridged at 2285' from top.  
Stems etc., 2285-2213' from top.  
3' wooden plug at 2213' from top.

Bottom hole packer set at 1610' from top.

First perforation set 1793' from top.  
Second perforation set 2183' from top.



