

New Location  9745  
 Drill Deeper   
 Abandonment

MAY 21 1952

Map Sh 14 A-N7E42 - F.B. 1040-P 36, 37 & 38

Company	HOPE NATURAL GAS CO.
Address	CLARKSBURG, W. VA.
Farm	ROSA B. WOLFE
Tract	Acres 61 Lease No. 63705
Well (Farm) No.	Serial No. 9745
Elevation (Spirit Level)	1648'
Quadrangle	MORGANTOWN
County	MONONGALIA District MORGAN
Engineer	Guy H. Bradley
Engineer's Registration No.	2425
File No.	Drawing No.
Date	May 1, 1952 Scale 1" = 20 Poles

STATE OF WEST VIRGINIA  
 DEPARTMENT OF MINES  
 OIL AND GAS DIVISION  
 CHARLESTON

WELL LOCATION MAP  
 FILE NO. MON-201

+ Denotes location of well on United States Topographic Maps, scale 1 to 62,500, latitude and longitude lines being represented by border lines as shown.  
 - Denotes one inch spaces on border line of original tracing.

HOPE N.G. Co. Deep well 9745

STATE OF WEST VIRGINIA  
DEPARTMENT OF MINES  
OIL AND GAS DIVISION 7

*Morgantown*

**WELL RECORD**

Permit No. MON-201


Oil or Gas Well Dry  
(KIND)

Company Hope Natural Gas Company  
Address 445 West Main St., Clarksburg W. Va.  
Farm Rosa B. Wolfe Acres 61  
Location (waters) \_\_\_\_\_  
Well No. 9745 Elev. 1648'  
District Morgan County Monongalia  
The surface of tract is owned in fee by \_\_\_\_\_  
Address \_\_\_\_\_  
Mineral rights are owned by \_\_\_\_\_  
Address \_\_\_\_\_  
Drilling commenced July 1952  
Drilling completed Dec. 1953  
Date Shot Not shot From \_\_\_\_\_ To \_\_\_\_\_  
With \_\_\_\_\_  
Open Flow /10ths Water in \_\_\_\_\_ Inch  
/10ths Merc. in \_\_\_\_\_ Inch  
Volume Dry \_\_\_\_\_ Cu. Ft.  
Rock Pressure None lbs. \_\_\_\_\_ hrs.  
Oil None bbls., 1st 24 hrs.  
Fresh water 365 & 694' feet \_\_\_\_\_ feet  
Salt water 2426' feet \_\_\_\_\_ feet

Casing and Tubing	Used in Drilling	Left in Well	Packers
Size			
16			Kind of Packer
18	517'	517'	
10	2074'	2074'	Size of
8 1/4			
6 3/8	7273'	7273'	Depth set
5 3/16			
8			Perf. top
2			Perf. bottom
Liners Used			Perf. top
			Perf. bottom

CASING CEMENTED \_\_\_\_\_ SIZE \_\_\_\_\_ No. Ft. \_\_\_\_\_ Date \_\_\_\_\_  
7" casing set in 70 Bags cement.  
COAL WAS ENCOUNTERED AT \_\_\_\_\_ FEET \_\_\_\_\_ INCHES  
No coal  
FEET \_\_\_\_\_ INCHES FEET \_\_\_\_\_ INCHES  
FEET \_\_\_\_\_ INCHES FEET \_\_\_\_\_ INCHES

Formation	Color	Hard or Soft	Top	Bottom	Oil, Gas or Water	Depth Found	Remarks
Clay			0	35			
Big Lime			35	<del>XXX</del> 214			
Big Injun			214	316			
Slate			316	360			
SQUAW			360	497	Water	365	
Shale			497	536			
Lime			536	563			
Shale			563	605			
Berea			605	620			
<del>XXXXX</del> Shale			620	647			
Gantz			647	725	Water	694	
Shale			725	734			
50 ft.			734	760			
Shale			760	775			
30 ft.			775	850			
Shale			850	935			
Red Rock			935	961			
GORDON STRAY			961	977			
GORDON			977	993			
Red Rock			993	1188			
FOURTH SAND			1188	1252			
Shale			1252	1262			
FIFTH SAND			1262	1310			
Shale			1310	1328			
Lime			1328	1342			
Slate			1342	1346			
BAYARD			1346	1372			
Shale			1372	1569			
WARREN			1569	1586			
Slate & Shells			1586	1959			
Speechley			1959	2020			
Slate & Shells			2020	2220			
BALLTOWN			2220	2228			
Slate & Shells			2228	2426			
Lime			2426	2450			
Slate & Shells			2450	2995			
BENSON			2995	3024			
Shale			3024	3385			

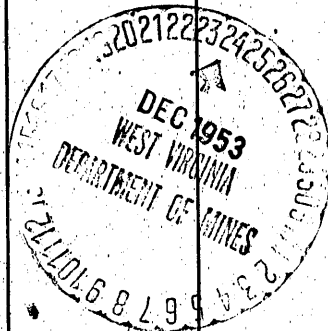

(Over) JAN 4 1954

ROSA B. WOLFE No. 9745 — HOPE N. G. Co. — MON 220

Formation	Color	Hard or Soft	Top	Bottom	Oil Gas or Water	Depth Found	Remarks
Sand			3385	3416			
Slate & Shells			3416	5970			
Lime			5970	5982			
Slate & Shells			5982	6005			
Slate			6005	6227			
Shale			6227	6240			
Shale (Limy)			6240	6837	Gas	6485 & 6837	Shows
TULLY			6837	6908			
Shale - Hard			6908	7025			
Black Shale			7025	7167			
Limy Shale			7167	7250			
ONONDAGA			7250	7257			
CHERT			7257	7478	Gas	7348	Show
CRISKANY			7478	7554			
HELDERBURG			7554	7959			
Tonoloway Limestone			7959	8025			
Lime			8025	8114			
Lime (Dark)			8114	8179			
Lime (Gritty)			8179	8380			
SALT			8380	8410			
Dolomite			8410	8425			
SALT			8425	8480			
Dolomite			8480	8502			
SALT			8502	8508			
Total Depth				8508'			
					7250	7478	7554
					1648	1648	1648
					5602	5830	5906

Date December 22, 1953

APPROVED Hope Natural Gas Company Owner

By \_\_\_\_\_ (Title)