


Latitude 39° 40'

Longitude 79° 55'

Scale 1" = 200 Feet

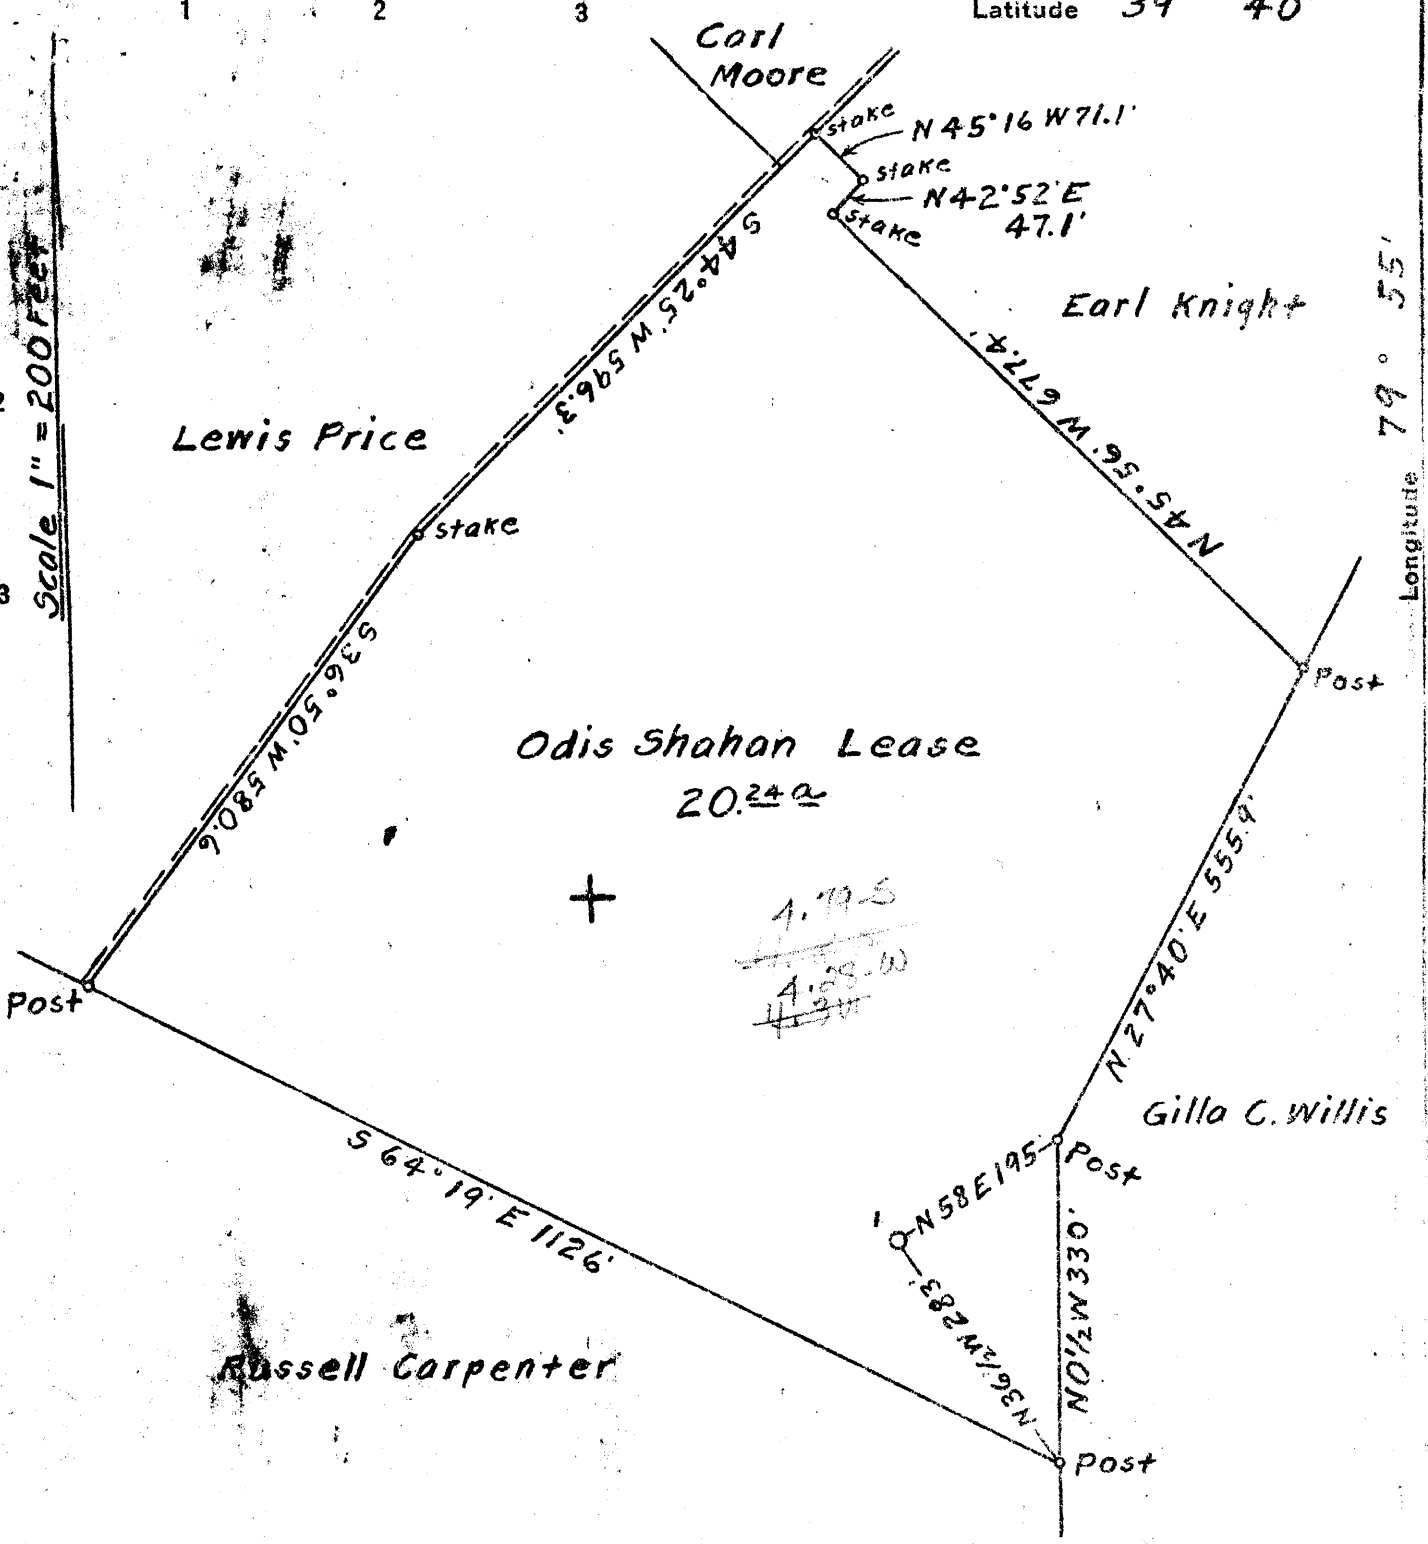

Surface owned by Odish Shahan.
 Address: Mr. Odish Shahan, R.F.D. No. 2, Box 72, Morgantown, W. Va.
 No Coal.

- New Location.
- Drill Deeper.....
- Abandonment.....

Company John R. Conklin
 Address P.O. Box 105, Waynesburg, Pa.
 Farm Odish Shahan
 Tract _____ Acres 20.24 Lease No. _____
 Well (Farm) No. 1 Serial No. _____
 Elevation (Spirit Level) Ground - 1127.60
 Quadrangle Morgantown WC
 County Monongalia District Grant
 Engineer Elsworth Haines
 Engineer's Registration No. 2221
 File No. _____ Drawing No. _____
 Date May 6th, 1952. Scale 1" = 200 Feet.

STATE OF WEST VIRGINIA
 DEPARTMENT OF MINES
 OIL AND GAS DIVISION
 CHARLESTON

WELL LOCATION MAP
 FILE NO. MON-202

- + Denotes location of well on United States Topographic Maps, scale 1 to 62,500, latitude and longitude lines being represented by border lines as shown.
- Denotes one inch spaces on border line of original tracing.

WEST VIRGINIA DEPARTMENT OF MINES
OIL & GAS DIVISION
WELL RECORD

Permit No. Mon 202
Morgantown Quad.

Gas Well
CASING & TUBING

Company	John R. Conklin		
Address	Waynesburg, Pa.	13	20
Farm	Otas Shahan Acres 20	8 1/2	258 258
Location	Monongalia River	6 5/8	1106 1106
Well No.	1 Elev. 1127.60		
District	Grant Monongalia		Packer
Surface	Otis Shahan, Morgantown, W.Va.		
Mineral	None		H Well
Commenced	June 23, 1952		Size 6 x 2
Completed	Aug. 17, 1952		Depth 1124
Open flow	24/10ths W in 1"		
Volume	51 MCF		
Rock Pressure	550 lbs. - hrs.		

L. Dunkard	210	246
B. Dunkard	273	295
G. Sand	450	495
Coal	495	500
1st Salt Sand	517	603
2nd Salt Sand	608	660
3rd Salt Sand	680	786
Maxon Sand	910	930
Big Lime	1092	1150
Big Injun 3 1/2	1150	1281
Squaw	1314	1400
Heir	1410	1438
Borea	1580	1605
30' Sand	1660	1676
50' Sand	1690	1727
T.D.		1727

1092 1150
1128

+ 36

1151-1155 gas 12/10 W 1"
1224-1232 gas 10/10 W 1"
1415-1417 gas 4/10 W 1"