


Latitude 39° 40'

Longitude 79° 55'

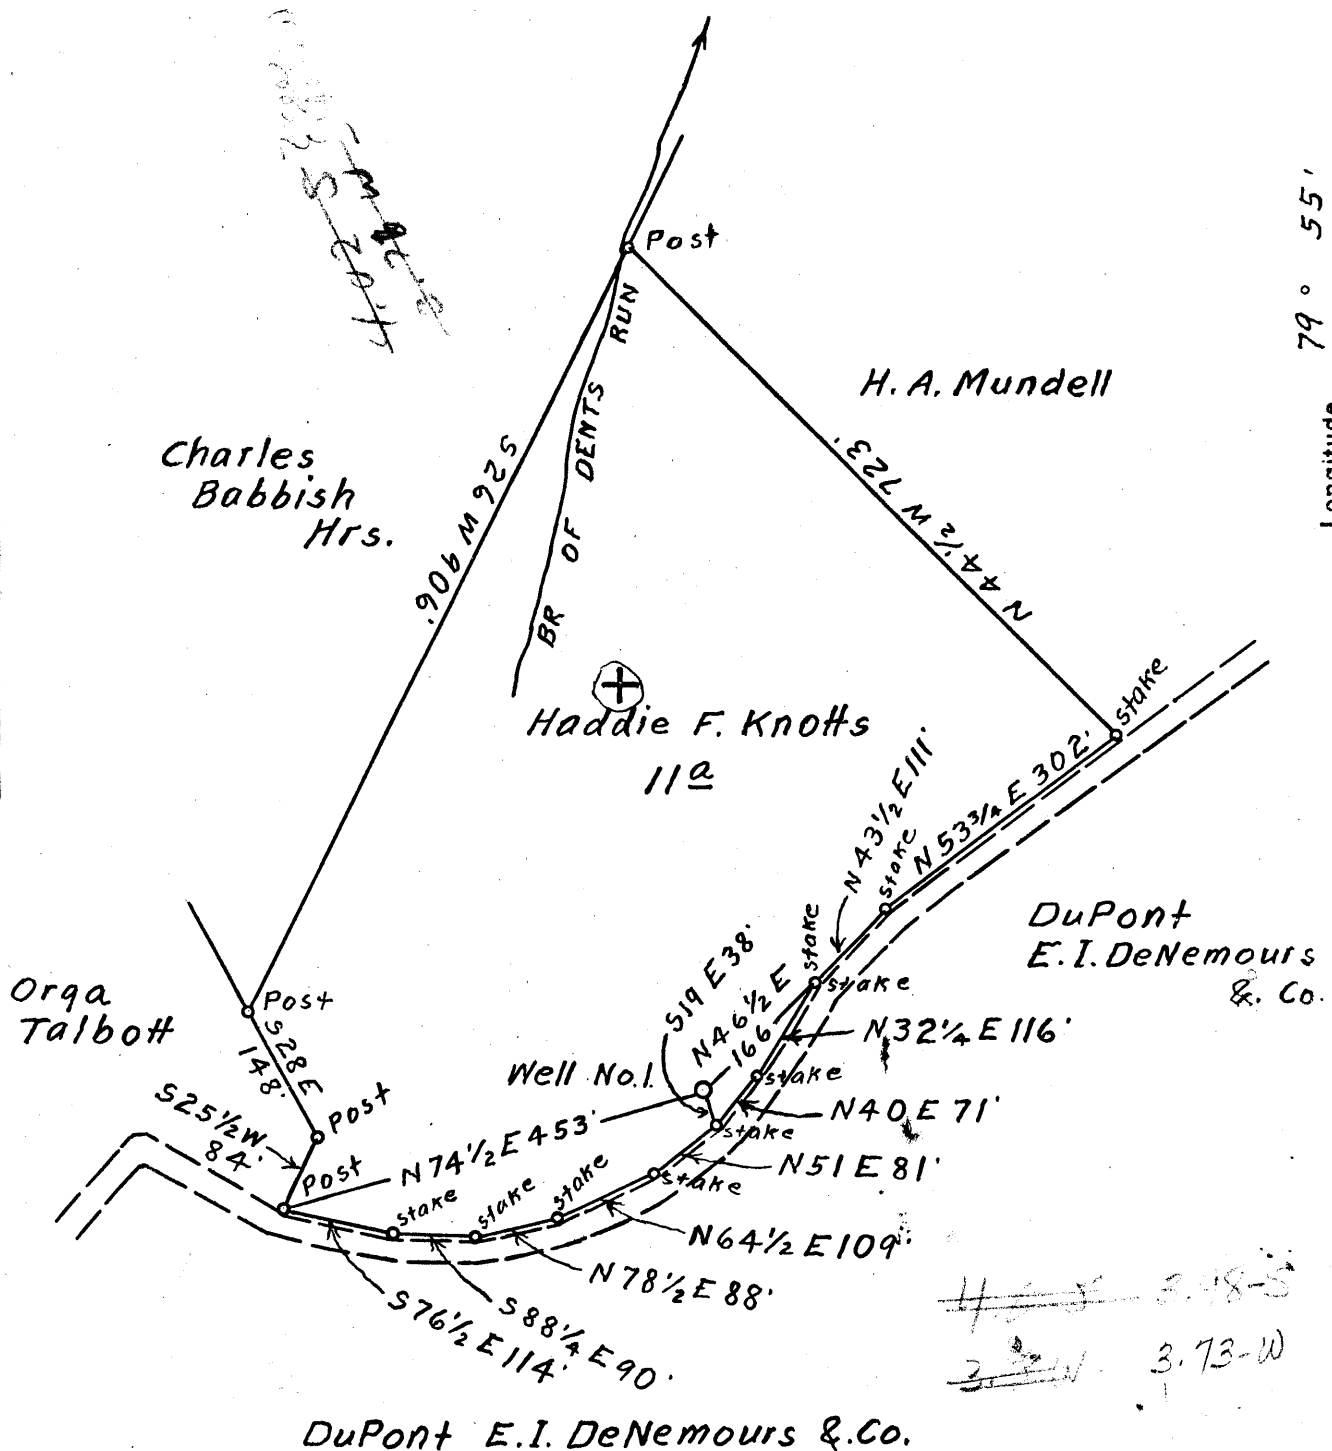

Surface owned by Haddie F. Knotts.
 Address: Mrs. Haddie F. Knotts, R.F.D. No. 2, Morgantown, W. Va.
 No Coal.

- New Location...
- Drill Deeper.....
- Abandonment.....

On 800' Map

Company John R. Conklin
 Address P.O. Box 105, Waynesburg, Pa.
 Farm Haddie F. Knotts
 Tract _____ Acres 11 Lease No. _____
 Well (Farm) No. 1. Serial No. _____
 Elevation (Spirit Level) Ground - 1343.91
 Quadrangle Morgantown WC
 County Monongalia District Grant
 Engineer Elsworth Haines
 Engineer's Registration No. 2221.
 File No. _____ Drawing No. _____
 Date Apr. 30th, 1954. Scale 1" = 200 Feet

STATE OF WEST VIRGINIA
 DEPARTMENT OF MINES
 OIL AND GAS DIVISION
 CHARLESTON

WELL LOCATION MAP
 FILE NO. MON-210

- + Denotes location of well on United States Topographic Maps, scale 1 to 62,500, latitude and longitude lines being represented by border lines as shown.
- Denotes one inch spaces on border line of original tracing.



STATE OF WEST VIRGINIA
DEPARTMENT OF MINES
OIL AND GAS DIVISION

Quadrangle Morgantown

Permit No. MON-210

WELL RECORD

Oil or Gas Well DRY

(KIND)

Company John R. Conklin & John R. Conklin, Jr.
Address Waynesburg, Pennsylvania
Farm Haddie Knotts Acres 11
Location (waters) _____
Well No. 1 Elev. 1343.91
District Grant County Monongalia
The surface of tract is owned in fee by Haddie Knotts
RFD #2 Address Morgantown, W. Va.
Mineral rights are owned by Same
Address _____
Drilling commenced June 3, 1954
Drilling completed July 23, 1954
Date Shot _____ From _____ To _____
With None

Casing and Tubing	Used in Drilling	Left in Well	Packers
Size			
16			Kind of Packer
13	20'		
10			Size of
8 1/4	350'		
6 3/4	1348'		Depth set
5 3/16			
3			Perf. top
2			Perf. bottom
Liners Used			Perf. top
			Perf. bottom

Open Flow /10ths Water in Dry hole Inch
/10ths Merc. in _____ Inch
Volume _____ Cu. Ft.
Rock Pressure _____ lbs. _____ hrs.
Oil _____ bbls., 1st 24 hrs.
Fresh water _____ feet _____ feet
Salt water _____ feet _____ feet

CASING CEMENTED _____ SIZE _____ No. Ft. _____ Date _____
COAL WAS ENCOUNTERED AT None FEET _____ INCHES
_____ FEET _____ INCHES FEET _____ INCHES
_____ FEET _____ INCHES FEET _____ INCHES

Formation	Color	Hard or Soft	Top	Bottom	Oil, Gas or Water	Depth Found	Remarks
Water				55			
Sand, rock and lime			55	450			
Dunkard			450	517			
Big Dunkard			545	565			
Show gas			683	685			
Show gas and water			852				
1st Salt sand			860	957	1338	1414	
2d Salt sand			971	1026	1340	1344	
3d Salt sand			1045	1060	46	70	
Little lime			1283	1320			
Big lime			1338	1414			
Big Injun	371		1414	1555			
Weir sand			1660	1705			
50 ft. sand			1984	2036			
Total Depth				2046			

