

WW-7  
8-30-06



West Virginia Department of Environmental Protection  
Office of Oil and Gas  
**WELL LOCATION FORM: GPS**

API: 47-061-00229 WELL NO.: Hoard 4 Hodge

FARM NAME: Hoard

RESPONSIBLE PARTY NAME: Noumenon Corporation

COUNTY: Monongalia DISTRICT: Union

QUADRANGLE: Morgantown North WV-PA 7.5

SURFACE OWNER: William Earle Hoard

ROYALTY OWNER: \_\_\_\_\_

UTM GPS NORTHING: 4395756.91 M (803')

UTM GPS EASTING: 591755.67 M GPS ELEVATION: 245.06 M

The Responsible Party named above has chosen to submit GPS coordinates in lieu of preparing a new well location plat for a plugging permit or assigned API number on the above well. The Office of Oil and Gas will not accept GPS coordinates that do not meet the following requirements:

1. Datum: NAD 1983, Zone: 17 North, Coordinate Units: meters, Altitude: height above mean sea level (MSL) – meters.
2. Accuracy to Datum – 3.05 meters
3. Data Collection Method:

Survey grade GPS  : Post Processed Differential \_\_\_\_\_  
Real-Time Differential

Mapping Grade GPS \_\_\_\_\_ : Post Processed Differential \_\_\_\_\_  
Real-Time Differential \_\_\_\_\_


4. Letter size copy of the topography map showing the well location.

I the undersigned, hereby certify this data is correct to the best of my knowledge and belief and shows all the information required by law and the regulations issued and prescribed by the Office of Oil and Gas.

Signature

President  
Title

4/06/2018  
Date

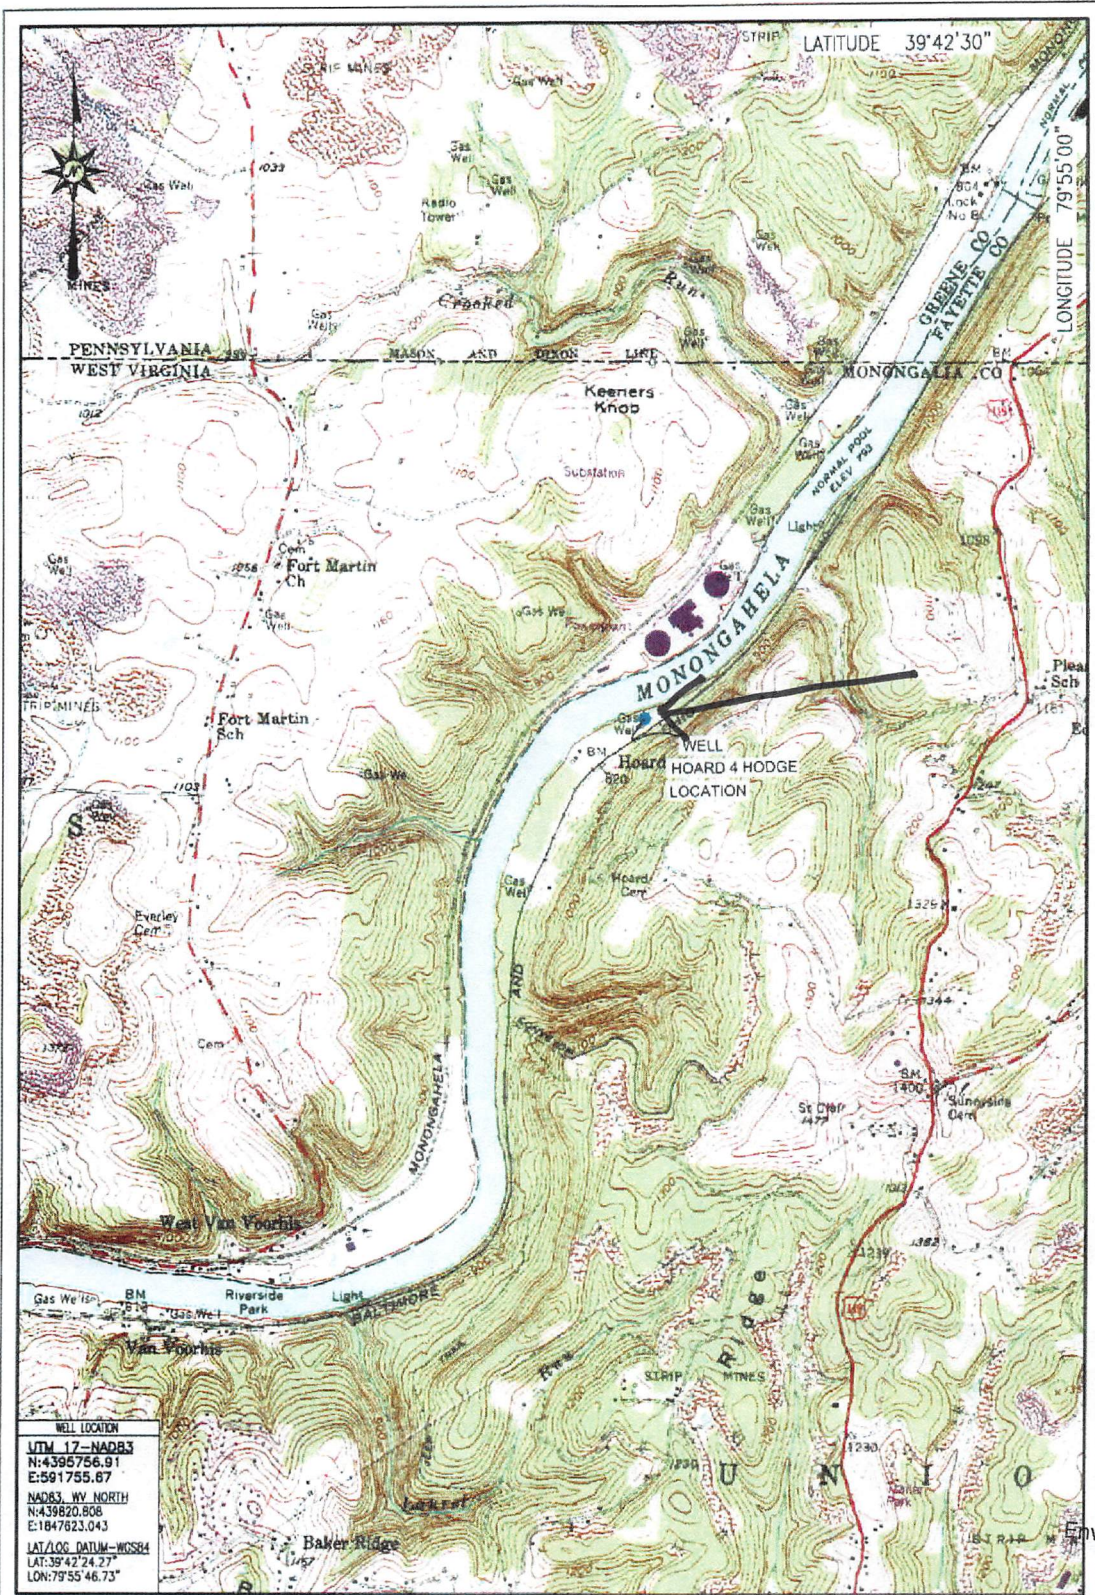

WELL LOCATION  
 UTM 17-NAD83  
 N:4395756.91  
 E:591755.87  
 NAD83, WV NORTH  
 N:439820.808  
 E:1847623.043  
 LAT/LONG DATUM-WGS84  
 LAT:39°42'24.27"  
 LON:79°55'46.73"

RECEIVED  
 Office of Oil and Gas  
 SEP 20 2018  
 WV Department of  
 Environmental Protection

LOCATION MAP  
 APRIL 6, 2018

**Blue Mountain Inc.**  
 11023 MASON DIXON HIGHWAY  
 BURTON, WV 26562  
 PHONE: (304) 682-6486

HOARD 4 HODGE  
 MORGANTOWN NORTH QUADRANGLE  
 WEST VIRGINIA

SCALE 1" = 2000'  
 0' 2000' 4000' 6000'



**BLUE MOUNTAIN ENGINEERING**