

Latitude 39° 40'

Longitude 80° 15'



Calvin D. Harter

M. J. Garrison

J. F. Smith
479

J. S. Smith

Wilson Hought

COAL: LITTLE KANAWHA SYNDICATE,
% BERNARD G. SAMPSON,
Box 368, FAIRMONT, W. Va.

SURFACE: NOLAN BROWN,
WADESTOWN, W. Va.

New Location
Drill Deeper
Abandonment

Map N71E N14 E16

Company SOUTH PENN OIL CO.
 Address PARKERSBURG, W. Va.
 Farm J. F. Smith
 Tract _____ Acres 47 Lease No. 57870
 Well (Farm) No. 3 D.D. Serial No. 27133
 Elevation (Spirit Level) 1189.0
 Quadrangle Mannington C
 County Monongalia District Battelle
 Engineer A. C. Hilbert
 Engineer's Registration No. 2534
 File No. 631 Drawing No. _____
 Date Mar. 24, 1961 Scale 1" = 400'

STATE OF WEST VIRGINIA
DEPARTMENT OF MINES
OIL AND GAS DIVISION
CHARLESTON

WELL LOCATION MAP

FILE NO. MON-252-D

was: 3065 Drill Deeper

+ Denotes location of well on United States Topographic Maps, scale 1 to 62,500, latitude and longitude lines being represented by border lines as shown.

- Denotes one inch spaces on border line of original tracing.


39° Latitude 40°

1.215
-48 W

N.



80° Longitude 20°

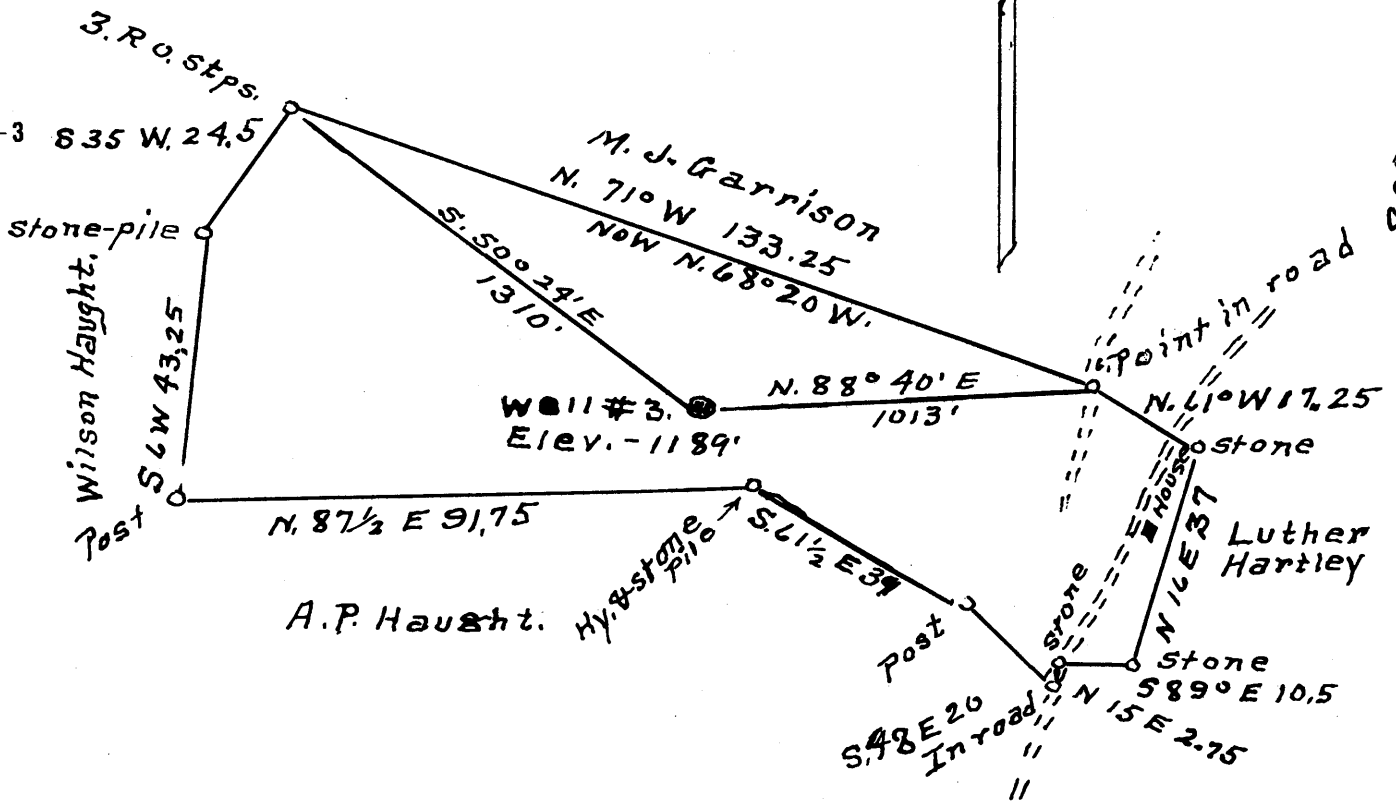

Coal = Little Kanawha Syndicate
 c/o Bernard G. Sampson
 Box 368 Fairmont, W. Va.
 Surface = Nolan W. Brown
 Wadestown, W. Va.

New Location
 Drill Deeper
 Abandonment

Company Cecil Chisler & son
 Address R#2 Fairview, W. Va.
 Farm J. F. Smith
 Tract ONE Acres 43.1 Lease No. 57870
 Well (Farm) No. 3 Serial No. _____
 Elevation (Spirit Level) 1189'
 Quadrangle Mannington
 County Monongalia District Battelle
 Engineer A. L. Headley
 Engineer's Registration No. 2021
 File No. _____ Drawing No. _____
 Date 8-11-62 Scale 1" = 30 poles

STATE OF WEST VIRGINIA
 DEPARTMENT OF MINES
 OIL AND GAS DIVISION
 CHARLESTON

WELL LOCATION MAP
 FILE NO. MON-655-A

NW: 061 252

+ Denotes location of well on United States Topographic Maps, scale 1 to 62,500, latitude and longitude lines being represented by border lines as shown.

- Denotes one inch spaces on border line of original tracing.



STATE OF WEST VIRGINIA
DEPARTMENT OF MINES
OIL AND GAS DIVISION

Quadrangle MANNINGTON

WELL RECORD

Permit No. MON-252-D

Oil or Gas Well Dry
(KIND)

Company SOUTH PENN OIL COMPANY
Address P. O. Box 1280, Parkersburg, W. Va.
Farm J. E. Smith Acres 47
Location (waters) West Virginia Fork of Dunkard Cr.
Well No. 3-Drill Deeper Elev. 1189.0
District Battelle County Monongalia
The surface of tract is owned in fee by Nolan Brown
Address Wadestown, W. Va.
Mineral rights are owned by Harry Smith, et al.
RFD 3, Box 292 Address Mannington, W. Va.
Drilling commenced January 4, 1961
Drilling completed March 31, 1961
Date Shot - From - To -
With -
Open Flow 8,340 /10ths Water in - Inch
8,340 /10ths Merc. in - Inch
Volume 8,340 Cu. Ft.
Rock Pressure - lbs. - hrs.
Oil - bbls., 1st 24 hrs.
WELL ACIDIZED -
WELL FRACTURED -

Casing and Tubing	Used in Drilling	Left in Well	Packers
Size			Kind of Packer
16	N O N	E	NONE
13			Size of
10			Depth set
8 1/4			Perf. top
6 3/4			Perf. bottom
5 3/16			Perf. top
3			Perf. bottom
2			
Liners Used			

CASING CEMENTED - SIZE - No. Ft. - Date

COAL WAS ENCOUNTERED AT - FEET - INCHES
- FEET - INCHES - FEET - INCHES
- FEET - INCHES - FEET - INCHES

RESULT AFTER TREATMENT -
ROCK PRESSURE AFTER TREATMENT -
Fresh Water - Feet Salt Water - Feet

Formation	Color	Hard or Soft	Top	Bottom	Oil, Gas or Water	Depth	Remarks
Commenced drilling				3300			
Fourth Sand			3273	3308			
Shale			3308	3410			
Sand			3410	3415	Gas	8,340 (O.F.)	
					Gas	3410-3415	
Shale & Slate			3415	3590			
TOTAL DEPTH				3590			