
2

. 3

LATITUDE 39 ° 40

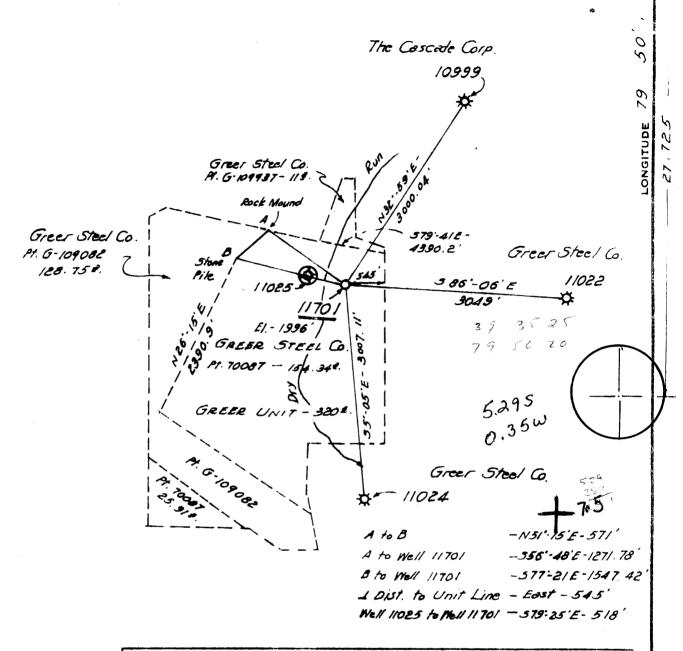

Minimum Error of Closure / /~ 200'

Source of Elevation B. M. - Consalidated Gas Supply Corp.

WELL Nº 11025 - ELEV. 1952'

"I, the undersigned, hereby certify that this map is correct to the best of my knowledge and belief and shows all the information required by paragraph 6 of the rules and regulations of the oil and gas section of the mining laws of West Virginia."

Drill Deeper _____ Abandonment ____ MAP SHEET - 933 C-2 F

FB 1674 PG. 39 FB 1647 PG. 10-13

Company CONSOLIDATED GAS SUPPLY GRA
Address CLARKSBURG, W. VA.

Farm GREER STEEL CO.

Tract Acres 154.34 Lease No. 17. 70087

Well (Farm) No. Serial No. 11. 701

Elevation (Spirit Level) 1996

Quadrangle MORGAN TOWN C"

County Menon GALIA District MORGAN

Engineer Registration No. 2397

File No. Drawing No.

Date Nov. 26, 1973 Scale 1" 2 1320"

New Location _____

STATE OF WEST VIRGINIA
DEPARTMENT OF MINES
OIL AND GAS DIVISION
CHARLESTON

WELL LOCATION MAP

+ Denotes location of well on United States Topographic Maps, scale 1 to 62,500, latitude and longitude lines being represented by border lines as shown.

- Denotes one inch spaces on border line of original tracing.

ee@UN 21 1974

6-6 South Burns Chapel (313) (Orisk) Seep (

6466



STATE OF WEST VIRGINIA DEPARTMENT OF MINES

Oil and Gas Division

WELL RECORD

Quadrangle Morgantov Permit No. MON-337			KECOKD		Recycling_	Comb. Storage
Company Consolidat Address Clarksburg Farm Greer Steel (z, WV		Casing and Tubing	Used in Drilling	Left in Well	Cement fill up Cu. ft. (Sks.)
Location (waters)I Well No11701 DistrictMorgan	Deckers Creek	ev. 1996	Size 20-16 Cond.			
The surface of tract is owned in fee by			13-100%	32	32	To Surface
Greer Steel (9 5/8	1042	1042	375 SKS	
Address Morganto			8 5/8	1072	1042	21) 200
Mineral rights are owned	•		7	,	 	1
Address			5 1/2	<u> </u>		†
Drilling Commenced			4 1/2	8047	8047	200 010
Drilling Completed			3	1. 0047	1.0047	300 SKS
			2	7933	7022	·
Initial open flow	cu. II.	bbls.	Liners Used	1933	7933	-{
Final production 1600 M			Liners Oseu			_
Well open <u>11 days</u> Well treatment details:	hrs. before test_	3040# RP.	Attach copy of		-	
20% hyd. acid	hyd. acid. T. 1, 625 bbl. 5%	hyd. acid.	Trailed in	750# wal nu	ıt shells	· Perf. 7891-9
Coal was encountered at Fresh water 29, 45, Producing Sand	760 Fe	; 7922-27. Fee	5 holes: <u>79</u> 40	Inche	oles; <u>795</u>	8-71, 13 holes
Coal was encountered at Fresh water 29, 45,	760 Fe	; 7922-27. Fee	5 holes: 7940 tSalt \	Inche	oles; <u>795</u> es	8-71, 13 holes.
Coal was encountered at Fresh water 29, 45, Producing Sand	760 Fe Chert. • H	; 7922-27, Fee et antersville	5 holes; 7940 tSait V	Inche Water 7891-7	oles; <u>795</u> es	8-71, 13 holes. — Feet
Coal was encountered at Fresh water 29, 45, Producing Sand Formation Color Electric Log Greenbrier Speechley Benson Tully Onondaga Chert	760 Fe Chert. • H	Fee et an tersville Top Feet 403 2389 3870 7286 7835	Salt V Deptl Bottom Feet 642 2412 3908 7390 7881	Inche Water 7891-7	oles; <u>795</u> es	8-71, 13 holes. — Feet

(over)

K. B. Measurement 16' above G.L.

^{*} Indicates Electric Log tops in the remarks section.





OIL & GAS DIVISION DEPT. OF MINES

Oil and Gas Division

OIL AND GAS WELL PERMIT APPLICATION

TO THE DEPARTMENT OF MINES, Charleston, W. Va.	DATE May 21, 1971			
•				
Surface Owner Greer Steel Company	Clarkohung M Va	<u>on</u>		
Address Morgantown, W. Va.	Address			
Mineral Owner Same	Farm Greer Steel Company Acres 15h.3h			
Address	Location (waters) Dry Run / Deckers Creek			
Coal OwnerNone				
Address		<u>li</u> a		
Coal Operator None	Quadrangle MORGANTOWN			
Address	-			
THIS PERMIT MUST BE POSTED AT THE WELL SITE				
of the W. Va. Code, the location is hereby approved for drilling. This permit shall expire if operations have not commenced by 9-23-74	LOTOR TO BE NOTHED William Blosse	77		
Deputy Director - Cil & Cas Division	Colfax, W.Va. PH: 363-9105	T.		
19 <u>60</u> in <u>Monongalia</u> County, Book <u>591</u>	mpany and recorded on the 23rd day of Nover Page 179 REDRILL FRACTURE OR STIMULAT	nbe 1		
	or licensed land surveyor and all coal owners and/or operat	ors		
The above named coal owners and/or operator are hereby to make by Section 3 of the Code, must be received by, or fi	notified that any objection they wish to make, or are requilied with the Department of Mines within ten (10) days. *	red		
Copies of this notice and the enclosed plat were mailed by or coal owners at their above shown respective addresssame day with the mailing or delivery of this copy to the Dep		ors the		
	Very truly yours			
PART EL L'ALTE	(Sign Name) Togare Manager of From Meli Operator	<u>d.</u>		
PLEASE SUBMIT COPIES OF ALL GEOPHYSICAL LOGS DIRECTLY TO:	Consolidated Gas Supply Corporati			
West Virginia Geological and Economic Survey Addres P. O. Box 879 Well Oper Morgantown, W. Va. 26505 AC 304-296-4461	11 T West Main Street			
	State			

*SECTION 3.... If no objections are filed or found by the Department of mines, within said period of ten days from the receipt of notice and plat by the department of mines, to said proposed location, the department shall forthwith issue to the well operator a permit reciting the filing of such plat, that no objections have been made by the coal operators or found thereto by the department and that the same is approved and the well operator authorized to proceed.

MON-337

PERMIT NUMBER

THIS IS AN ESTIMATE ONLY ACTUAL INFORMATION WILL BE SUBMITTED ON OG-10 UPON COMPLETION

PROPOSED WORK ORDER TO XX DRILL			DEEPEN FRACTURE-STIMULATE			
DRILLING CONTRACTOR: (If Known)			RESPONSIBLE AGENT:			
NAME Not known at this time			NAME R. E. Bayne			
ADDRESS			ADDRESS Bridgeport, W. Va.			
TELEPHO	NE		TELEPHONE <u>623-3611</u> :			
ESTIMAT	ED DEPTH OF COMPLE	TED WELL: 8050!	ROTARY XXX	CABLE TOOLS		
PROPOSE	D GEOLOGICAL FORM	ATION: <u>Oriskany</u>				
TYPE OF	WELL: OIL	GAS XXX CO	OMB STORAGE	EDISPOSAL		
				OODOTHER		
	VE CASING PROGRAM:	USED FOR				
CASI	SIZE	DRILLING	LEFT IN WELL	OR SACKS - CUBIC FT.		
20 - 16						
13 - XIOY		30 '	30 '	To surface		
x9x3x/8x 1	.0"	1000'	1000'	To surface		
8 - 5/8						
7		8000!	8000!	150 bags		
5 ½ 4 ½						
				D. C. T.		
2				Perf. Top Perf. Bottom		
Liners				Perf. Top		
			71 July 1	Perf. Bottom		
TO DRILI SUBI OF I TO DRILI SUBI WEL MUS TO FRAC OIL BON OIL ING G	BEING MINED IN THE L: MIT FIVE (5) COPIES OF PLAT. DEEPER OR REDRILL MIT FIVE (5) COPIES OF LS DRILLED PRIOR TO THE ALSO BE SUBMITTED FURE - STIMULATE: AND/OR GAS WELL ORID, PERMANENT PLAT AND/OR GAS WELL ORIORIGINAL PERMIT NUM	AREA? No F OG - 1, \$100.00 PERMIT GOG - 1, SHOWING ORIGIN 1929, A PERMANENT CO GINALLY DRILLED BEFORM AND ORIGINAL WELL RECO GINALLY DRILLED ON AN BER, AND PERFORMANCE	BY WHOM?BY WHOM?BY WHOM?BY WHOM?BY WHOM?BY WHOM?BY PERMIT NUMBER AND TO SELVE TO SE	OND AND PERMANENT COPY OD PERFORMANCE BOND. ON THE ORIGINAL WELL RECORD COPIES OG - 1, PERFORMANCE 9, FIVE COPIES OG - 1, SHOW- Inspector to be notified twenty-		
	-					
The thereof.	following waiver must be	completed by the coal oper	ator if the permit is to be	issued within ten days of receipt		
WAIVER:	I the undersigned, Agent this lease have examined	forand place on our mine ma	Coal Company, Owner	or Operator of the coal under		
	We the	Coal Company h	ave no objections to said w	ell being drilled at this location, 7, Chapter 22 of the West Virginia		
			Fo	or Coal Company		
				Official Title		