

6100337P

WW-7
8-30-06



West Virginia Department of Environmental Protection
Office of Oil and Gas

WELL LOCATION FORM: GPS

API: 47-061-00337 WELL NO.: 7122

FARM NAME: Greer Steel

RESPONSIBLE PARTY NAME: Erika Whetstone

COUNTY: Monongalia DISTRICT: Morgan

QUADRANGLE: MASONTOWN

SURFACE OWNER: GREER STEEL COMPANY

ROYALTY OWNER: _____

UTM GPS NORTHING: 4,382,949.154 METERS

UTM GPS EASTING: 599,629.492 METERS GPS ELEVATION: 613.471 METERS

(2012.8 FT)

The Responsible Party named above has chosen to submit GPS coordinates in lieu of preparing a new well location plat for a plugging permit or assigned API number on the above well. The Office of Oil and Gas will not accept GPS coordinates that do not meet the following requirements:

1. Datum: NAD 1983, Zone: 17 North, Coordinate Units: meters, Altitude: height above mean sea level (MSL) – meters.
2. Accuracy to Datum – 3.05 meters
3. Data Collection Method:

Survey grade GPS : Post Processed Differential

Real-Time Differential _____

Mapping Grade GPS _____ : Post Processed Differential _____

Real-Time Differential _____

4. Letter size copy of the topography map showing the well location.

I the undersigned, hereby certify this data is correct to the best of my knowledge and belief and shows all the information required by law and the regulations issued and prescribed by the Office of Oil and Gas.


Erika J. Whetstone
Signature

Permitting Supervisor
Title

8/11/17
Date

RECEIVED
Office of Oil and Gas
AUG 23 2017
WV Department of
Environmental Protection

09/15/2017

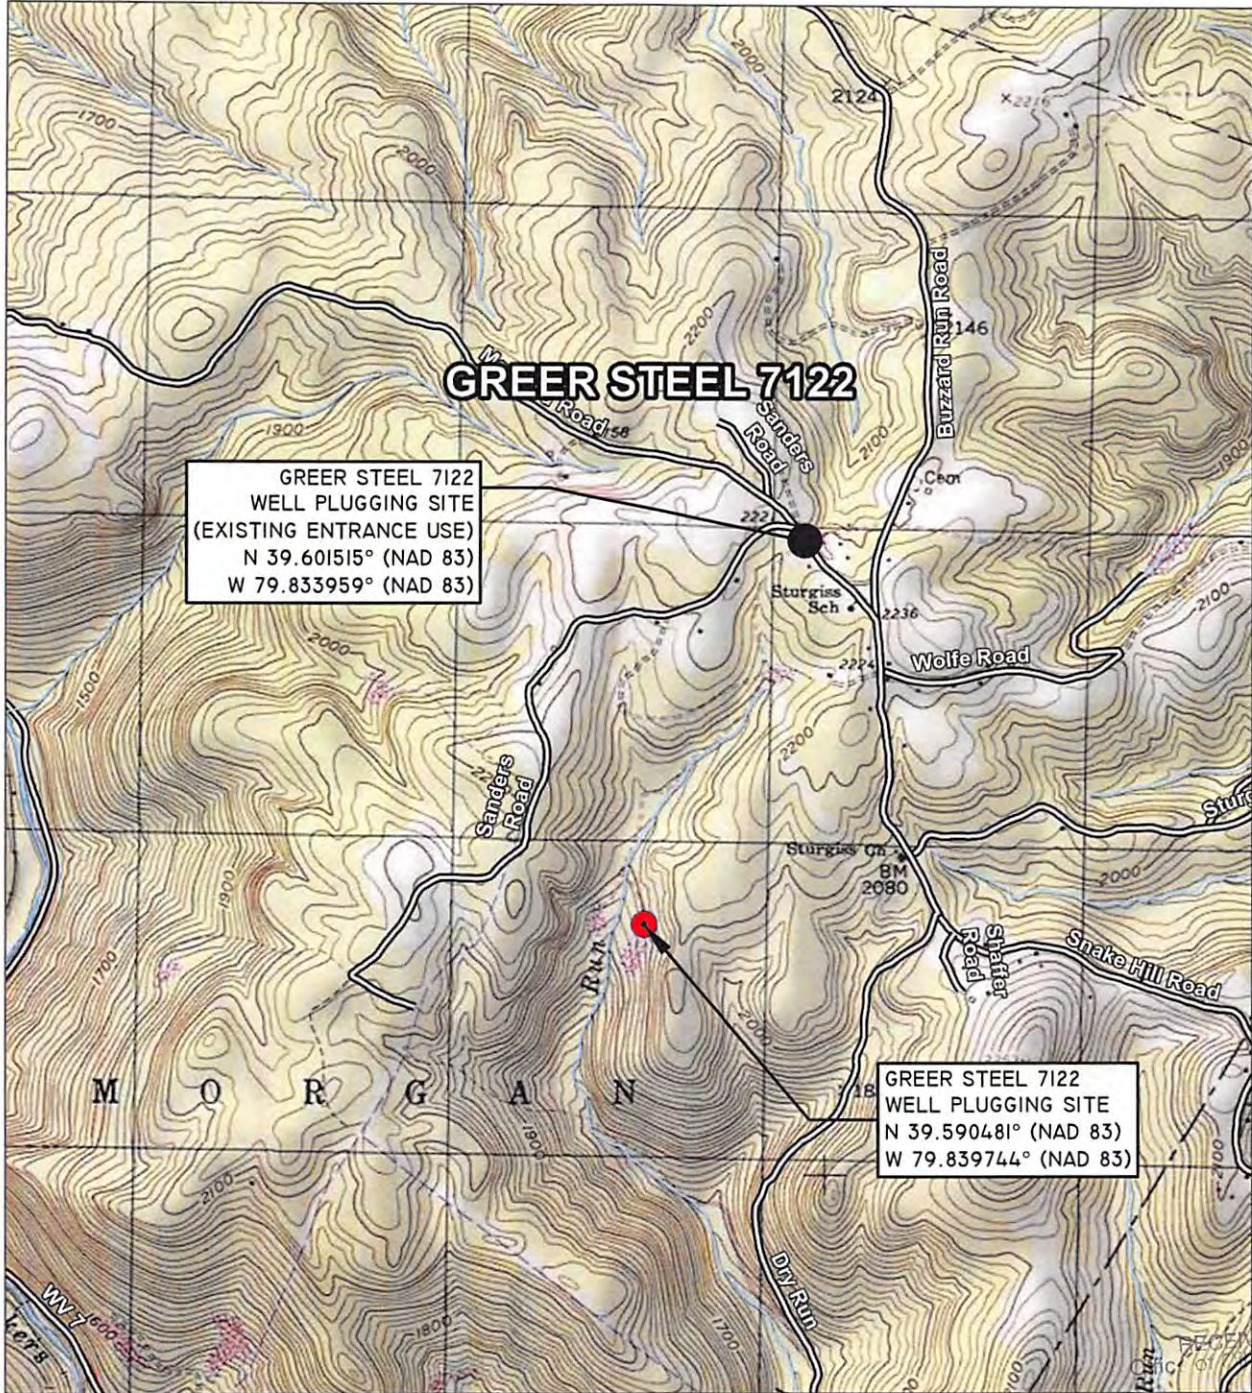

LOCATION MAP
MASONTOWN, WV 7.5M USGS QUADRANGLE
SCALE: 1"=2000'

AUG 23 2017



Blue Mountain Inc.

Engineers and Land Surveyors
Woman Owned Small Business

11023 Mason Dixon Hwy.
Burton, WV 26562-9656
(304) 662-6486

LOCATION MAP
GAS WELL PLUGGING
GREER STEEL 7122 GAS WELL
MORGAN DISTRICT
MONONGALIA COUNTY, WV

CONSOL GAS COMPANY
200 HALLAM ROAD
WASHINGTON, PA 15301

DRAWN BY: LLF
CHECKED BY: WPF
DATE: 07/21/2017
SCALE: 1"=2000'
WATERSHED:
OUTLET DECKERS CREEK
PAGE 4 OF 4

09/15/2017