


LATITUDE 39° 45' 00"

80° 51' 00"

LONGITUDE

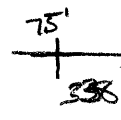

7'5 OGIS topo location

7.5' loc	<u>2.04S</u>	15' loc	<u>2.04S</u>
	<u>1.09W</u>	(calc.)	<u>1.09W</u>

Company \_\_\_\_\_

Farm \_\_\_\_\_

Quad Wadestown (Mantle NE)


County Monongalia

District Bathelle

WELL LOCATION MAP

File No. 061-338

8/28/74 CEN

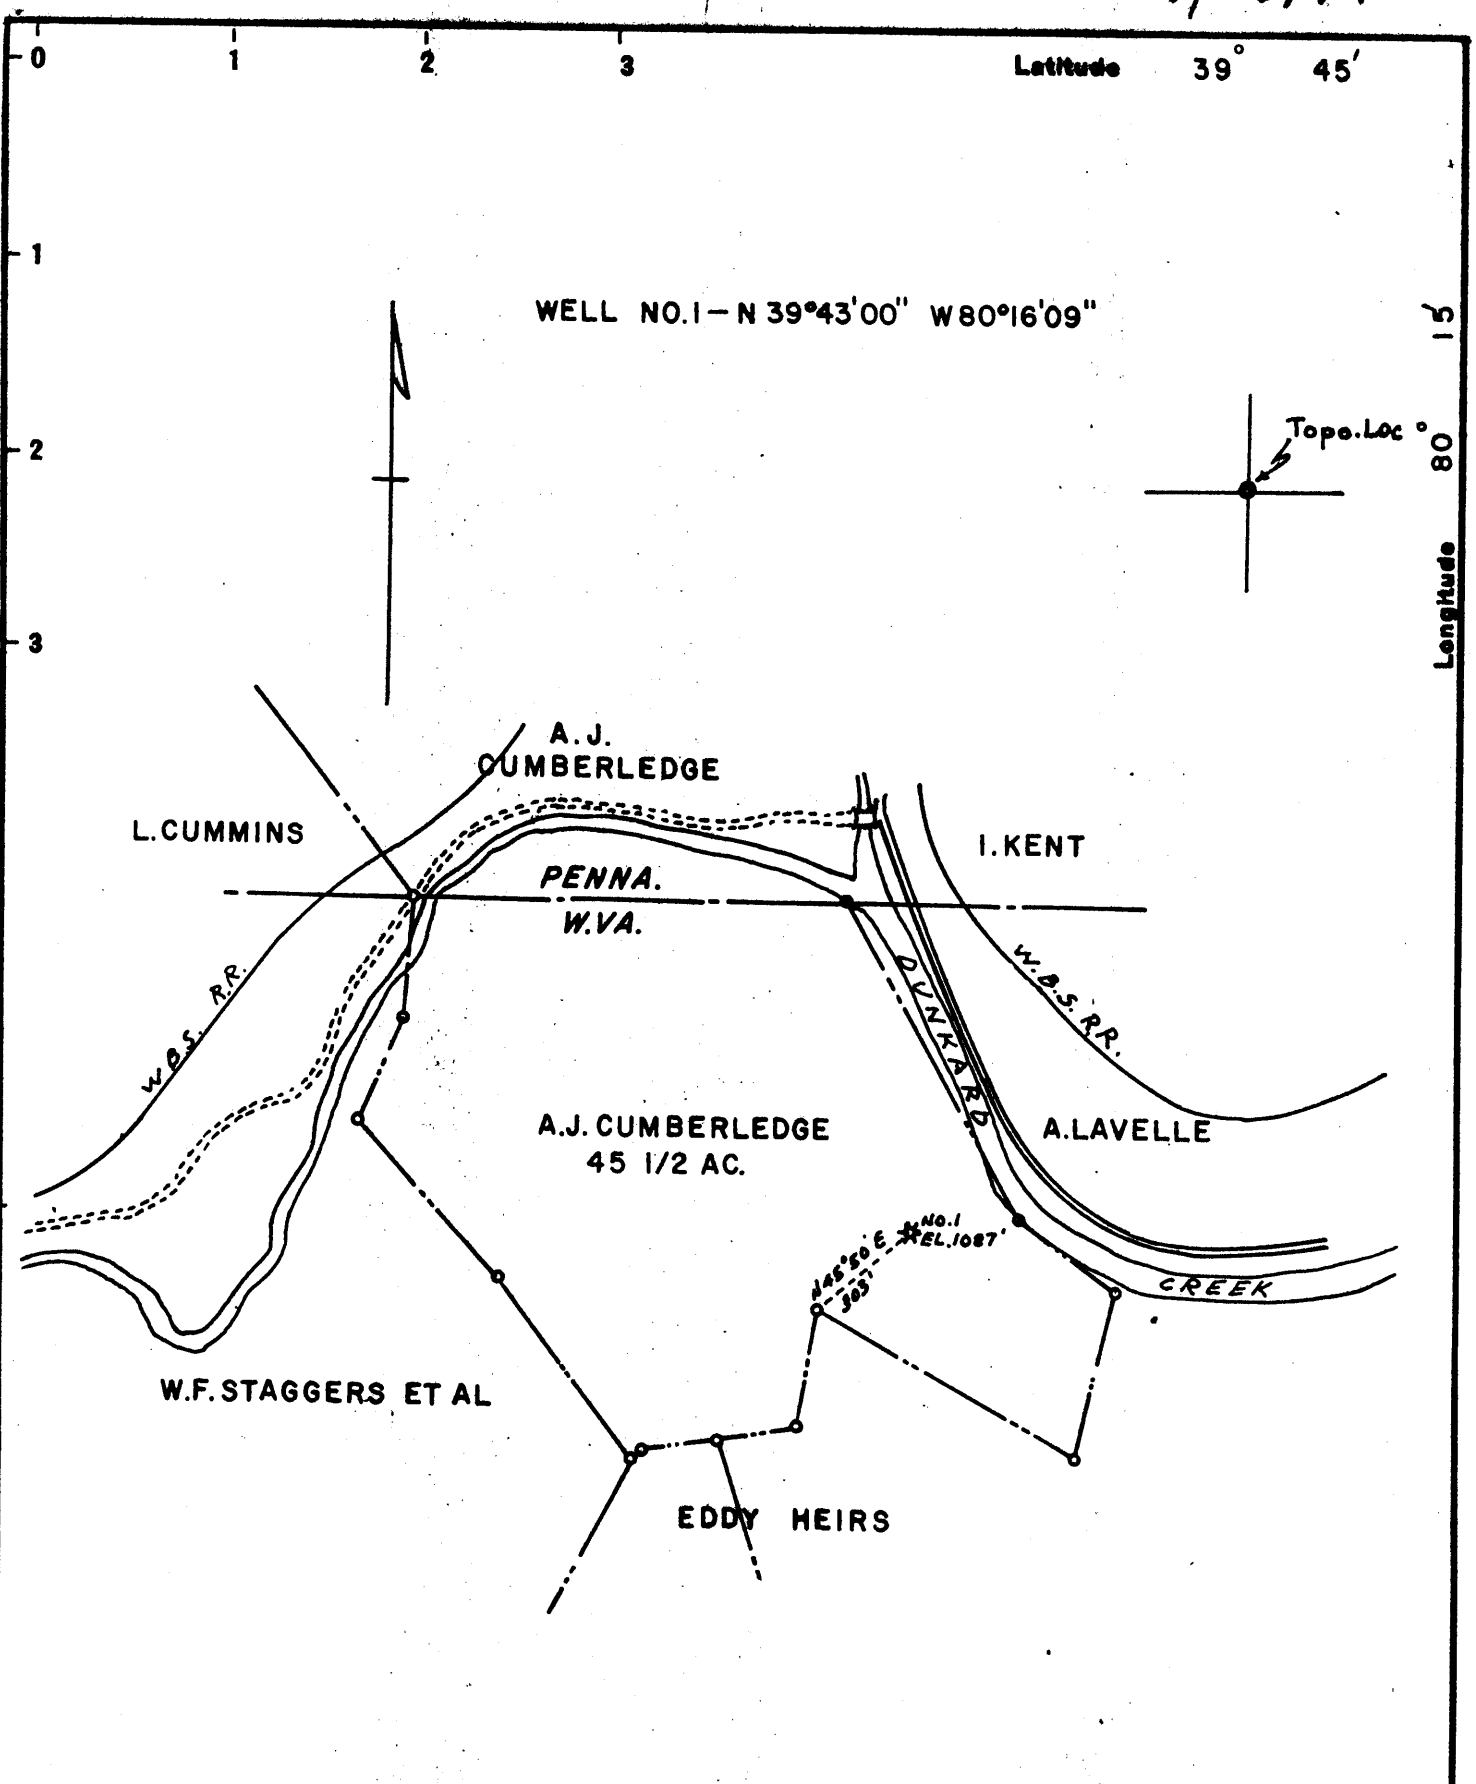

*Redrill & Plugging: cancel*  
 New Location...   
 Drill Deeper...  *8/28/74*  
 Abandonment...

U.S. Bureau of Mines For:

Company	BLACKSVILLE DIVISION CONSOLIDATION COAL CO.
Address	BOX 24, WANA, W.VA. 26590
Farm	A. J. CUMBERLEDGE
Tract	Acres 45 1/2 Lease No. _____
Well (Farm) No.	(S.P.) NO. 1 Serial No. _____
Elevation (Spirit Level)	1087'
Quadrangle	WADESTOWN-N.E. 1/4 MANNINGTON-15'
County	MONONGALIA District BATTELLE
Engineer	<i>T. B. Kitzmiller</i>
Engineer's Registration No.	5656
File No.	_____ Drawing No. _____
Date	AUG. 27, 1974 Scale 1" = 500'

STATE OF WEST VIRGINIA  
 DEPARTMENT OF MINES  
 OIL AND GAS DIVISION  
 CHARLESTON

**WELL LOCATION MAP**  
 FILE NO. *Mon-338-Red-P*

**REDRILL, PLUGGING CANCEL.**

+ Denotes location of well on United States Topographic Maps, scale 1 to 62,500, latitude and longitude lines being represented by border lines as shown.

- Denotes one inch spaces on border line of original tracing.

*47-061*