

61-00415 A

WW-7
8-30-06

RECEIVED
Office of Oil and Gas

NOV 22 2017

WV Department of
Environmental Protection



West Virginia Department of Environmental Protection
Office of Oil and Gas
WELL LOCATION FORM: GPS

API: 47-061-00415 WELL NO.: WV 651636 (Stephens #570)

FARM NAME: Grant Stephens

RESPONSIBLE PARTY NAME: EQT Production Company

COUNTY: Monongalia DISTRICT: Clay

QUADRANGLE: Blacksville 7.5'

SURFACE OWNER: Albert Statler

ROYALTY OWNER: Piney Holdings, Inc.

UTM GPS NORTHING: 4393963

UTM GPS EASTING: 573792 GPS ELEVATION: 315 m (1034 ft)

The Responsible Party named above has chosen to submit GPS coordinates in lieu of preparing a new well location plat for a plugging permit or assigned API number on the above well. The Office of Oil and Gas will not accept GPS coordinates that do not meet the following requirements:

1. Datum: NAD 1983, Zone: 17 North, Coordinate Units: meters, Altitude: height above mean sea level (MSL) – meters.
2. Accuracy to Datum – 3.05 meters
3. Data Collection Method:

Survey grade GPS _____ : Post Processed Differential _____

Real-Time Differential _____

Mapping Grade GPS X : Post Processed Differential X

Real-Time Differential _____

4. **Letter size copy of the topography map showing the well location.**

I the undersigned, hereby certify this data is correct to the best of my knowledge and belief and shows all the information required by law and the regulations issued and prescribed by the Office of Oil and Gas.

Stacy Obermeyer
Signature

PS # 2180
Title

10/26/17
Date

02/16/2018

Topo Quad: Blacksville 7.5'
County: Monongalia
District: Clay


Scale: 1" = 2000'
Date: October 5, 2017
Project No: 72-20-00-08

RECEIVED
Office of Oil and Gas
NOV 22 2017
WV Department of
Environmental Protection

Water

47-061-00415 WV 651636 (Stephens #570)

3 Potential Water Sources within 1000'

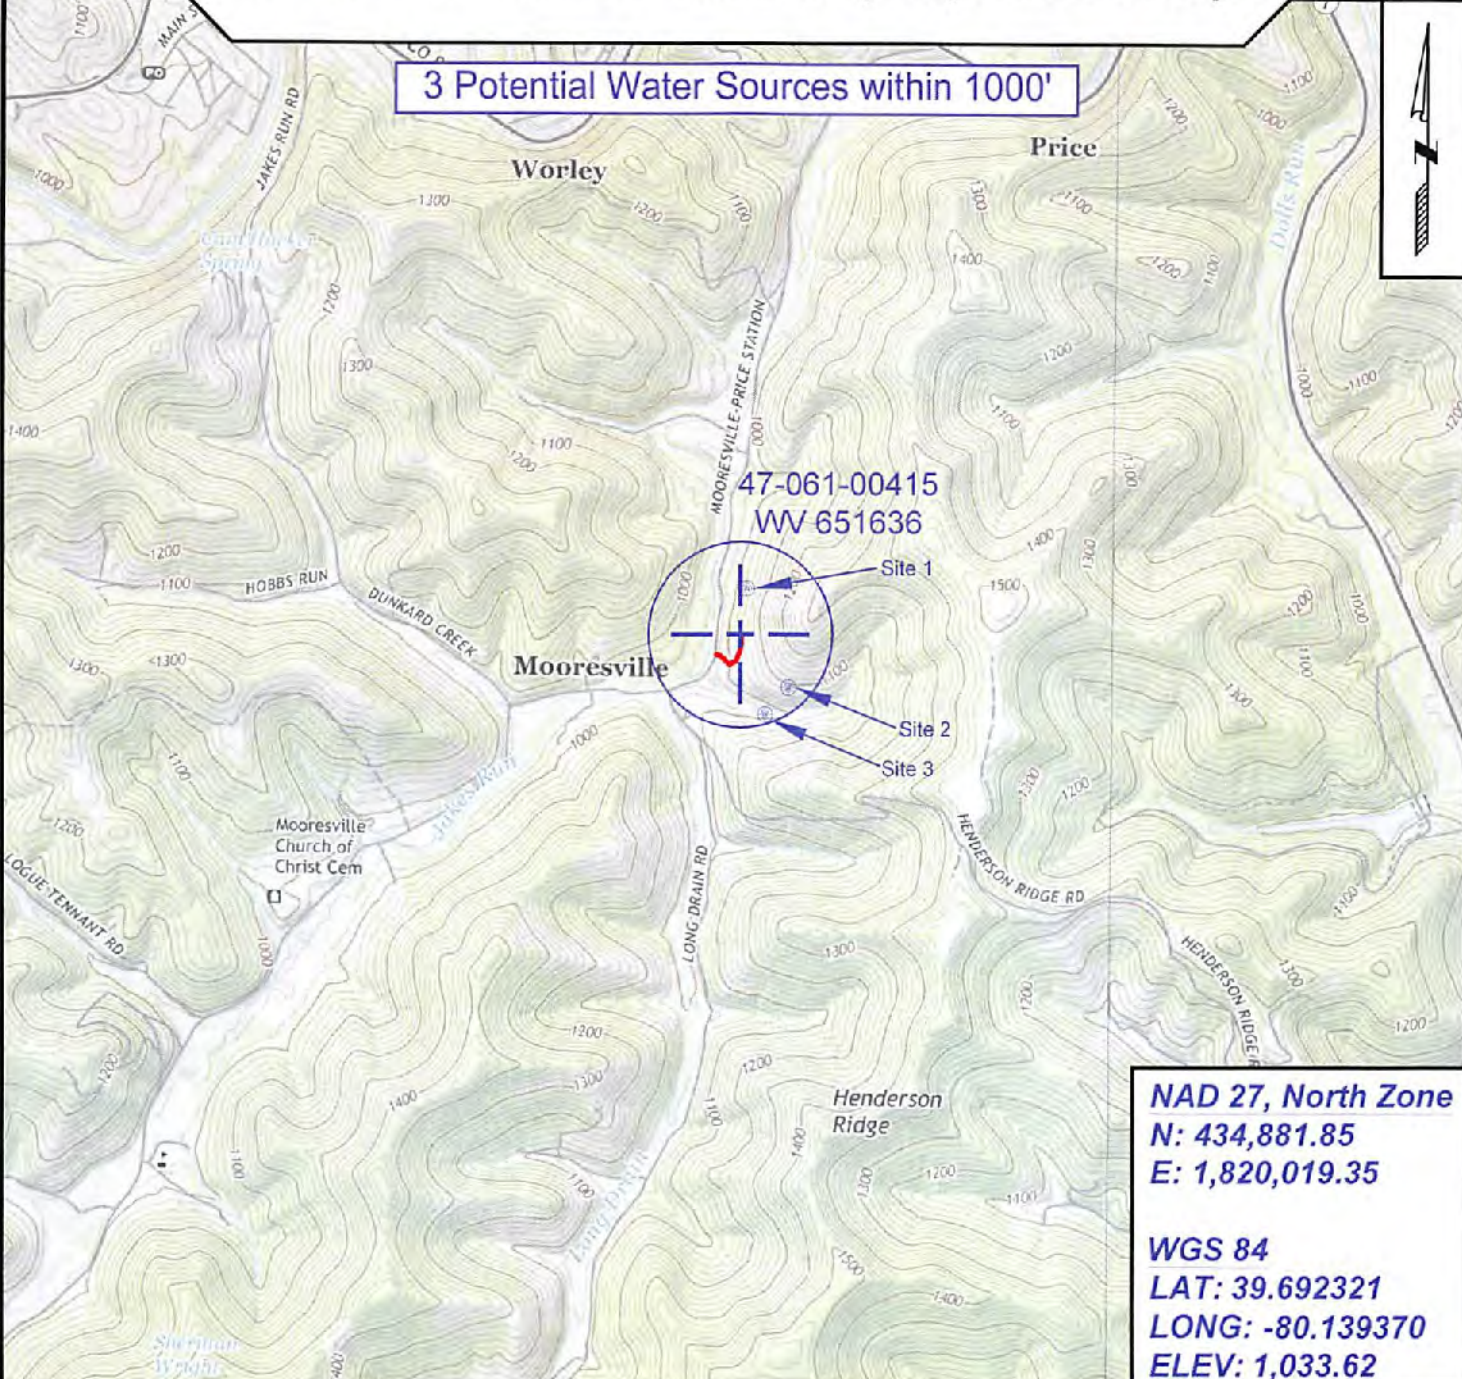

NAD 27, North Zone
N: 434,881.85
E: 1,820,019.35

WGS 84
LAT: 39.692321
LONG: -80.139370
ELEV: 1,033.62



SURVEYING AND MAPPING SERVICES PERFORMED BY:
ALLEGHENY SURVEYS, INC.
1-800-482-8606
237 Birch River Road
Birch River, WV 26610
PH: (304) 649-8606
FAX: (304) 649-8608

PREPARED FOR:
EQT Production Company
P.O. Box 280
Bridgeport, WV 26330