


LATITUDE 39° 40' 00"

00° 01' 08" LONGITUDE

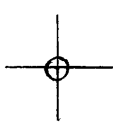

7'5 OGIS topo location

7.5' loc 2.12 S 15' loc \_\_\_\_\_  
' 1.73 W (calc.) \_\_\_\_\_

Company \_\_\_\_\_

Farm \_\_\_\_\_


Quad BLACKSVILLE 7 1/2'

County MONONGALIA

District CLAY

WELL LOCATION MAP

File No. OGI - 0490

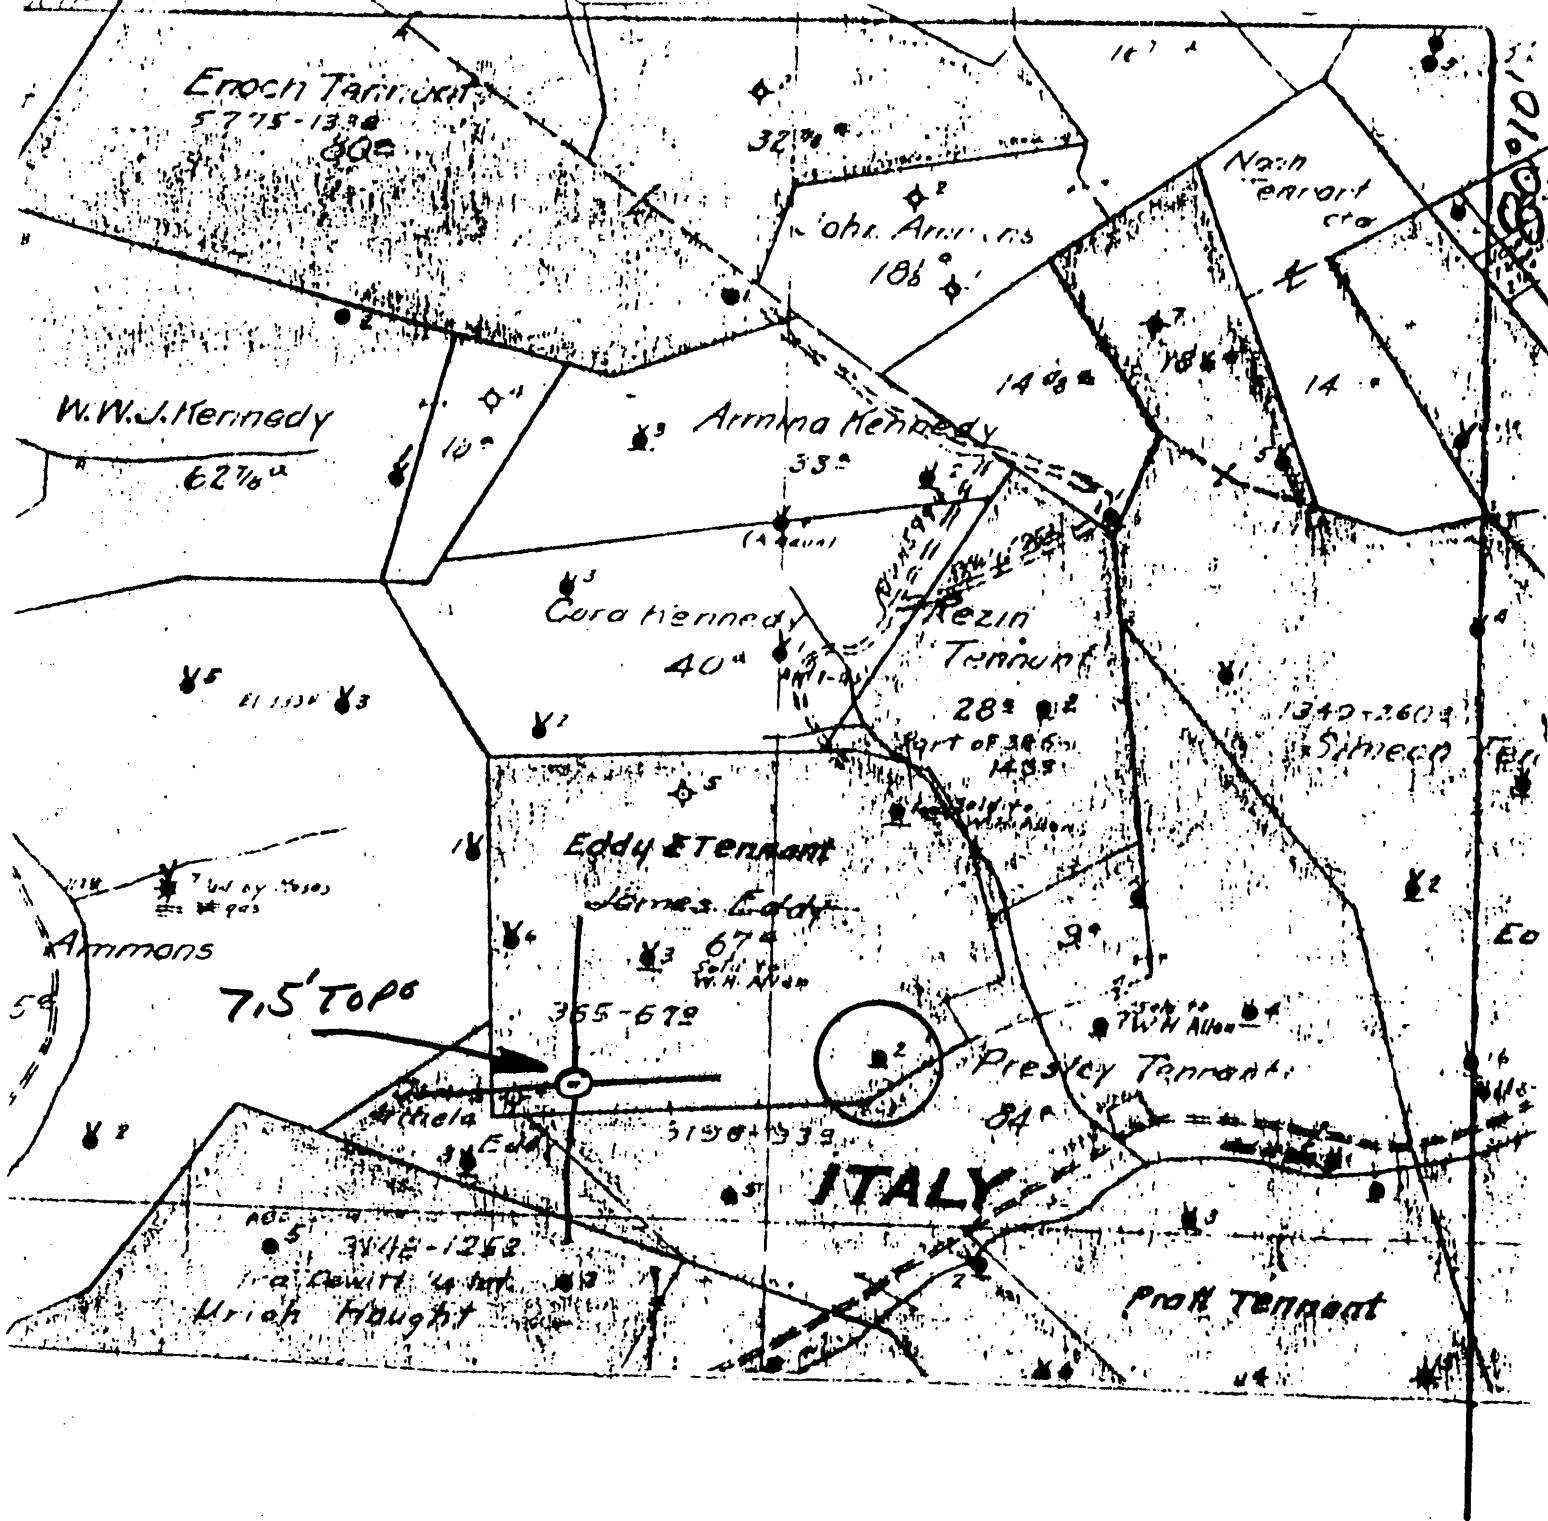

+ DENOTES LOCATION OF WELL ON UNITED STATES TOPOGRAPHIC MAPS

FORM IV-6  
(8-78)

172E N12E23



STATE OF WEST VIRGINIA  
DEPARTMENT OF MINES  
OIL AND GAS DIVISION

DATE 1-24- 1979  
OPERATOR'S WELL NO. 2  
API WELL NO. 47-061-0490  
STATE COUNTY PERMIT

WELL TYPE: OIL  GAS \_\_\_\_\_ LIQUID INJECTION \_\_\_\_\_ WASTE DISPOSAL \_\_\_\_\_  
(IF "GAS", PRODUCTION \_\_\_\_\_ STORAGE \_\_\_\_\_ DEEP \_\_\_\_\_ SHALLOW \_\_\_\_\_)  
LOCATION: ELEVATION 169.96 WATER SHED JAKES RUN  
DISTRICT CLAY COUNTY MONONGALIA  
QUADRANGLE BLACKSVILLE 7.5'  
SURFACE OWNER \_\_\_\_\_ ACREAGE \_\_\_\_\_  
OIL & GAS ROYALTY OWNER \_\_\_\_\_ LEASE NO. \_\_\_\_\_ LEASE ACREAGE \_\_\_\_\_  
PROPOSED WORK: DRILL \_\_\_\_\_ CONVERT \_\_\_\_\_ DRILL DEEPER \_\_\_\_\_ REDRILL \_\_\_\_\_ FRACTURE OR STIMULATE \_\_\_\_\_ PLUS OFF OLD FORMATION \_\_\_\_\_ PERFORATE NEW FORMATION \_\_\_\_\_ OTHER PHYSICAL CHANGE IN WELL (SPECIFY) \_\_\_\_\_

PLUG AND ABANDON \_\_\_\_\_ CLEAN OUT AND REPLUG \_\_\_\_\_  
TARGET FORMATION \_\_\_\_\_ ESTIMATED DEPTH \_\_\_\_\_  
WELL OPERATOR Pennzoil Company DESIGNATED AGENT James A. Crews  
ADDRESS P. O. Box 1588 ADDRESS P. O. Box 1588  
Parkersburg, WV 26101 Parkersburg, WV 26101

EDDY & TENNANT - 2

**SOUTH PENN OIL COMPANY—COMPLETION**  
*(James Eddy)*  
 FARM **Eddy & Tennant**

SERIAL NO. \_\_\_\_\_ FARM **Eddy & Tennant** WELL NO. **23-24**  
 ELEVATION \_\_\_\_\_ N. **13** S. \_\_\_\_\_ W. \_\_\_\_\_  
 LEASE NO. \_\_\_\_\_ ACRES **67**  
 WATERS OF **Jakes Run**  
 DISTRICT **Clay** COUNTY **Monongalia** STATE **W. Va.**  
 DRILLING COMMENCED **7/5/92** COMPLETED **12/14/92** DEPTH **2064'±**

SANDS	TOP	BOTTOM	ELEV. TOP	CASING HEAD
PGH. COAL	<b>640'</b>			<b>10"</b> <b>666'</b>
<b>Big Injun</b>	<b>1967'</b>			<b>8 1/2"</b> <b>786'</b>
<b>1st. Pay</b>	<b>2040'</b>			<b>6.5/8"</b> <b>1740'</b>
				<b>5.3/16"</b> <b>240'</b>
				PACKERS AND DEPTH SET

INITIAL PROD. **No record** SAND **Big Injun** DEPTH **2040'**  
 GAS TEST **No**  
 SHOT **7** QUARTS **4 to 40.**  
 REMARKS **Not drilled through Big Injun.**  
 REPORTED BY *[Signature]* ABANDONED

CGI-1190