


LATITUDE 39° 42' 30"

1,350

4,350

LONGITUDE 80° 15' 00"

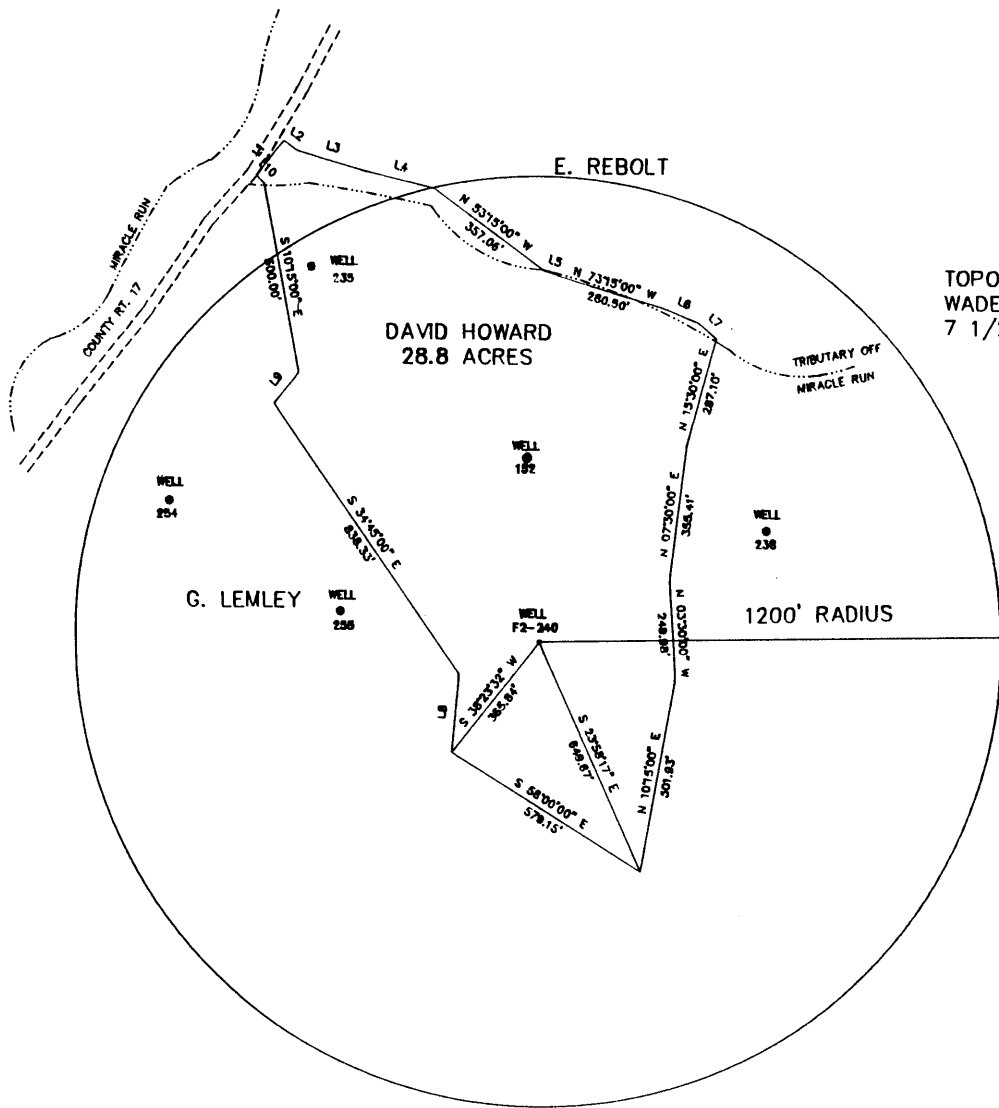

TOPO. LOC. WADESTOWN QUAD. 7 1/2' SERIES

0.945
0.216

LINE	DIRECTION	DISTANCE
L1	S 32°50'00" W	120.00'
L2	N 35°20'00" W	42.57'
L3	N 74°00'00" W	178.03'
L4	N 78°00'00" W	145.77'
L5	N 70°25'00" W	38.30'
L6	N 67°45'00" W	88.00'
L7	N 48°45'00" W	88.00'
L8	S 43°30'00" W	251.50'
L9	S 38°00'00" W	103.00'
L10	S 47°45'00" E	60.00'

FILE NO. F2-1-196
 DRAWING NO. F2-2-236
 SCALE 1" = 500'
 MINIMUM DEGREE OF ACCURACY 1/2500'
 PROVEN SOURCE OF ELEVATION USGS B.M.

I THE UNDERSIGNED, HEREBY CERTIFY THAT THIS PLAT IS CORRECT TO THE BEST OF MY KNOWLEDGE AND BELIEF AND SHOWS ALL THE INFORMATION REQUIRED BY LAW AND THE REGULATIONS ISSUED AND PRESCRIBED BY THE DEPARTMENT OF MINES.

(SIGNED) John F. Ewell, Jr.
 R.P.E. 11132 L.L.S. _____

PLACE SEAL HERE

(+) DENOTES LOCATION OF WELL ON UNITED STATES TOPOGRAPHIC MAPS

DATE NOVEMBER 23, 19 91
 OPERATOR'S WELL NO F2-240
 API WELL NO.

FORM IV-6
(8-78)

STATE OF WEST VIRGINIA
 DEPARTMENT OF MINES
 OIL AND GAS DIVISION

47-061-0501-P
 STATE COUNTY PERMIT

WELL TYPE: OIL X GAS _____ LIQUID INJECTION _____ WASTE DISPOSAL _____
 (IF "GAS", PRODUCTION _____ STORAGE _____ DEEP _____ SHALLOW X _____)
 LOCATION: ELEVATION 1169 WATERSHED TRIBUTARY OFF MIRACLE RUN
DISTRICT BATTLE COUNTY MONONGALIA
QUADRANGLE WADESTOWN
 SURFACE OWNER DAVID HOWARD ACREAGE 28.8
 OIL & GAS ROYALTY OWNER SOUTH PENN OIL CO. LEASE ACREAGE 28.8
 LEASE NO. N/A
 PROPOSED WORK: DRILL _____ CONVERT _____ DRILL DEEPER _____ REDRILL X FRACTURE OR
 STIMULATE _____ PLUG OFF OLD FORMATION _____ PERFORATE NEW
 FORMATION _____ OTHER PHYSICAL CHANGE IN WELL (SPECIFY) _____
 PLUG AND ABANDON X CLEAN OUT AND REPLUG _____
 TARGET FORMATION BIG INJUN ESTIMATED DEPTH 2331
 WELL OPERATOR EASTERN ASSOC. COAL DESIGNATED AGENT TERRY O. HENDERSHOT
 ADDRESS ROUTE 1 BOX 144 ADDRESS ROUTE 1 BOX 144
FAIRVIEW WV. 26570 FAIRVIEW WV. 26570

AFFIDAVIT OF PLUGGING AND FILLING WELL 47-061-501-P

AFFIDAVIT SHOULD BE IN TRIPLICATE, one copy mailed to the Division, copy to be retained by the Well Operator and the third copy (and extra copies if required) should be mailed to each coal operator at their respective addresses.

Farm name: HOWARD, DAVID/D.S.LEMLEY Operator Well No.: F2-240

LOCATION: Elevation: 1169.00 Quadrangle: WADESTOWN
District: BATTELLE County: MONONGALIA
Latitude: 4350 Feet South of 39 Deg. 42 Min. 30 Sec.
Longitude 1350 Feet West of 80 Deg. 15 Min. 0 Sec.

Well Type: OIL X GAS

Company: Eastern Associated Coal Corp.
Route 1 - Box 144
Fairview, WV 26570

Coal Operator Eastern Assoc. Coal Corp.
or Owner Route 1 - Box 144
Fairview, WV 26570

Agent: Terry O. Hendershot

Coal Operator or Owner **RECEIVED**
WV Division of Environmental Protection

Permit Issued: 12/02/91

MAR 27 92

AFFIDAVIT

STATE OF WEST VIRGINIA,
County of Monongalia

ss:

Permitting
Office of Oil & Gas

David Chisler and Melvin Eddy be first duly sworn according to law depose and say that they are experienced in the work of plugging and filling oil and gas wells and were employed by the above named well operator, and participated in the work of plugging and filling the above well, and Rondal Mick Oil and Gas Inspector representing the Director, say that said work commenced on the 6th day of February, 1992, and that the well was plugged and filled in the following manner:

TYPE	FROM	TO	PIPE REMOVED	LEFT
Pulled all rods and 2" tubing.	Pulled 5" and 7" together	1667'.	Run tubing	2230'.
Run 15 sks. gell and 164	sks. cement. 1	pp cement 1770'	Fished out 62' of 7" and	
325' of 5". Pulled 8" pipe	1026'. Run	tubing to 1686'	Run 5 sks. gell and 100 sks.	
cement, top cement 1370'	Run 303' of 3"	and 1067' of 4 1/2" pipe.	Ripped old 10" pipe	
from 940' to 960', pulled	383' of old 10"	Run 5 sks.	gell and 600 sks. Portland and	
200 sks. Chem. Comp. Cement,	pumped latch down, plug	to 1067' cement circulated.		
Bailed water out inside 4 1/2"	and checked plug -- OK.			
Pittsburgh Coal 948' to 956'.				

Description of monument: 4 1/2" x 2" Swedge, metal plate with API# and date plugged
and that the work of plugging and filling said well was completed the 29th day of February, 1992.

And further deponents saith not.

Sworn and subscribe before me this 12th day of March, 1992.
My commission expires: June 17, 1997

David Chisler
Melvin R Eddy
William J. LITTLE
Notary Public

Oil and Gas Inspector: Rondal Mick

MAR 3 1992