

LATITUDE 39° 40' 00"

00° 01' 00" LONGITUDE



7'5 OGIS topo location

7.5' 10C 1.26 S 15' 10C _____
' 1.44 W (calc.) _____

Company _____

Farm _____

Quad BLACKSVILLE 7 1/2'

County MONONGALIA


District CLAY

Obs. 1340 ± (TOPO)

WELL LOCATION MAP

File No. 061-0517

34440

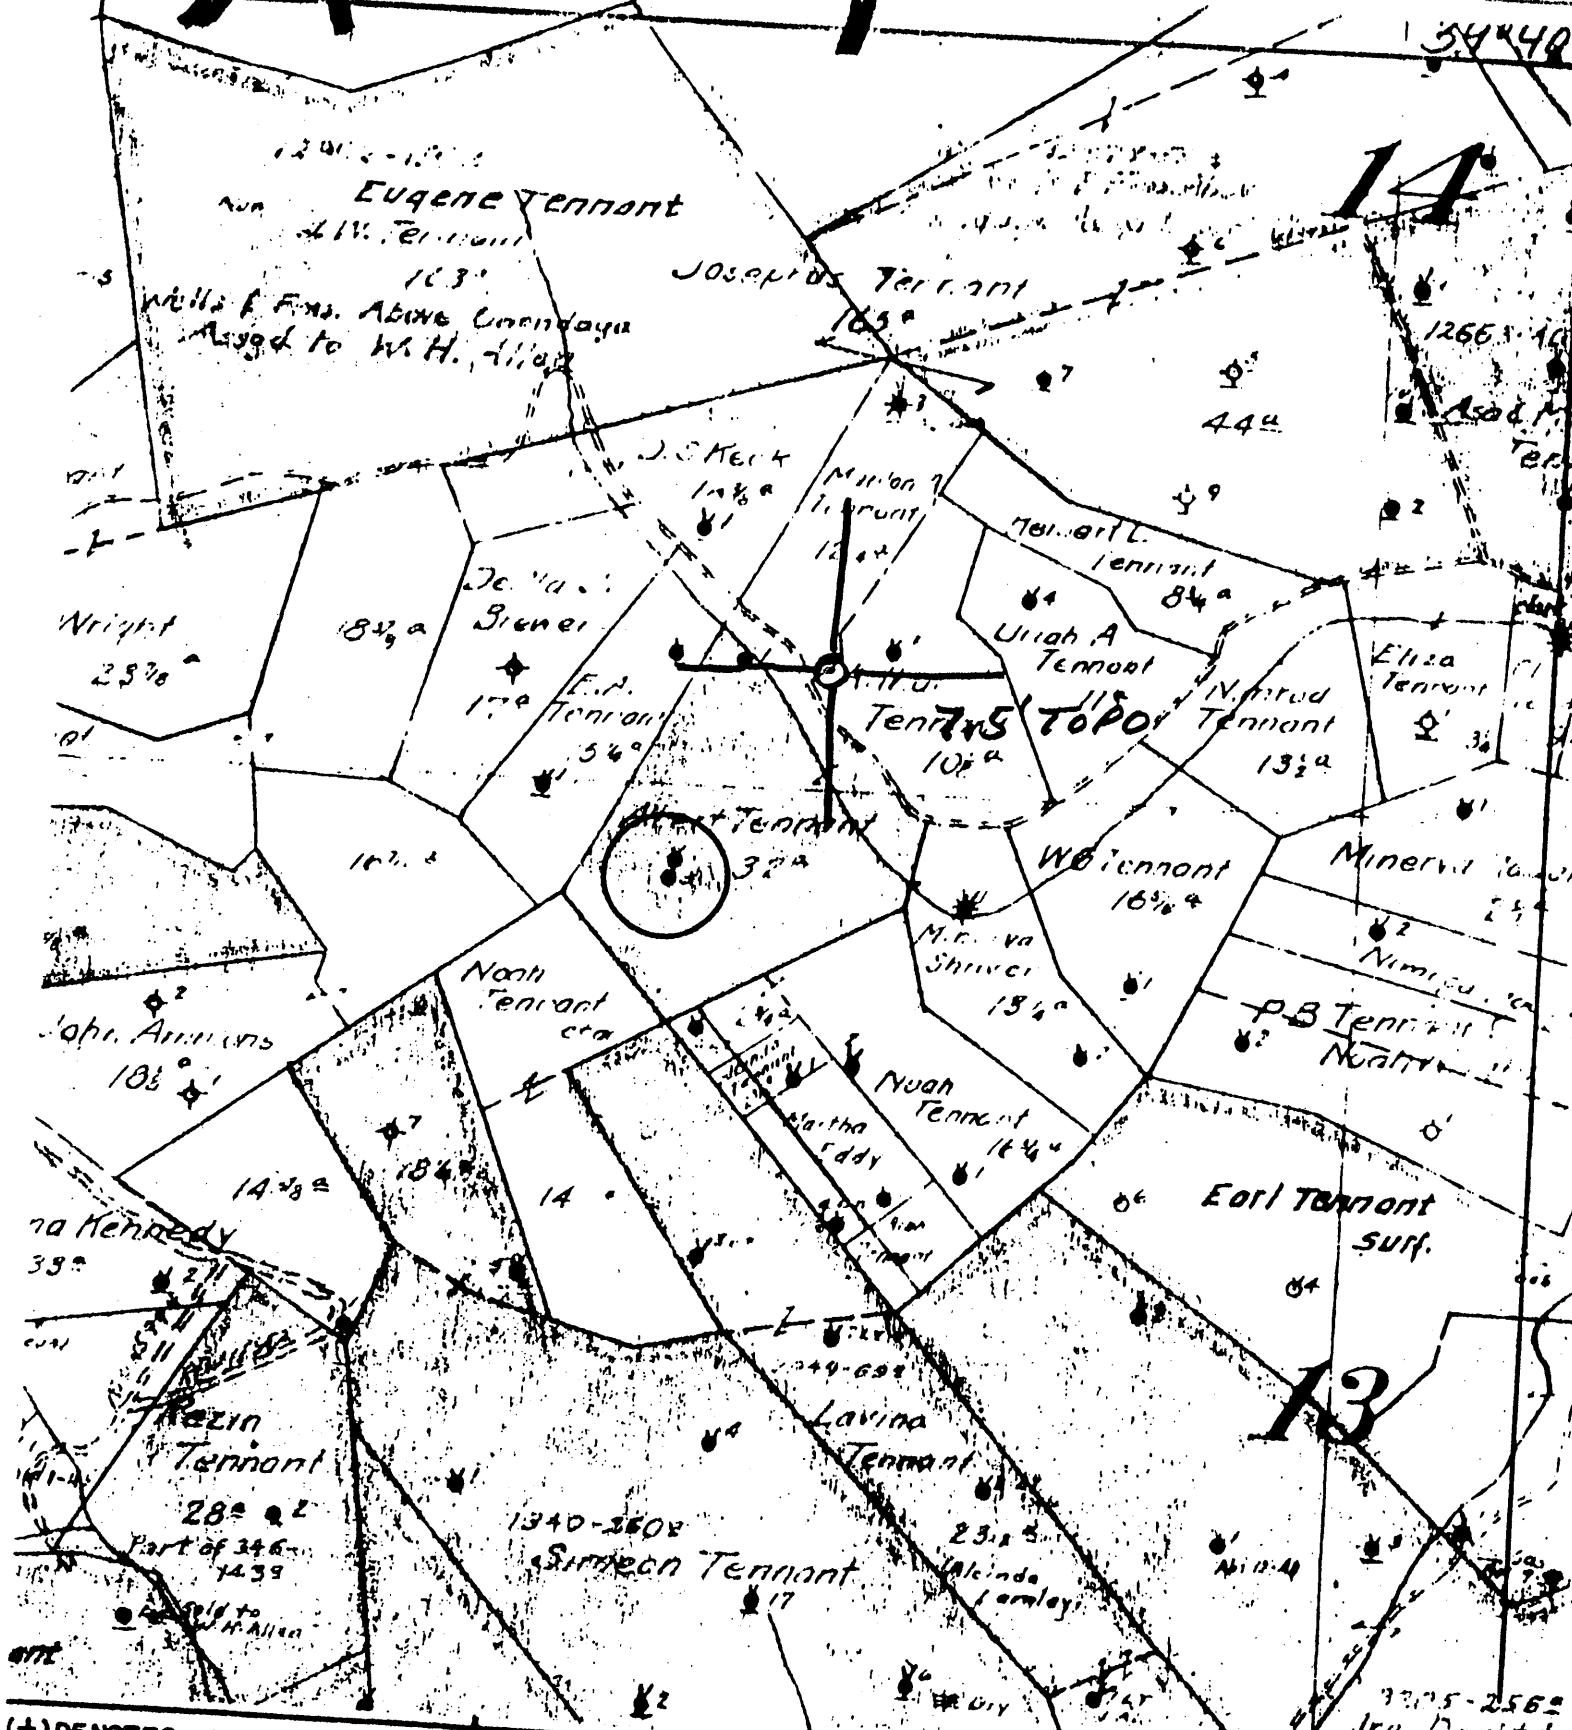

(+) DENOTES LOCATION OF WELL ON UNITED STATES TOPOGRAPHIC MAPS
 FORM IV-6
 (8-78)
 N72E N13 E24



DATE 1-24-1979
 OPERATOR'S WELL NO. 3
 API WELL NO. 47-061-0517
 STATE COUNTY PERMIT

STATE OF WEST VIRGINIA
 DEPARTMENT OF MINES

WELL TYPE: OIL GAS LIQUID INJECTION WASTE DISPOSAL
 (IF "GAS", PRODUCTION STORAGE DEEP SHALLOW
 LOCATION: ELEVATION _____ WATER SHED _____ LAKES RUI
 DISTRICT _____ QUADRANGLE BLACKS VILLE T.S. COUNTY MONONGALIA
 SURFACE OWNER _____
 OIL & GAS ROYALTY OWNER _____ ACREAGE _____
 PROPOSED WORK: DRILL CONVERT DRILL DEEPER REDRILL FRACTURE OR
 STIMULATE PLUS OFF OLD FORMATION PERFORATE NEW
 FORMATION OTHER PHYSICAL CHANGE IN WELL (SPECIFY) _____
 LEASE NO. _____ LEASE ACREAGE _____
 PLUS AND ABANDON CLEAN OUT AND REPLUG
 TARGET FORMATION _____ ESTIMATED DEPTH _____
 WELL OPERATOR Pennzoil Company DESIGNATED AGENT James A. Crews
 ADDRESS P. O. Box 1588 ADDRESS P. O. Box 1588
Parkersburg, WV 26101 Parkersburg, WV 26101

Hubert Tennant - 3

No. 1

SOUTH PENN OIL COMPANY—COMPLETION

SERIAL NO. _____ FARM Tennant Albert WELL NO. 3
 ELEVATION _____ N. 13-14 E. 2A W. _____
 LEASE NO. 366 ACRES 32 1/4
 WATERS OF Jakes Run
 DISTRICT Clay COUNTY Monongalia STATE W. Va.
 DRILLING COMMENCED 6/2/1894 COMPLETED 8/8/1894 DEPTH 224 1/2'

BANDS	TOP	BOTTOM	ELEV. TOP	CASING USED
POH. COAL ON S.M. R.W. N.	810			10" 820
Big Injun	2120			8 1/2" 835
1st pay Good	2224			6.5/8 1820
				5.3/16 274

INITIAL PROD. No record 1066' SAND Big Injun DEPTH 2224
 GAS TEST No

SHOT 1 QUARTS 20

REMARKS (Not drilled through Big Injun)

REPORTED BY J. M. Meador ABANDONED

97-061-0517