

WW-7  
8-30-06



West Virginia Department of Environmental Protection  
Office of Oil and Gas  
**WELL LOCATION FORM: GPS**

API: 47-061-00518 WELL NO.: 1  
FARM NAME: Alpha Tennant  
RESPONSIBLE PARTY NAME: NNE Resources LLC  
COUNTY: Monongalia DISTRICT: Clay  
QUADRANGLE: Blacksville, WV  
SURFACE OWNER: Samuel A. and Rachel Rae Holmes  
ROYALTY OWNER: E. Pauline Jackson et al  
UTM GPS NORTHING: 4387657.0  
UTM GPS EASTING: 570542.0 GPS ELEVATION: 1070'

The Responsible Party named above has chosen to submit GPS coordinates in lieu of preparing a new well location plat for a plugging permit or assigned API number on the above well. The Office of Oil and Gas will not accept GPS coordinates that do not meet the following requirements:

1. Datum: NAD 1983, Zone: 17 North, Coordinate Units: meters, Altitude: height above mean sea level (MSL) – meters.
2. Accuracy to Datum – 3.05 meters
3. Data Collection Method:

Survey grade GPS : Post Processed Differential   
Real-Time Differential

Mapping Grade GPS : Post Processed Differential   
Real-Time Differential

RECEIVED  
Office of Oil and Gas

SEP 28 2015

WV Department of  
Environmental Protection

4. Letter size copy of the topography map showing the well location.

I the undersigned, hereby certify this data is correct to the best of my knowledge and belief and shows all the information required by law and the regulations issued and prescribed by the Office of Oil and Gas.

Helli M. Medley  
Signature


Regulatory Coordinator  
Title

9/25/2015  
Date



XMap® 7

ALPHA TENNANT NO. 1  
 UTM NAD 83:  
 Easting: 570542.0  
 Northing: 4387657.0  
 Blacksville 7.5' USGS Quad

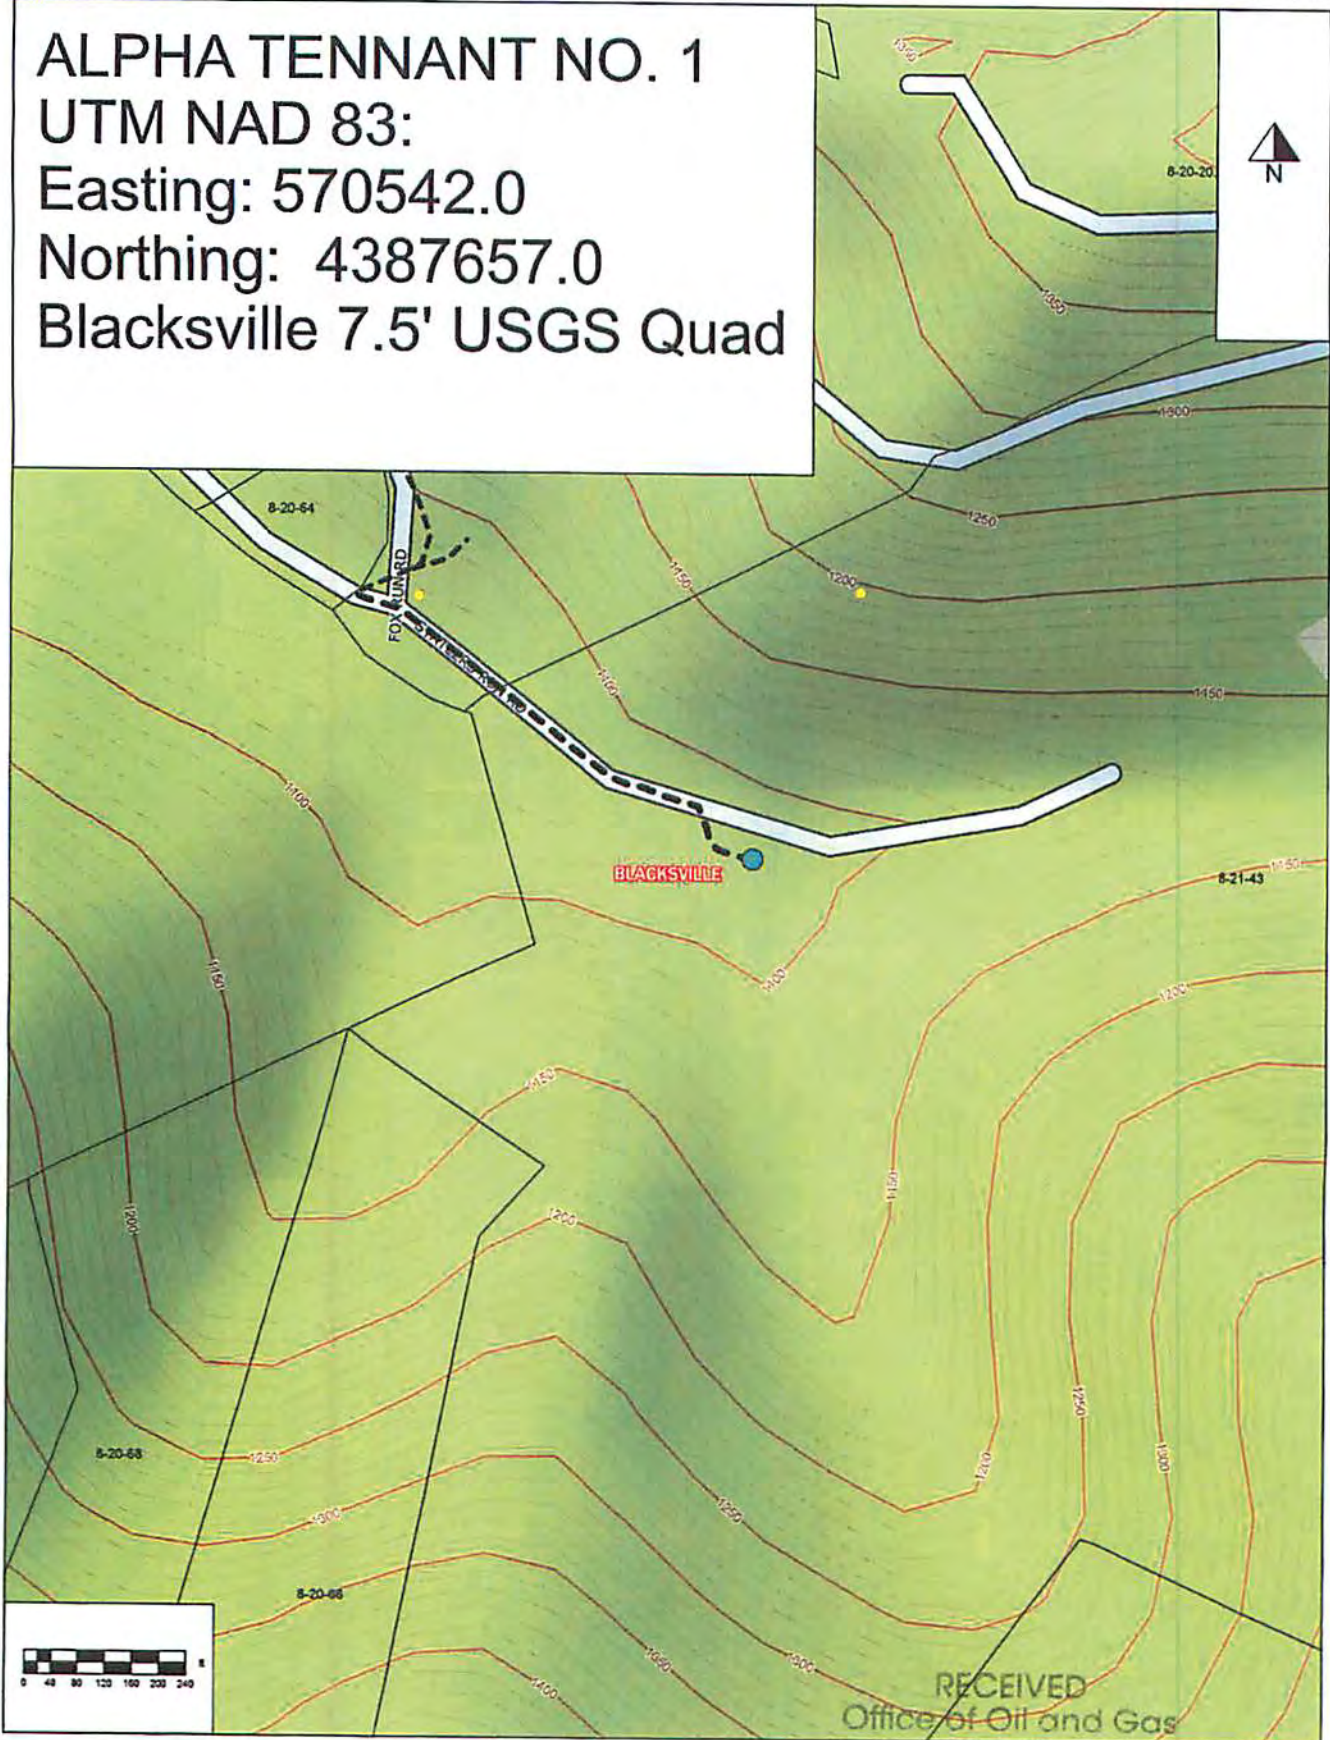

Data use subject to license.

© DeLorme. XMap® 7.

www.delorme.com

SEP 28 2015

WV Department of Environmental Protection 10/02/2015