


Latitude

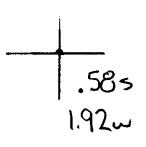

Longitude


Topo Location

7.5' Loc. _____ 15' Loc. _____
 _____ (calc.) _____

Company Pennzoil
Farm Nancy Tennant 4
(James A. Crows #4)
15' Quad _____
 (sec.) _____
7.5' Quad Blacksville
District Clay

WELL LOCATION PLAT

County 061 **Permit** 532

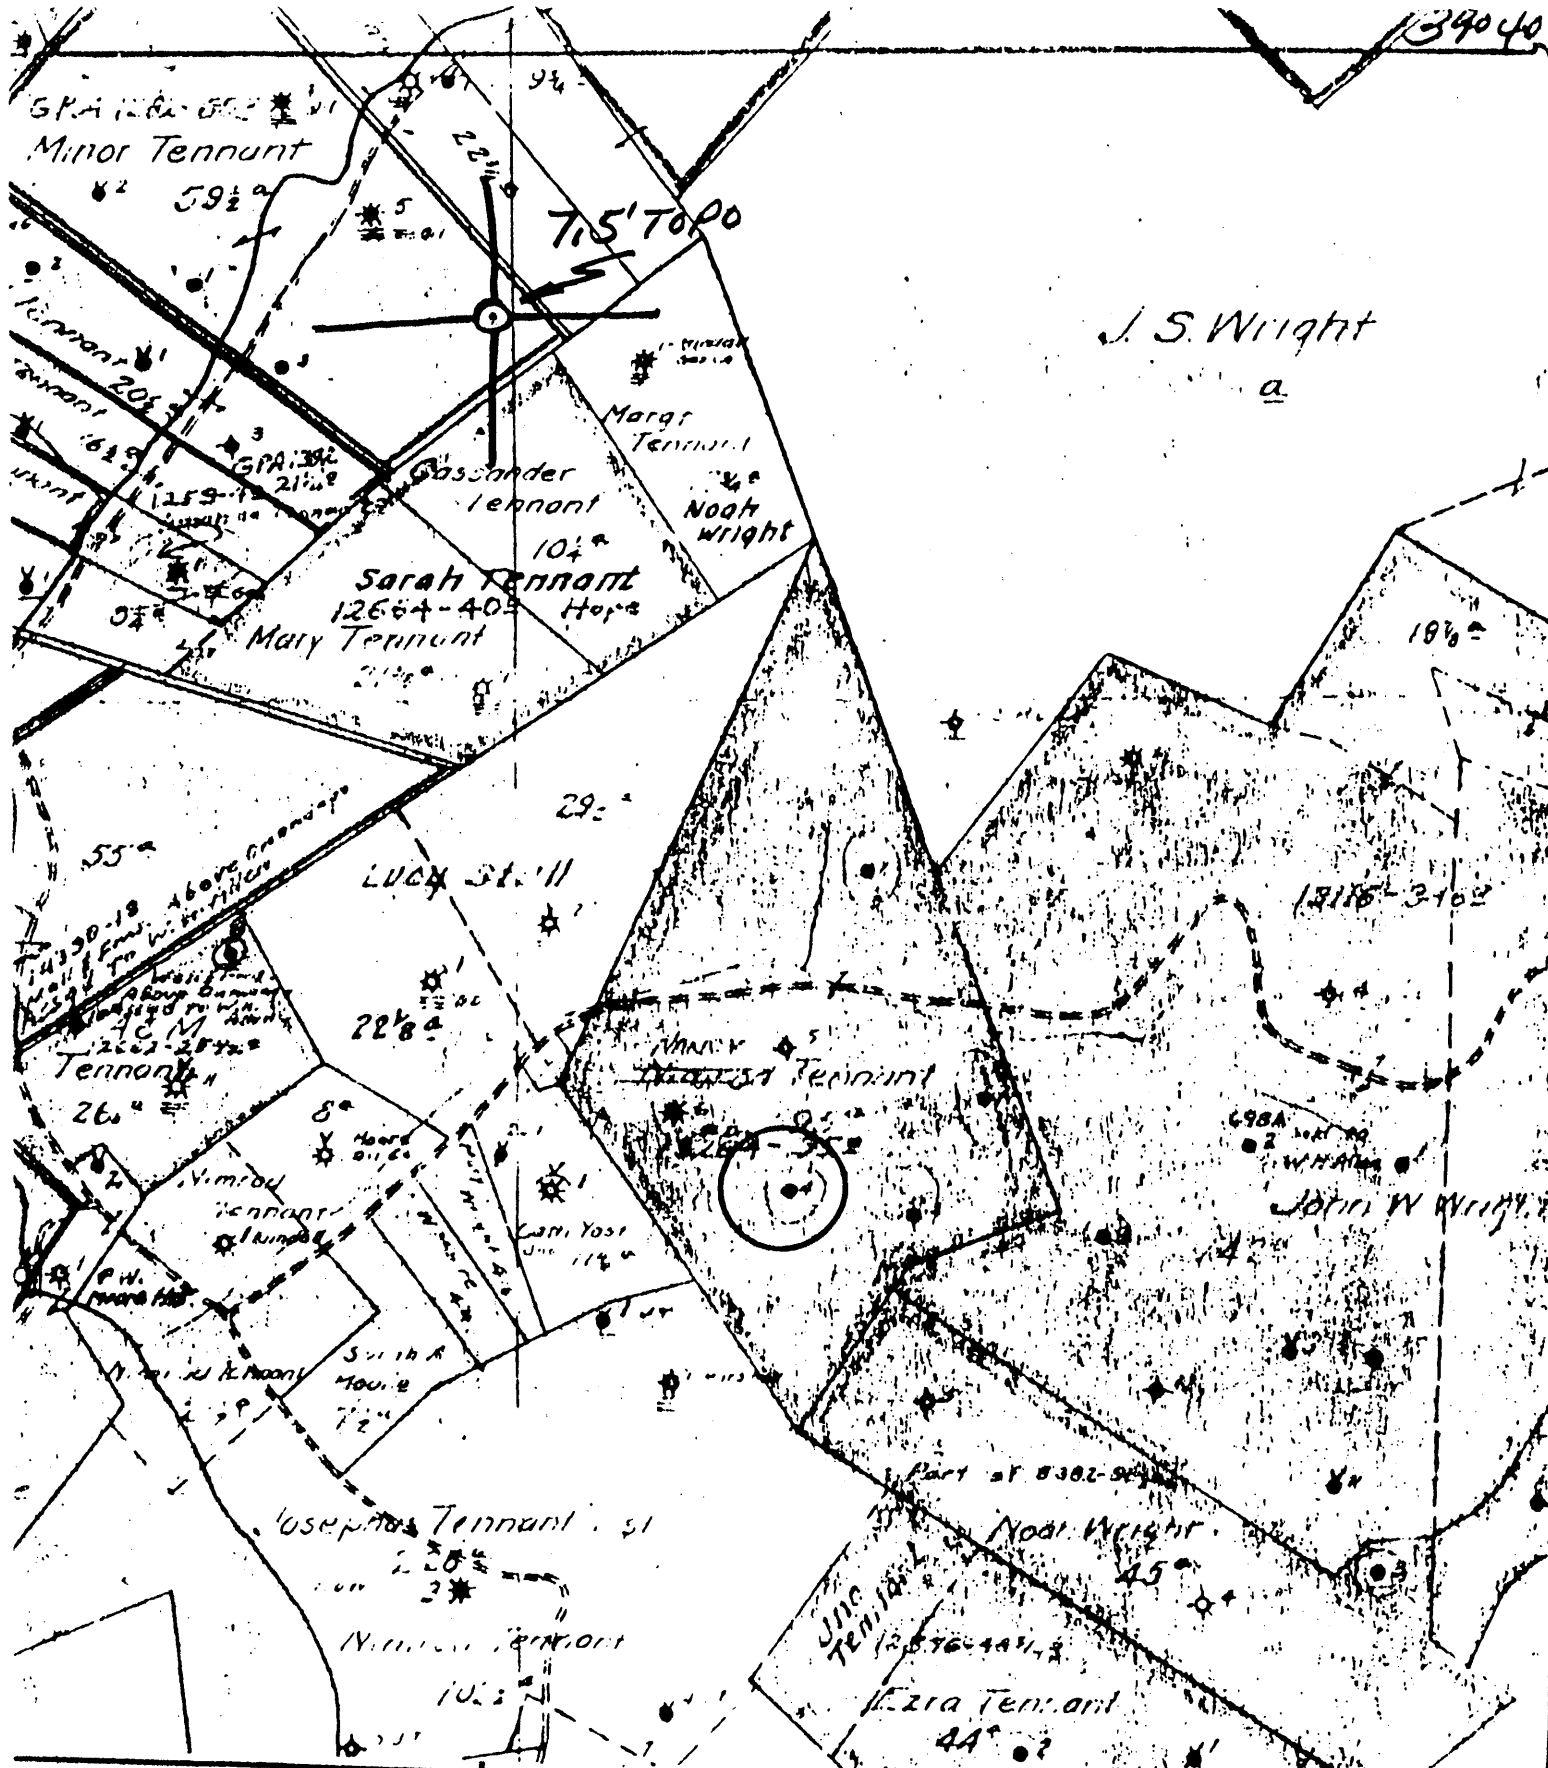

J. S. Wright
a

(+) DENOTES LOCATION OF WELL ON UNITED STATES TOPOGRAPHIC MAPS

FORM IV-6
(8-78)
V72E N4 E26



STATE OF WEST VIRGINIA
DEPARTMENT OF MINES

DATE 1-24-1979
OPERATOR'S WELL NO. 4
API WELL NO. 47-061-0532
STATE COUNTY PERMIT

WELL TYPE: OIL GAS LIQUID INJECTION WASTE DISPOSAL
(IF GAS, PRODUCTION STORAGE DEEP SHALLOW
LOCATION: ELEVATION _____ WATER SHED JAKES RUN
DISTRICT CLAY COUNTY MONONGALIA
QUADRANGLE BLACKSVILLE 7.5'

SURFACE OWNER _____ ACREAGE _____
OIL & GAS ROYALTY OWNER _____ LEASE NO. _____ LEASE ACREAGE _____

PROPOSED WORK: DRILL CONVERT DRILL DEEPER REDRILL FRACTURE OR STIMULATE PLUS OFF OLD FORMATION PERFORATE NEW FORMATION OTHER PHYSICAL CHANGE IN WELL (SPECIFY) _____

PLUG AND ABANDON CLEAN OUT AND REPLUG
TARGET FORMATION _____ ESTIMATED DEPTH _____
WELL OPERATOR Pennzoil Company DESIGNATED AGENT James A. Crews
ADDRESS P. O. Box 1588 ADDRESS P. O. Box 1588
Parkersburg, WV 26101 Parkersburg, WV 26101

ANCY TENNANT - 4

SOUTH PENN OIL COMPANY—COMPLETION

SERIAL NO. _____ FARM Tennant Nancy WELL NO. 4
 ELEVATION _____ 14 _____ 26 _____ W
 LEASE NO. _____ ACRES 95
 WATERS OF Jakes Run
 DISTRICT Clay COUNTY Monongalia STATE W. Va.
 DRILLING COMMENCED 3/11/1896 COMPLETED 6/25/1896 DEPTH 2134

SANDS	TOP	BOTTOM	ELEV. TOP	CASING USED
Pgn. Coal on Big Injun	710			10" 730
Big Injun	2030			8 1/2" 1728
1st pay	2116			6 5/8 1840
				5 3/16 2011

PACKERS AND DEPTH SET
 2011' of 5 3/16"
 on B. H. Packer Lark

INITIAL PROD. No record SAND Big Injun DEPTH 2116
 GAS TEST No
 SHOT 7 QUANTS. 10 to 40 qts.
 REMARKS (Not drilled through Big Injun)

REPORTED BY [Signature] ABANDONED _____
 P. O. 524-SM-1

47-061-0532