


1/23/79

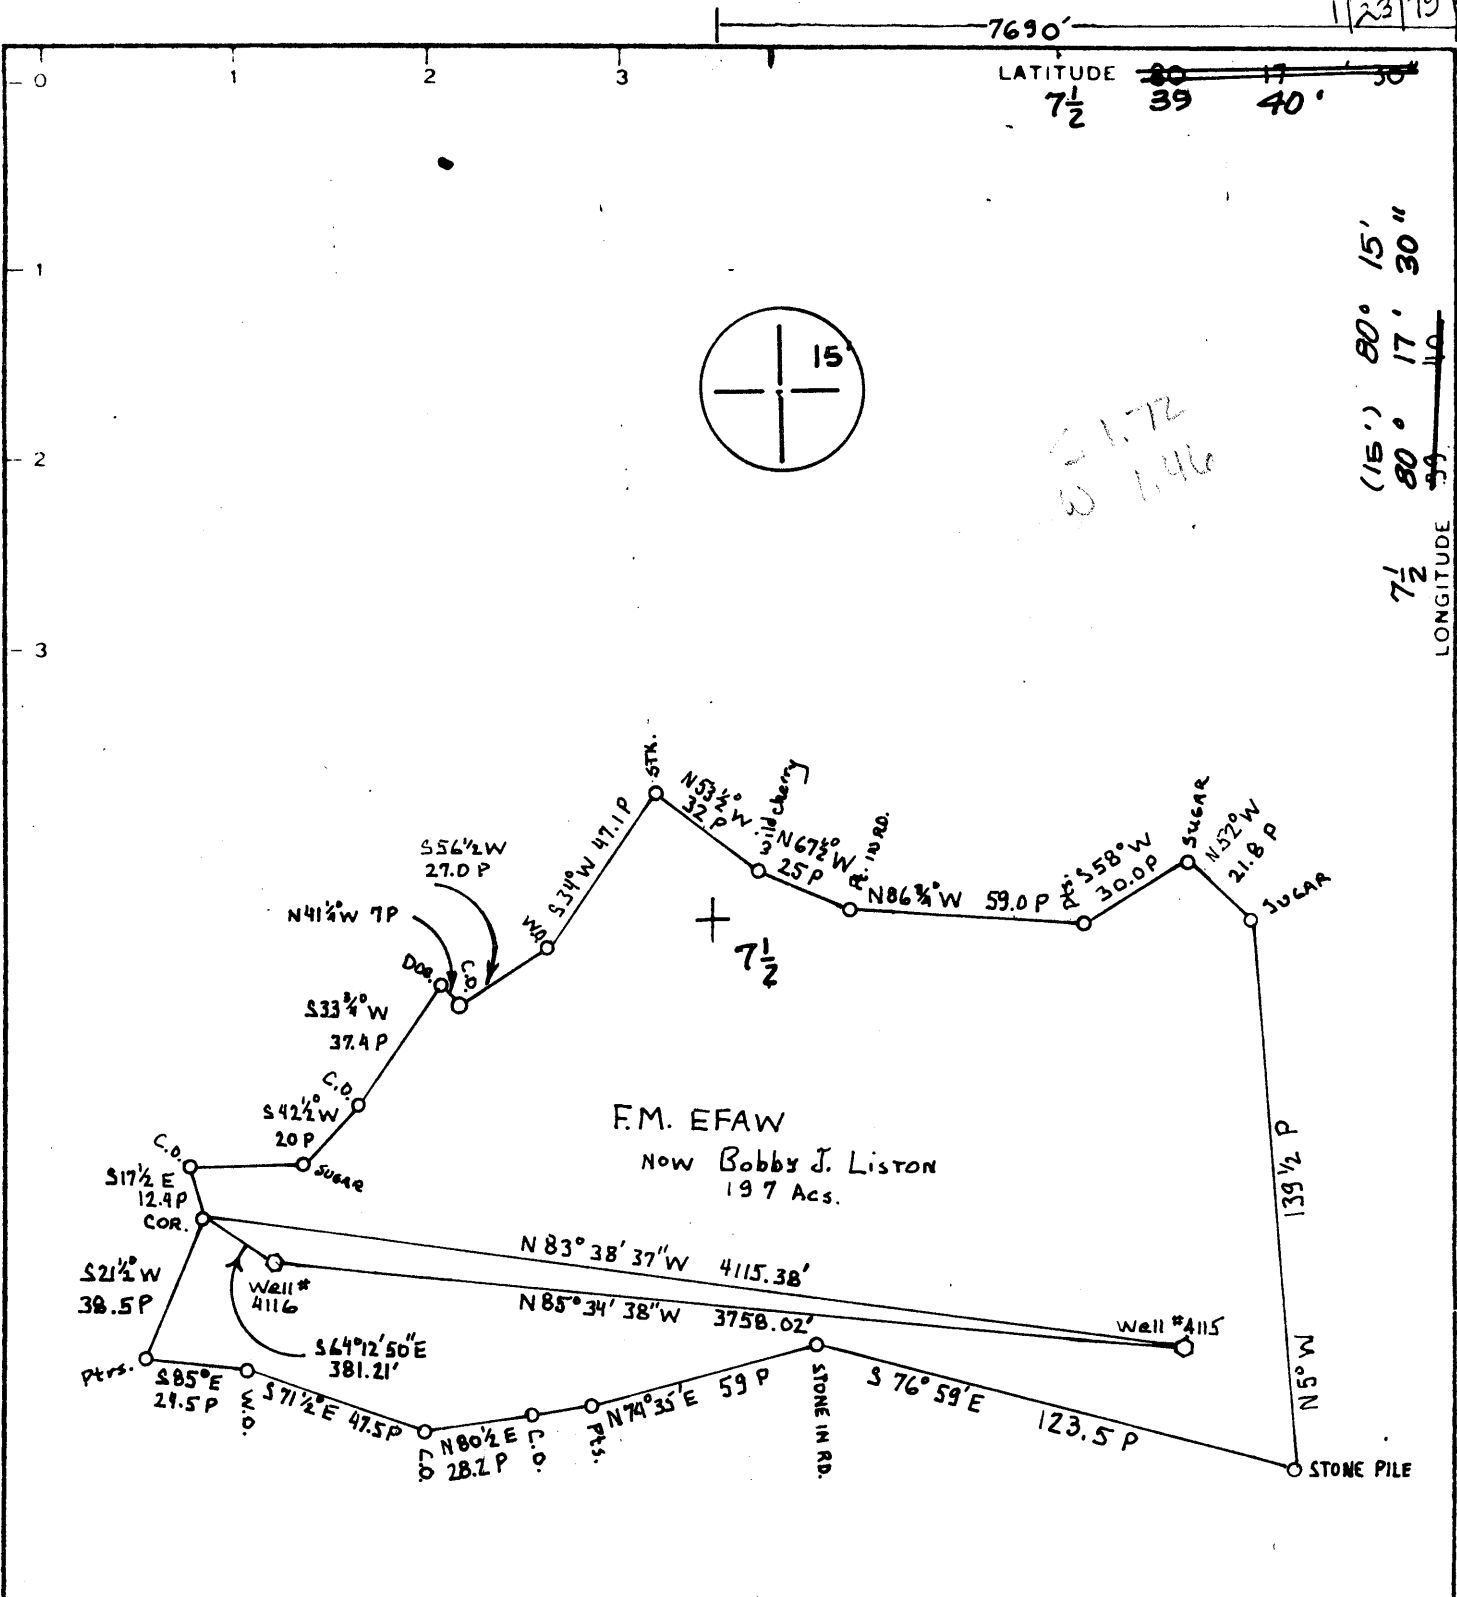

Minimum Error of Closure 1' in 200

Source of Elevation Company survey stations are tied into U.S.G.S. network.

I, the undersigned, hereby certify that this map is correct to the best of my knowledge and belief and shows all the information required by paragraph 6 of the rules and regulations of the oil and gas section of the mining laws of West Virginia

- Fracture
- New Location
- Drill Deeper
- Abandonment

Signed _____
Squares N S E W

Fairmont Operations
 Company Consolidation Coal Company
 Address P.O. Box 1632, Fairmont, WV 26554
 Farm F.M. Efav now B.J. Liston
 Tract Acres 197 Lease No. _____
 Well (Farm) No. Consol 4116 Serial No. _____
 Elevation (Spirit Level) 1450' +/-
 Quadrangle NE/4 Mannington 15'
 County Monongalia District Battelle
 Engineer Ray M. Henderson, P.E.
 Engineer's Registration No. WV 2865
 File No. _____ Drawing No. _____
 Date _____ Scale 1" = 800'

STATE OF WEST VIRGINIA
 DEPARTMENT OF MINES
 OIL AND GAS DIVISION
 CHARLESTON
WELL LOCATION MAP
 FILE NO. **47-061-0580-P**

+ Denotes location of well on United States Topographic Maps, scale 1 to 62,500, latitude and longitude lines being represented by border lines as shown.

- Denotes one inch spaces on border line of original tracing.

FEB 9 1979

STATE OF WEST VIRGINIA
DEPARTMENT OF MINES
OIL AND GAS DIVISION

JUL 22 1980

AFFIDAVIT OF PLUGGING AND FILLING WELL

OIL & GAS DIVISION
DEPT. OF MINES

AFFIDAVIT SHOULD BE MADE IN TRIPLICATE, ONE COPY MAILED TO THE DEPARTMENT OF MINES, THE COPY TO BE RETURNED BY THE WELL OPERATOR AND THE THIRD COPY (AND EXTRA COPIES IF REQUIRED) SHOULD BE MAILED TO EACH COAL OPERATOR AT THEIR RESPECTIVE ADDRESSES.

Consolidation Coal Company
COAL OPERATOR OR OWNER
P.O. Box 1314, Morgantown, WV 26505
ADDRESS
Same
COAL OPERATOR OR OWNER
ADDRESS
LEASE OR PROPERTY OWNER
ADDRESS

Consolidation Coal Company
NAME OF WELL OPERATOR
P.O. Box 1314, Morgantown, WV 26505
COMPLETE ADDRESS
February 10 1980
WELL AND LOCATION
Battelle District
Monongalia County
Well No. Consol No. 4116
F.M. Efav Farm

STATE INSPECTOR SUPERVISING PLUGGING William Blosser, Colfax, WV

AFFIDAVIT

STATE OF WEST VIRGINIA,

County of Monongalia

ss:

David Yost

Larry Yost and David Yost
being first duly sworn according to law depose and say that they are experienced in the work of plugging and filling oil and gas wells and were employed by Consolidation Coal Company, well operator, and participated in the work of plugging and filling the above well, that said work was commenced on the 21 day of January, 19 80, and that the well was plugged and filled in the following manner:

SAND OR ZONE RECORD FORMATION	FILLING MATERIAL	PLUGS USED SIZE & KIND	CASING	
			CSG PULLED	CSG LEFT IN
Cleaned out wellbore to 2346'. Pulled 7" casing from 902' to 1802'. Ran vent pipe through Pittsburgh coal as follows: 2 2/3 pipe from 1782 - 1400'. 2" x 4 1/2 swadge at 1399'. 4 1/2" casing from 1399' to surface. Float collar and latch down plug at 1380'.				
Pumped through vent pipe 235 sacks thixotropic cement from 1782' - 1240' and 800 sacks Pozzmix cement 1240 - 0. Pumped latch down wiper plug to seat at 1380'.				
COAL SEAMS	DESCRIPTION OF MONUMENT			
(NAME) Pittsburgh 1230 - 1287.	Five feet 4 1/2" casing above surface. Plaque on 4 1/2" monument states:			
(NAME)	Consolidation Coal Company Well			
(NAME)	No. 4116 47-061-0580-P			

and that the work of plugging and filling said well was completed on the 4th day of February, 19 80.

And further deponents saith not.

Larry Yost
David Yost
Cornelia M. Quinn
Notary Public

Sworn to and subscribed before me this 17 day of July, 19 80.

My commission expires: Oct 6 1985

Permit No. 061-0580-P