


LATITUDE 39° 40' 00"

9

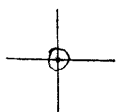

80° 07' 30"

LONGITUDE

7.5 OGIS topo location

7.5' loc 0.675 15' loc \_\_\_\_\_  
                  2.06 w (calc.) \_\_\_\_\_

Company \_\_\_\_\_

Farm \_\_\_\_\_

Quad BLACKSVILLE 7 1/2'


County MONONGALIA

District CLAY

Clay 1330± (top)


### WELL LOCATION MAP

File No. 061-0611

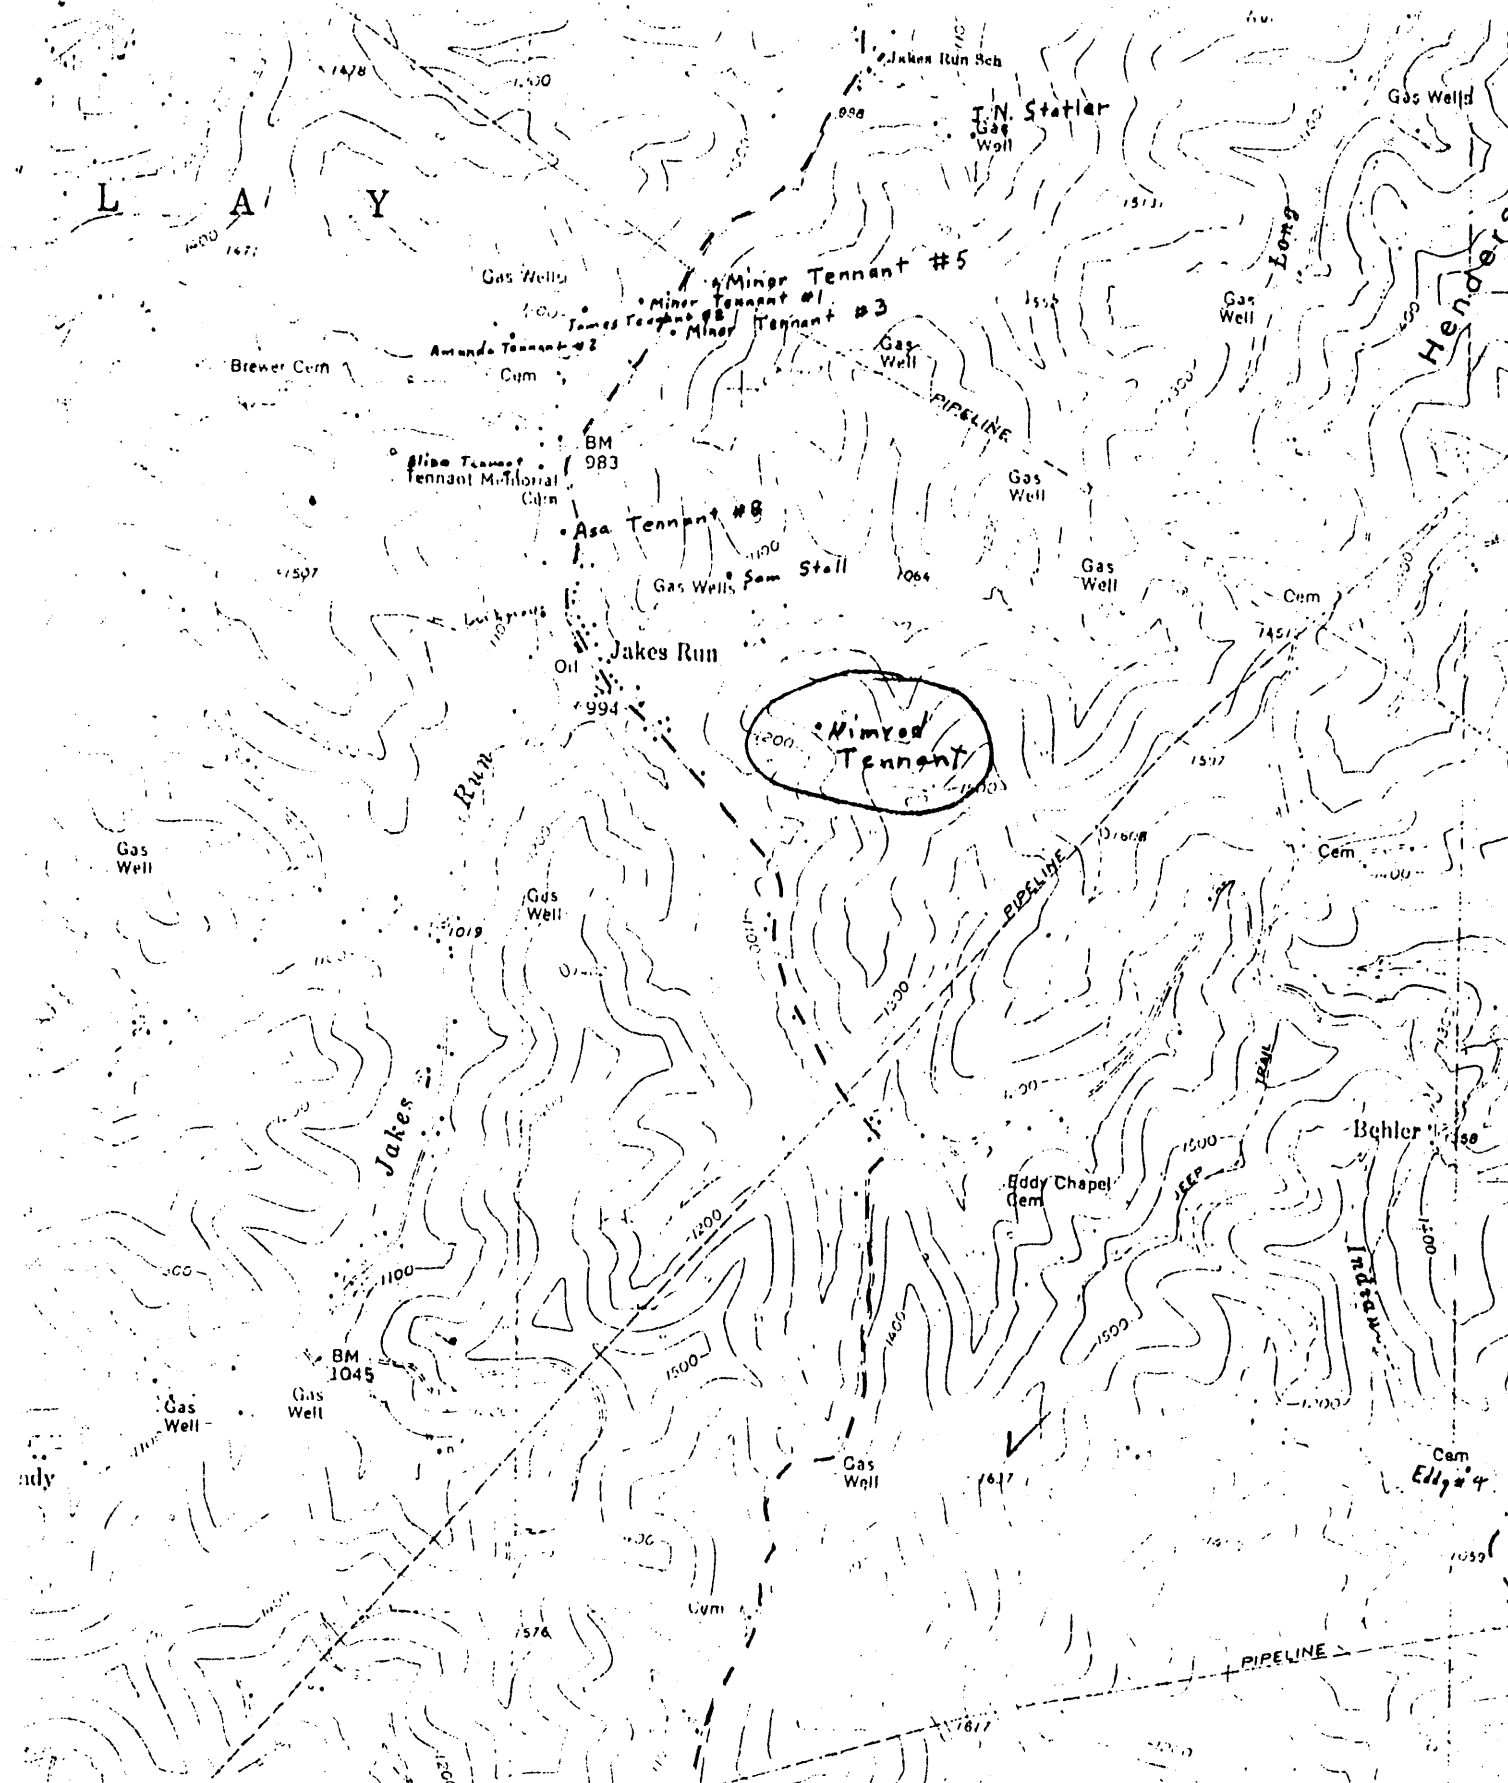

(GRANT TOWN) 170  
4963 II SW

SCALE 1:24 000

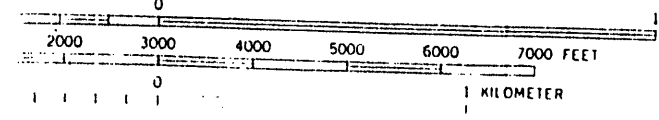

CONTOUR INTERVAL 20 FEET.  
GEODESIIC VERTICAL DATUM OF 1929

1 320 000 FEET (P.A.)

061-611

INTERIOR GEOLOGICAL SURVEY  
Geologic Map of the

ROAD CLASSIFICATION  
Heavy-duty  
Medium-duty

ST

