


ch 4/20

Card ~~Z~~ CSD

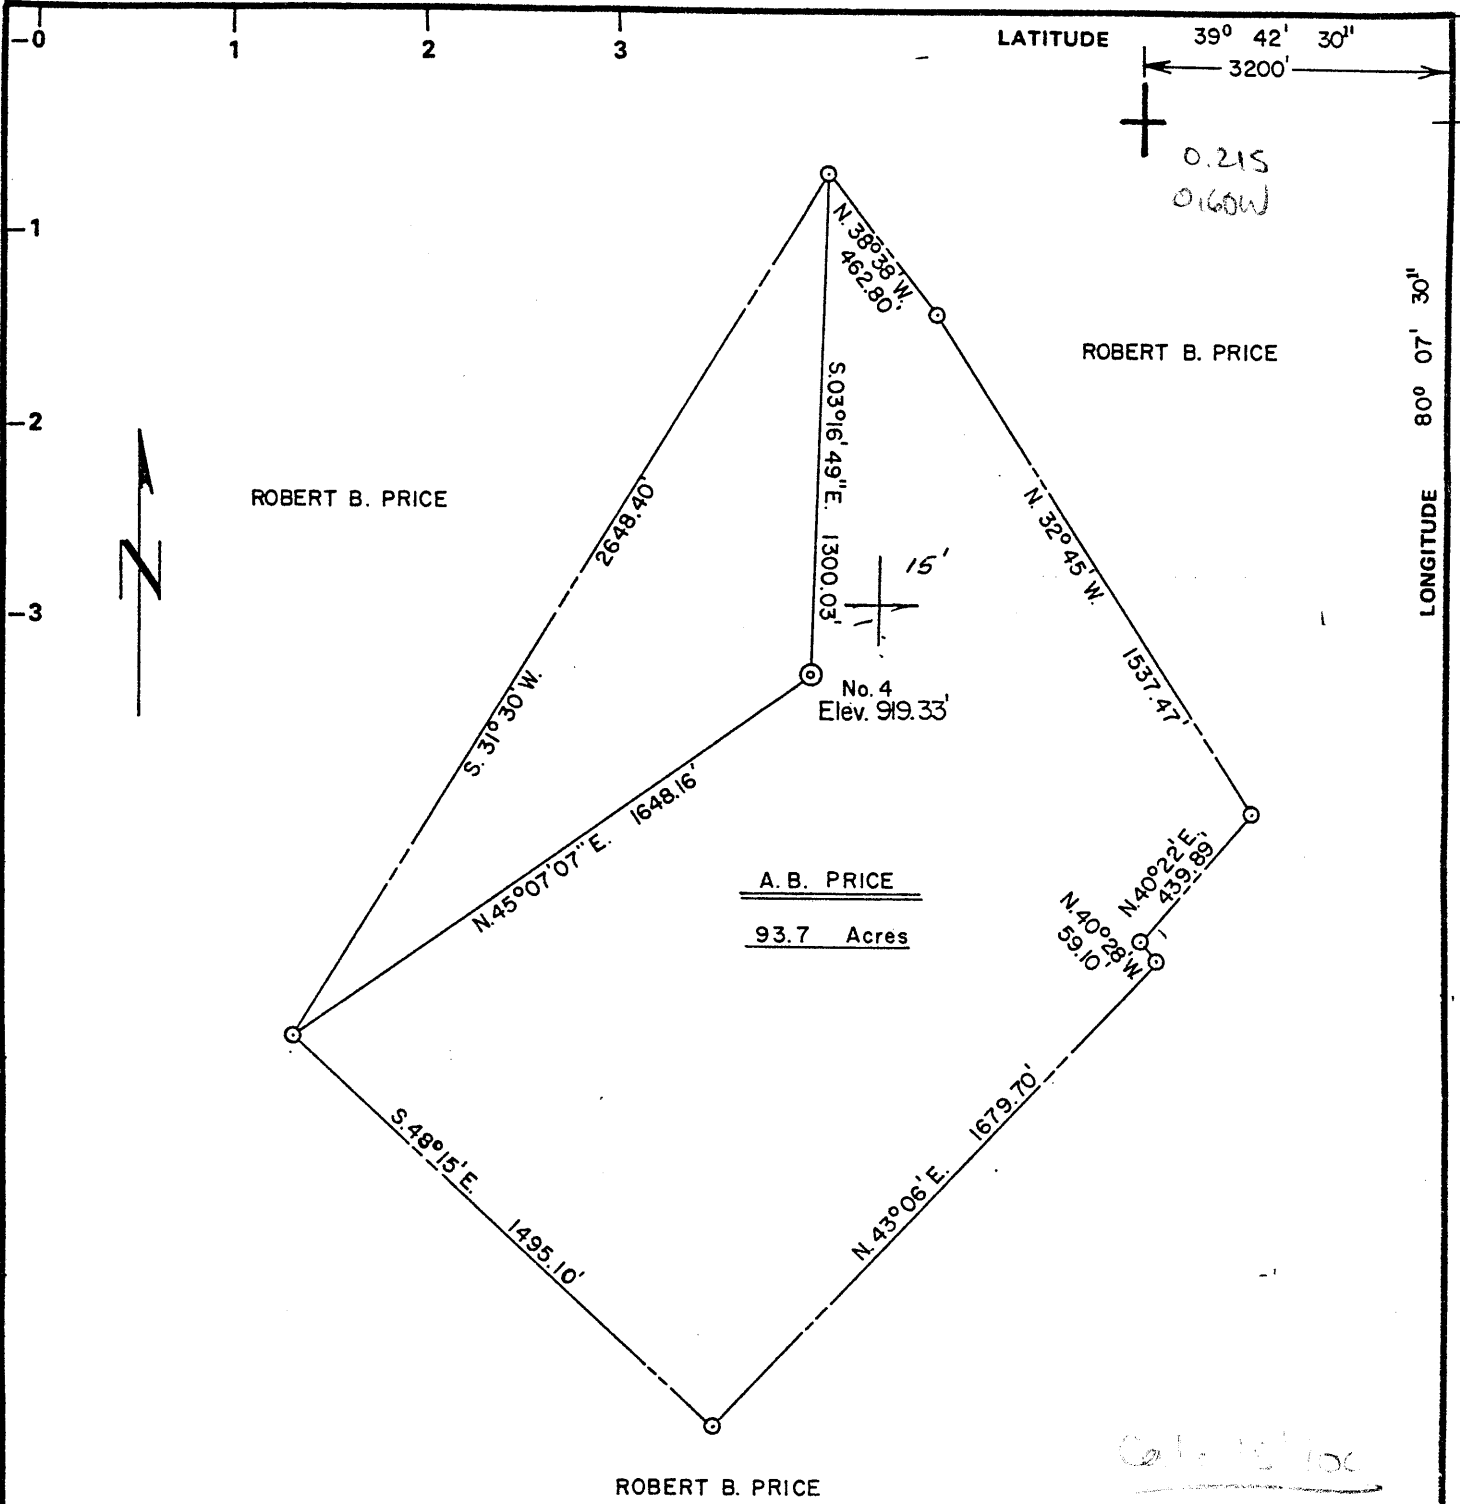

Minimum Error of Closure 1 in 200

Source of Elevation Company Survey Station Tied Into U.S.G.S. Network

- Fracture.....
- New Location....
- Drill Deeper.....
- Abandonment.....

I, the undersigned, hereby certify that this map is correct to the best of my knowledge and belief and shows all the information required by paragraph 6 of the rules and regulations of the oil and gas section of the mining laws of West Virginia.

Signed: Donald W. Bown

Map No. Squares: N S E W

Company CONSOLIDATION COAL COMPANY
 Address PO BOX 1314 MORGANTOWN, WV 26505
 Farm A. B. PRICE
 Tract Acres 93.7 Lease No. _____
 Well (Farm) No. A.B. PRICE #4 Serial No. _____
 Elevation (Spirit Level) 919.33'
 Quadrangle BLACKSVILLE 7.5 Min. 450
 County MONONGALIA District CLAY
 Engineer Donald W. Bown
 Engineer's Registration No. 2901
 File No. _____ Drawing No. _____
 Date 4-13-81 Scale 1" = 500'

STATE OF WEST VIRGINIA
 DEPARTMENT OF MINES
 OIL AND GAS DIVISION
 CHARLESTON

WELL LOCATION MAP
 FILE NO. 061-0623-P

+ Denotes location of well on United States Topographic Maps, scale 1 to 62,500, latitude and longitude lines being represented by border lines as shown.
 - Denotes one inch spaces on border line of original tracing.

MAY 26 1981

